


$$\begin{array}{r}
 17.0 \\
 18.5 \\
 \hline
 7.4 \\
 44.9
 \end{array}$$

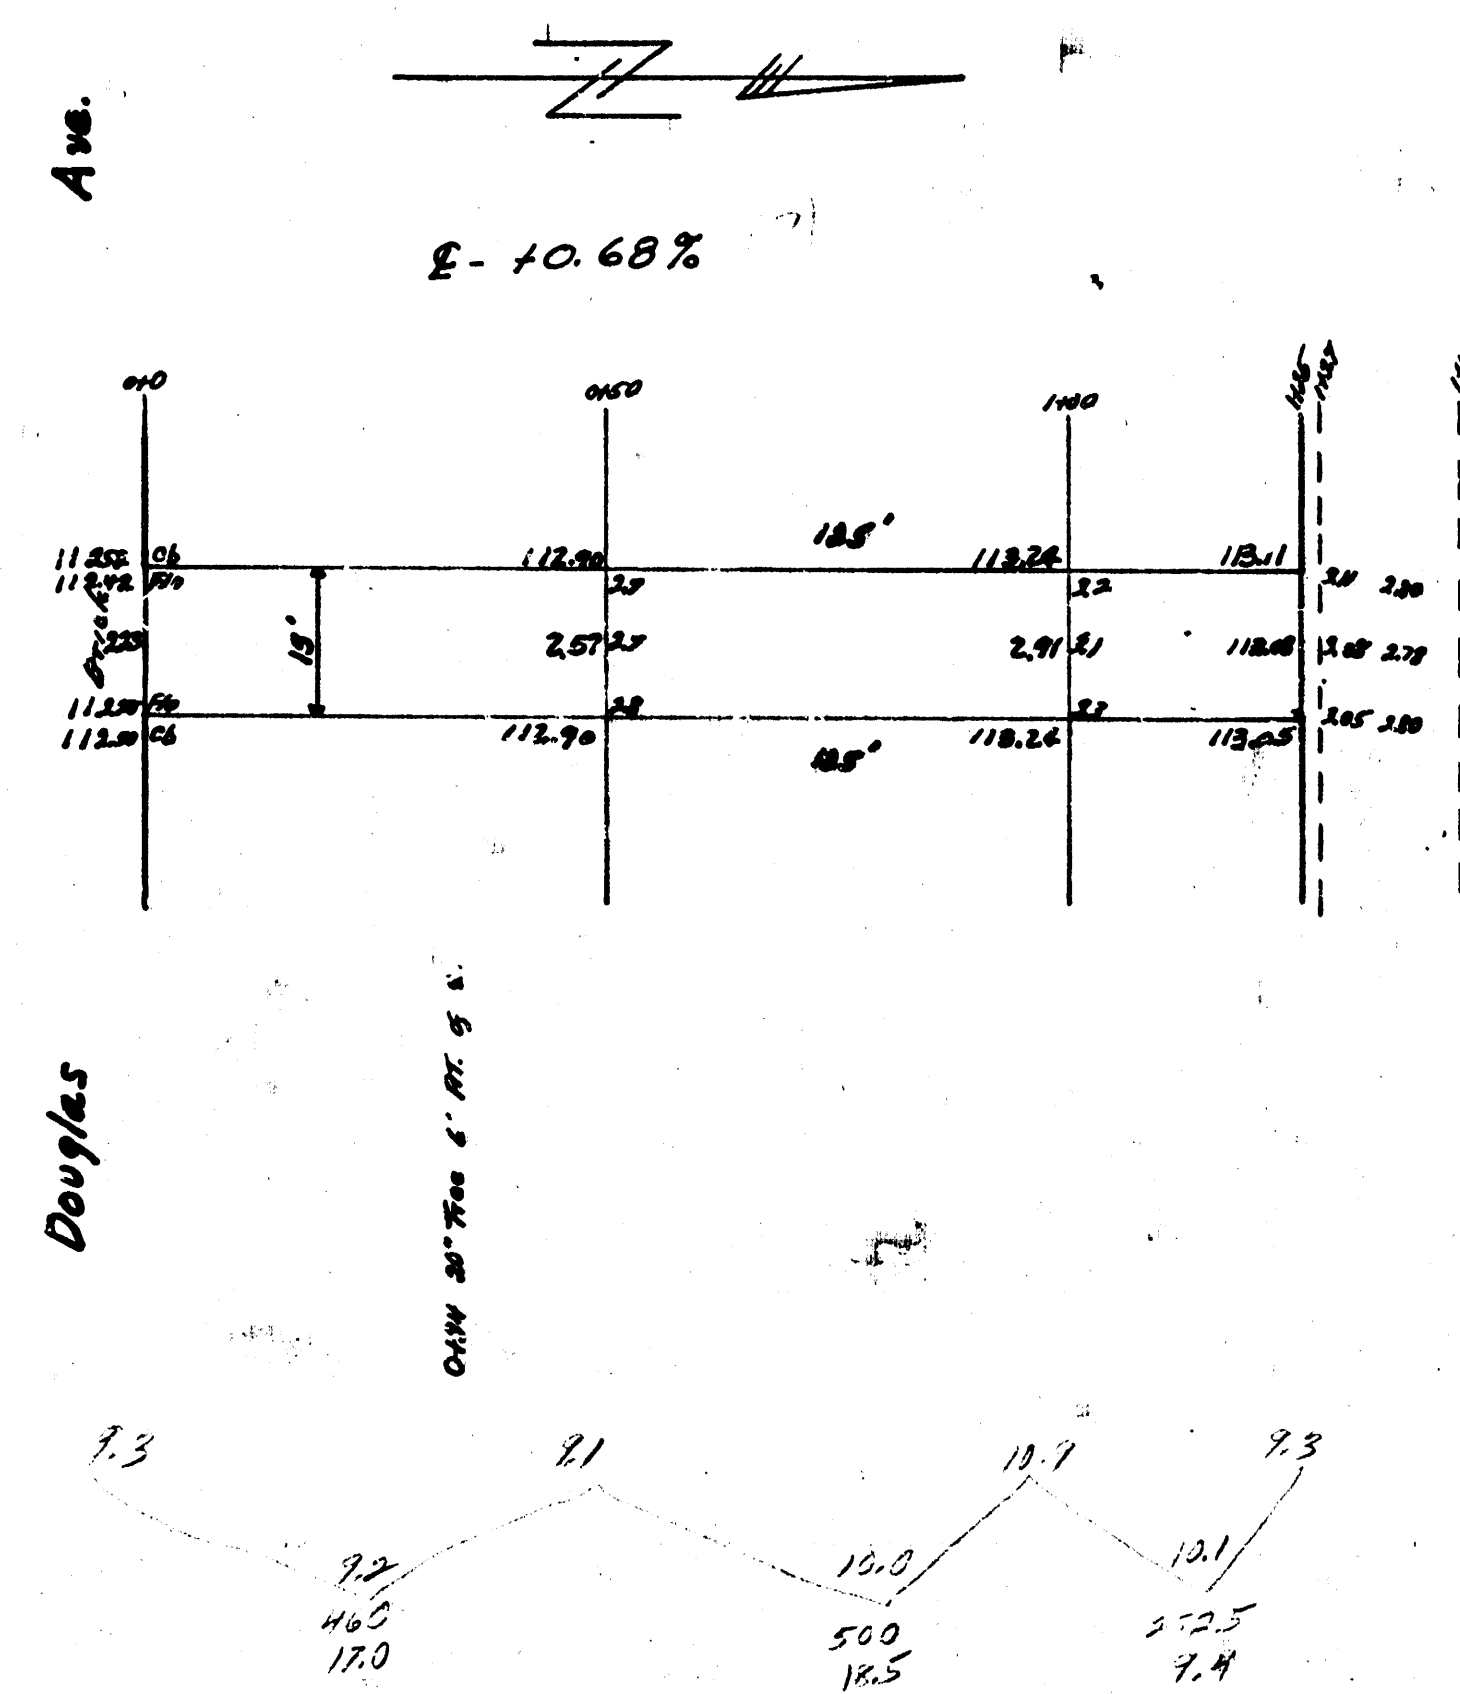

ALLEY W. of OSAGE
N.L. Douglas - S.L. Alley, N.L. Douglas
15' Conc 7"
City of Wichita Kans.
L.R. WHITE City Engineer
June 1948 Project C18-26

4	12	2	1
---	----	---	---