


B.M. 119.83 NW. Cor. brick step Ho. #602

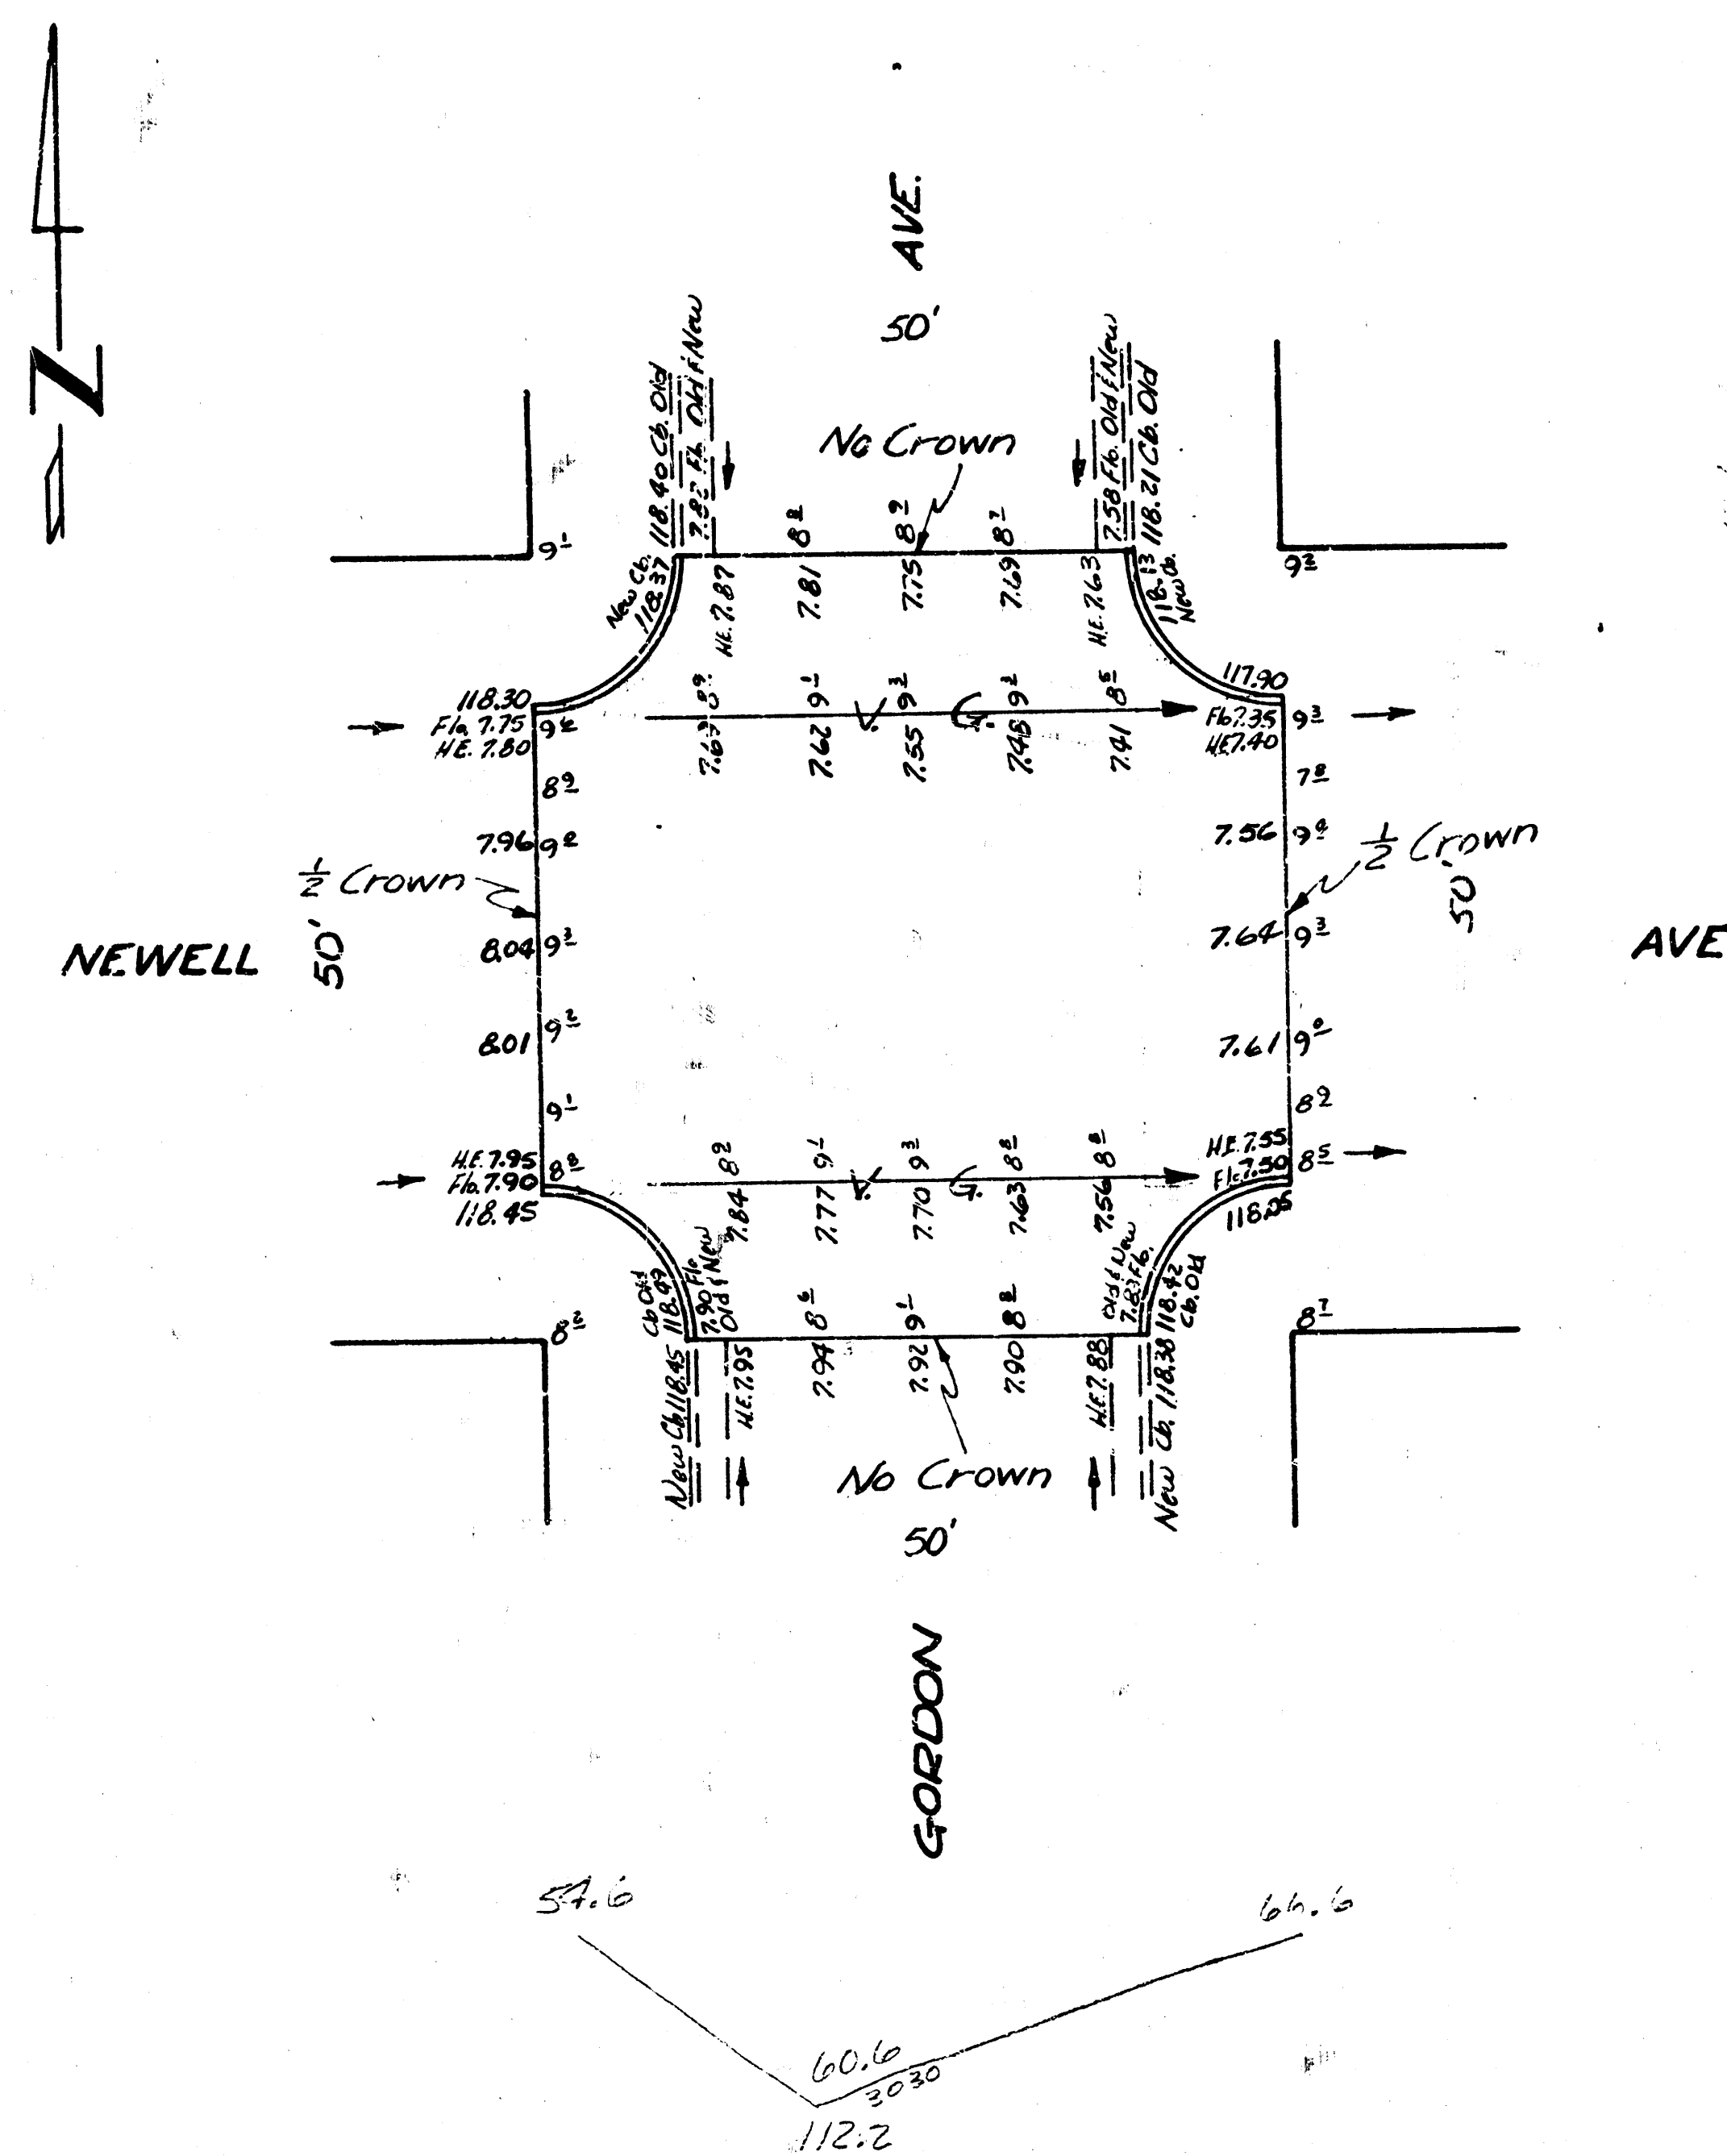


INTERSECTION
NEWELL & GORDON
6" CONC. & CB.
CITY OF WICHITA, KANS.
L.K. WHITE CITY ENGINEER
JULY 1931 PROJ. NO. CII-177

