Survey Seal Bk 5-13
Pit Sellers
Exc Sellers
Checked

BM 134.25 14" Cot Conc Pkg. Mk "S.T.P." Top of Curb
BM 130.25 1 in Factory Front Area Drain Grate Elevation

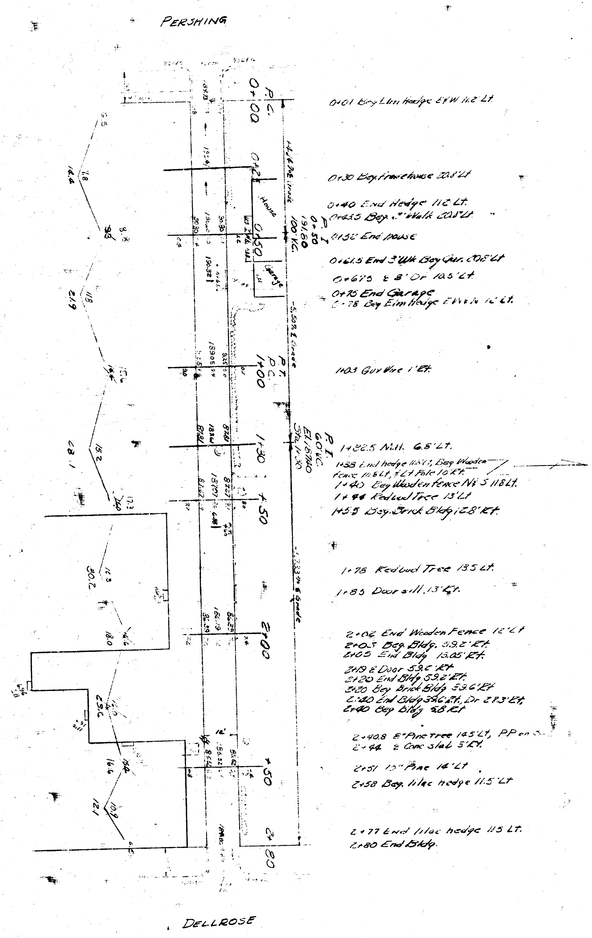

Property
Line
Area
1.59 ac. etc.

B. SMITH
REGISTERED
436
KANSAS
CIVIL ENGINEER

ALLEY N. OF CENTRAL
EL. PERSHING TO WL. DELLROSE
6" CONCRETE 12' WIDE

CITY OF WICHITA
B.E. SMITH CITY ENGINEER
ATRK 1953 REQ. C-12-35