

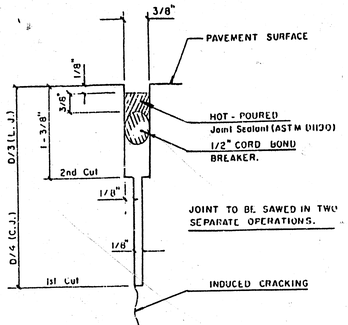



DETAIL "A"

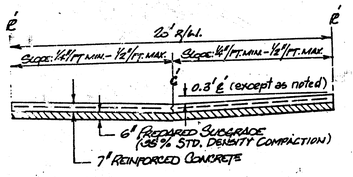


TYPICAL PAVEMENT SECTION

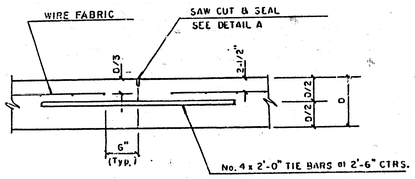

LONGITUDINAL CONSTRUCTION JOINT

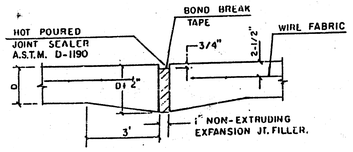


EXPANSION JOINT

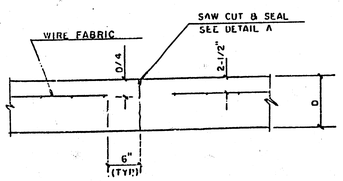


CONTRACTION JOINT


Note: Details are not to scale.

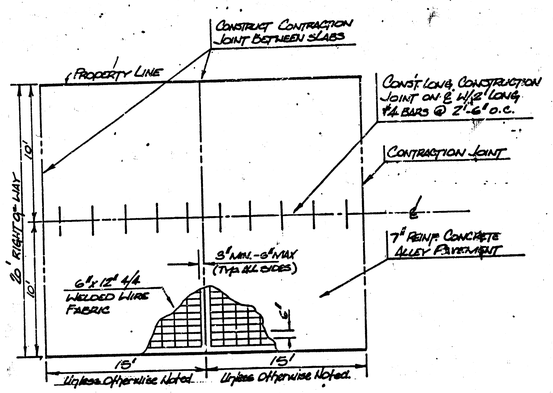

SLAB REINFORCEMENT DETAIL

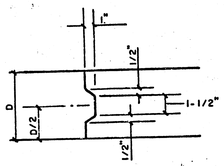


KEYWAY DETAIL

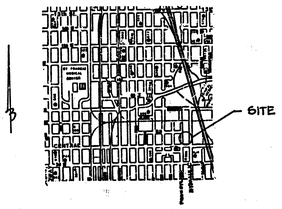

LOCATION MAP


GENERAL NOTES

1. No traffic will be carried through the project .
2. Existing utilities and their locations, as shown on the plan, represent the best information obtainable for design. The Contractor shall contact the utilities for verification of locations prior to any excavation. The Contractor shall be required to work around any utilities within the right-of-way.
3. The City of Wichita's Sewer Maintenance Division has televised sewers within the limits of the project and has found no defects requiring repair. The Division shall be notified and afforded the opportunity to re-televise sewer lines after subgrade work has been completed and prior to pavement construction, to determine if such sewer lines have been damaged by the Contractor's operations. Damaged sewers will be repaired by the Contractor, as directed by the Engineer, at the Contractor's expense. Television logs are available for inspection by the Contractor during normal office hours at the Sewer Maintenance Division office at City Hall.
4. All work on this project shall be performed in accordance with the City of Wichita Standard Specifications for Concrete Pavement.
5. The Contractor shall give all property owners and/or tenants abutting the project a minimum of 48 hours notice prior to start of construction.

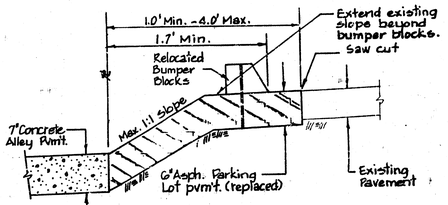


PARKING LOT REPL. DETAIL

BENCH MARK:
"D" on S.W. cor. of walk section in drive @ sta. 1+70.5, 28.0' Lt. of ℄.
Elev. 112.84

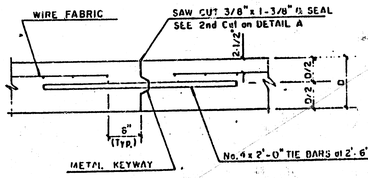

OPTIONAL L.J.

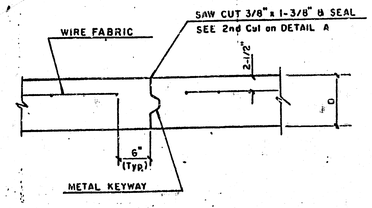

OPTIONAL C.J.

NOTE TO CONTRACTOR

INSPECTION AND TESTING FOR THIS PROJECT IS TO BE PROVIDED BY A LICENSED CONSULTING [illegible] UNDER CONTRACT WITH THE OWNER. [illegible] PLACED IN THE RIGHT-OF-WAY WITHOUT WRITTEN AUTHORIZATION FROM THE CITY ENGINEER.

APPROVED AS NOTED
By CITY ENGINEER OF WICHITA

Sanitary Sewers _____
Storm Sewers _____
Driveway Approaches _____
Water Mains _____
Paving VRH 1/13/89

THOMAS CHARLES HIGGINS
LICENSED
9621
KANSAS
PROFESSIONAL ENGINEER

Rev. as built 4-7-89 TCR
Rev. parking lot removal / repl. 1-16-89

ALLEY N. OF CENTRAL
FROM 126' W. OF HYDRAULIC TO W.L. HYDR.
PROJ. NO. 472-76-245-80001-000-000-049
INDEX NO.

BAUGHMAN COMPANY P. A.
SURVEYING & ENGINEERING
316/262-7271 • 315 ELLIS • WICHITA, KANSAS 67211

DESIGN	DRAWN	APPROVED	DATE	SCALE	SHEET
TCR	TCR		1-12-89	1"=20'	1 OF 1 1/1

FILMED FROM THE BEST AVAILABLE COPY