
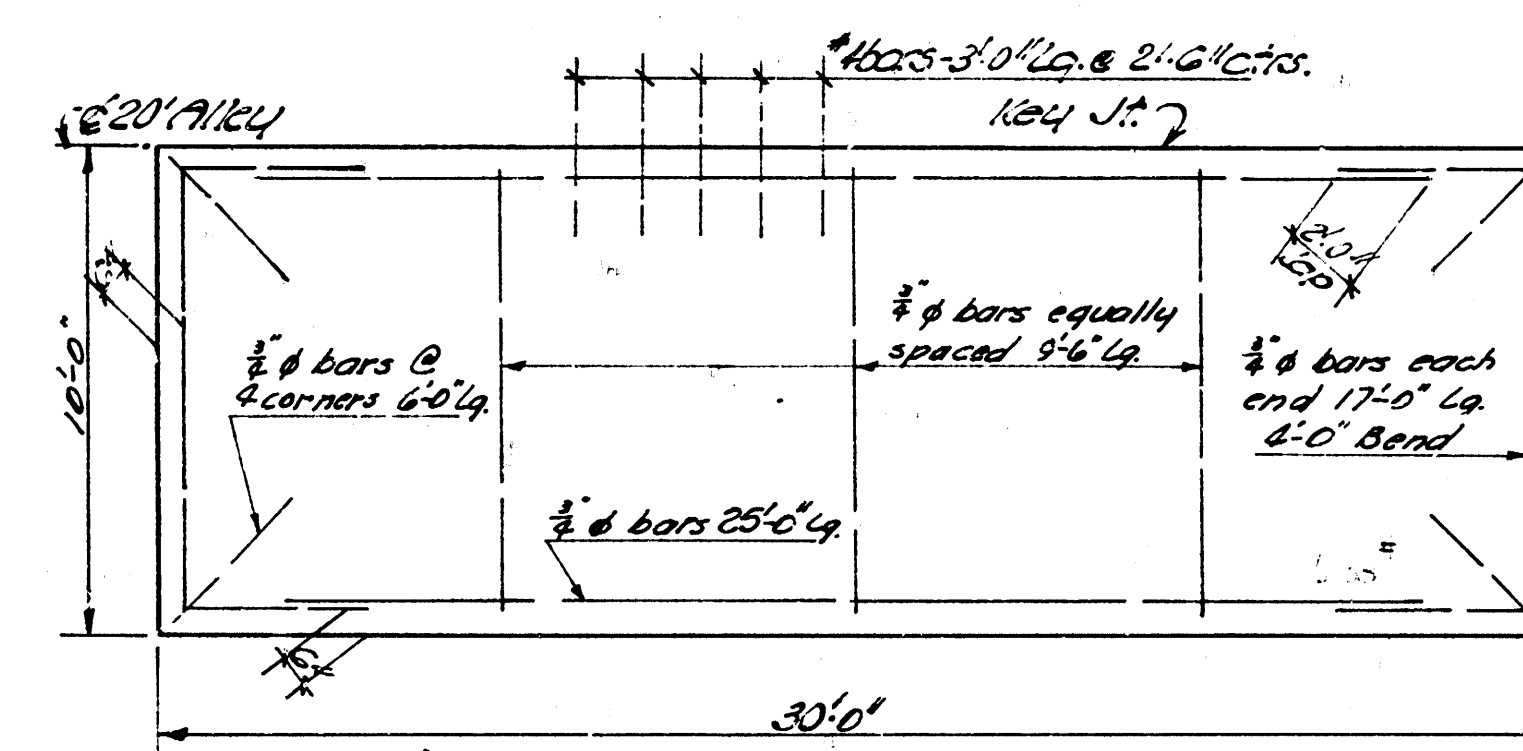
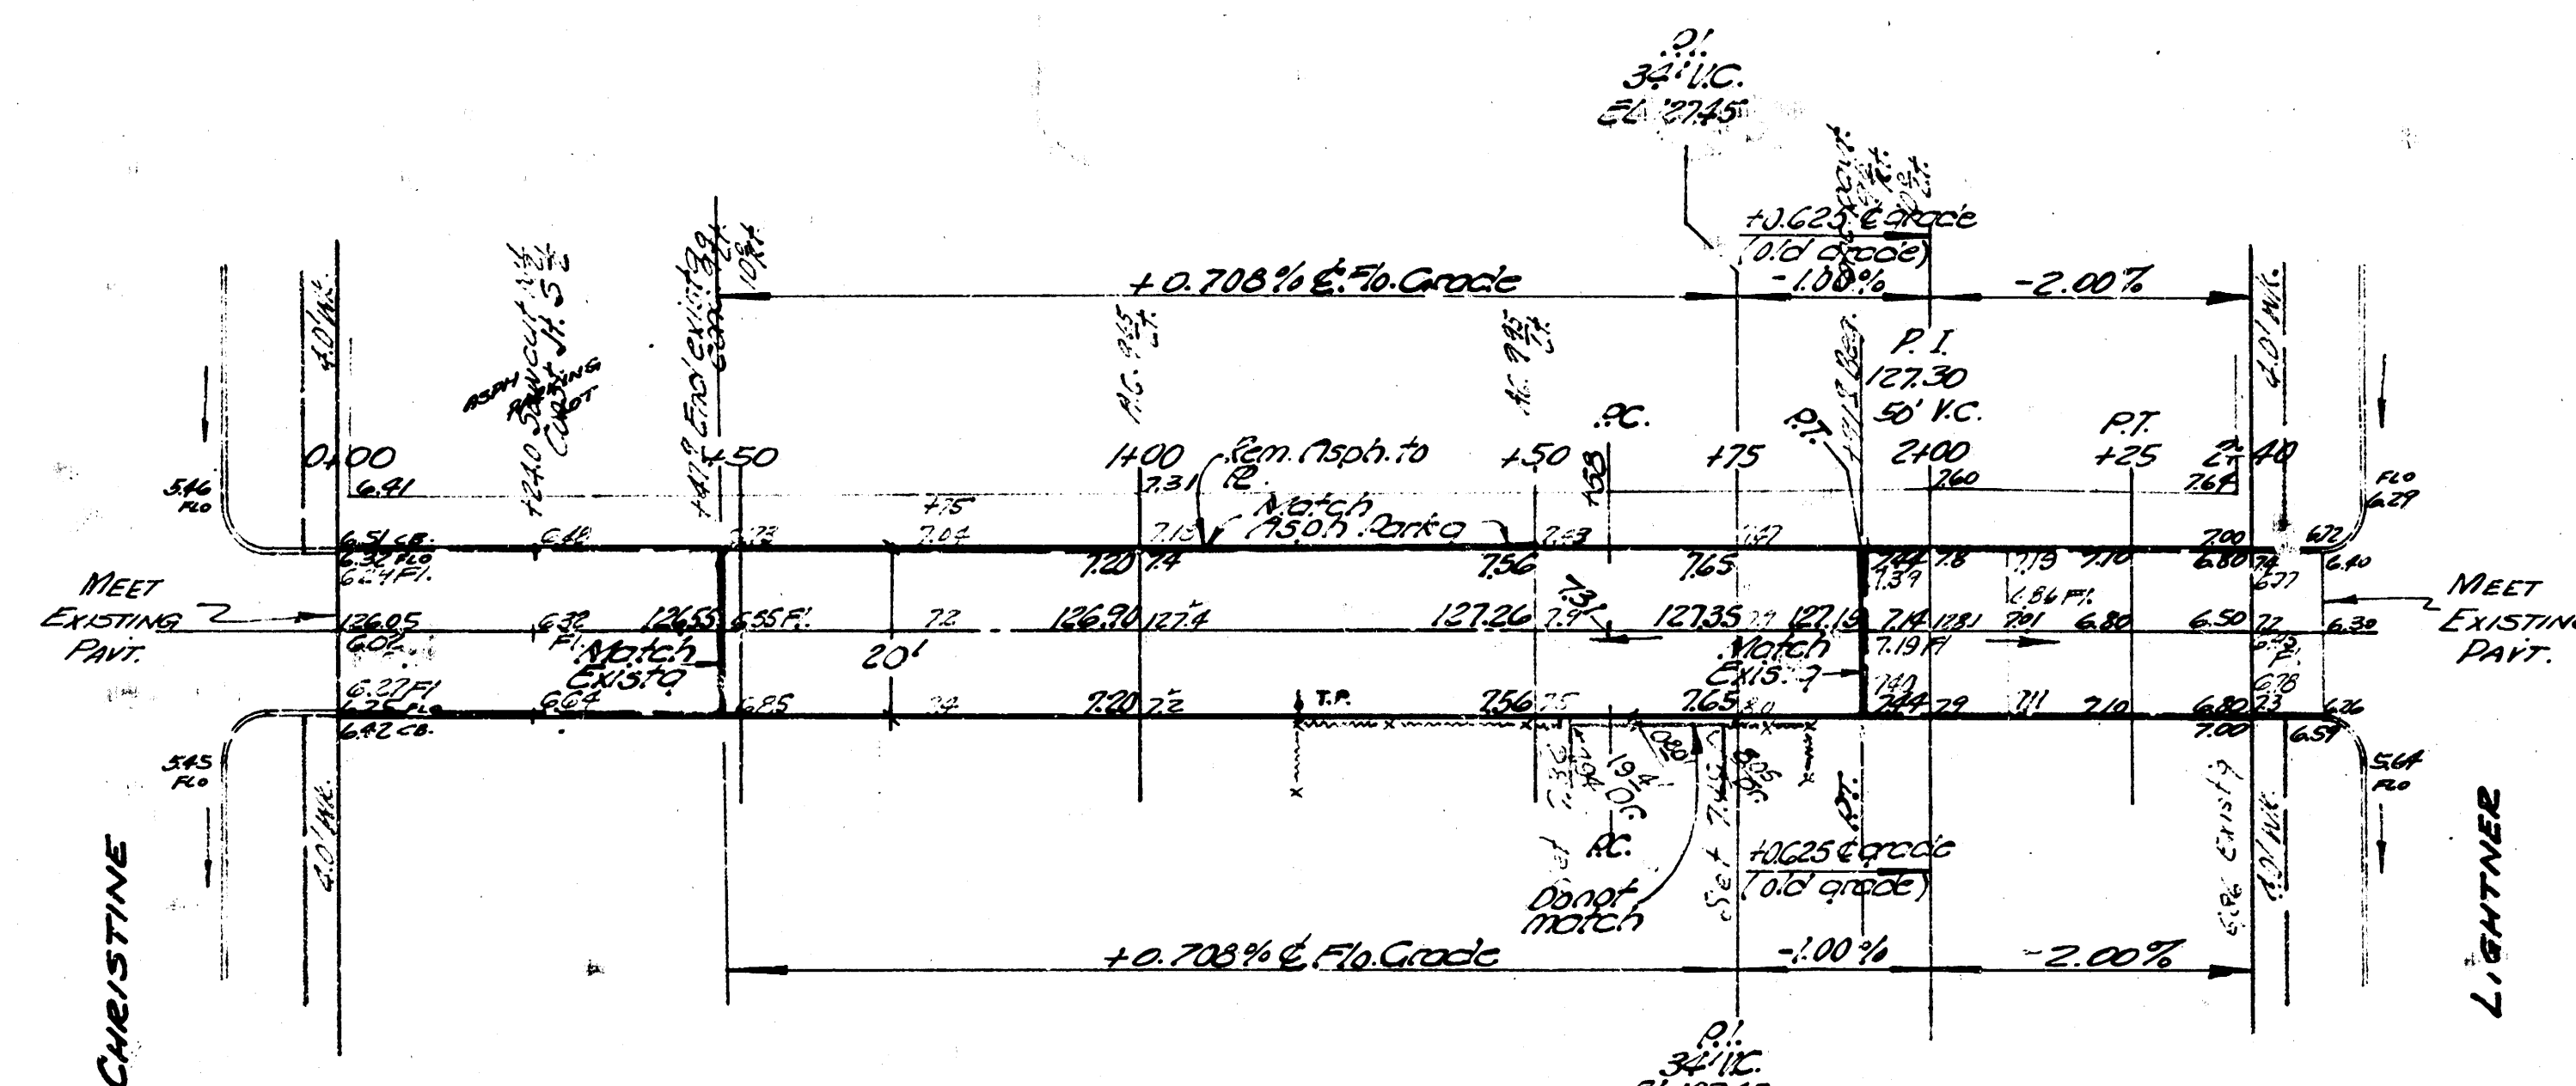


B.M. 167.26 'M' IN MUELLER F.P. N.W. COR. CORNE OF LIGHTNER

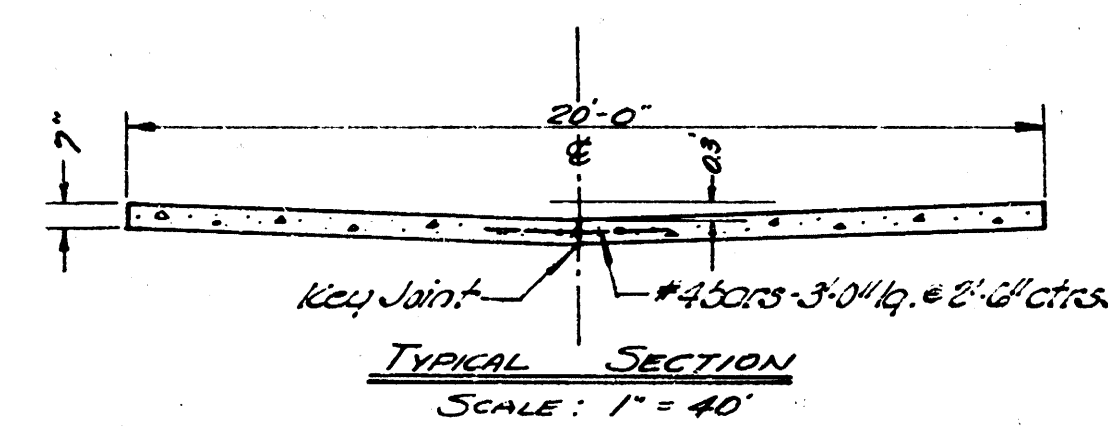

Steel Pattern
No Scale

Revised 7-19-68
"ALLEY BET. KELLOGG & ORME"
Title of E.L. Christine to 1913 E. of
E.L. Christine.
20' - 7" Conc.
City of Wichita, Kansas
B.E. Smith City Engineer
Date: JULY 1968, Proj. No. C-13-73

ALLEY BETWEEN KELLOGG & ORME
E.L. CHRISTINE TO W.L. LIGHTNER
20' - 7" CONC.
CITY OF WICHITA, KANSAS
B.E. SMITH - CITY ENGINEER
SEPT., 1954 PRIVATE JOB



EARTHWORK QUANTITIES
Excavation
86.6 CY
36.04 (40%)
94.2 CY