
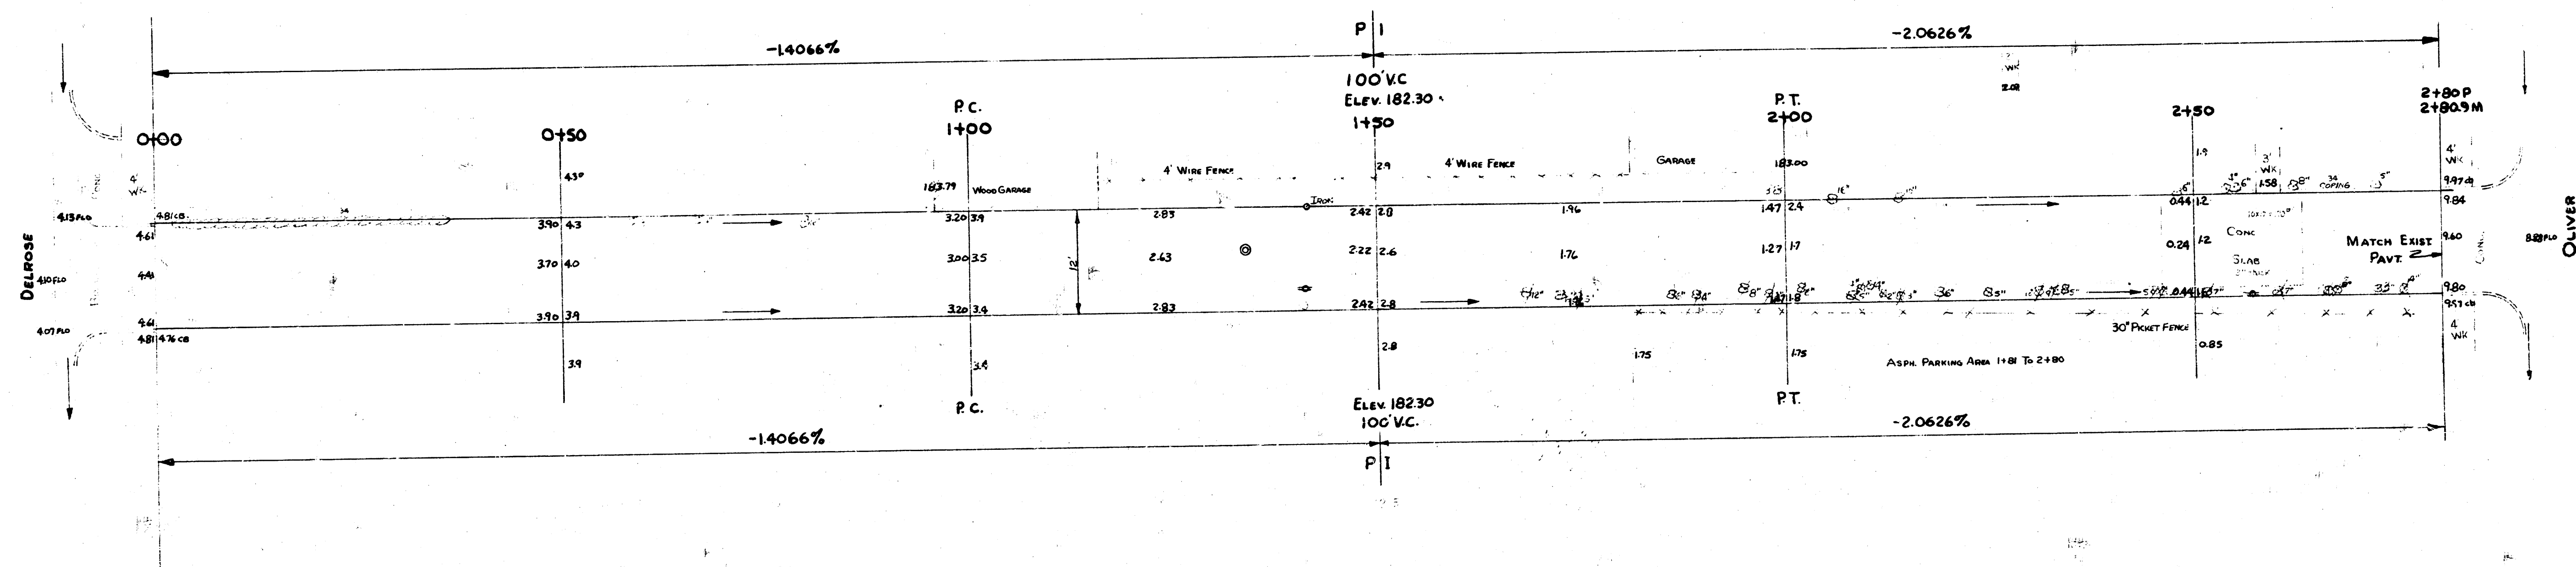
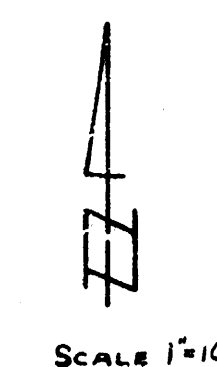
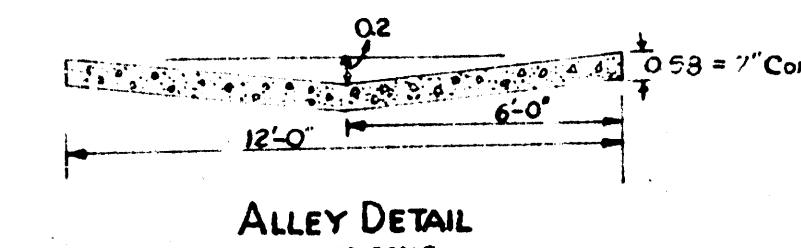


STATION 6 W TO E.
 B.M. 17750 STAND. SE OLIVER & CENTRAL.
 B.M. 17755 13' W. GLOBE & W. N. S. OF ALLEY N. OF CENTRAL. WS OLIVER.
 B.M. 15516 7' E. N. ELTING AT YK N. WS DELLORE, N. S. OF ALLEY N. OF CENTRAL.

NOTE TO FIELD ENGINEER
 MEASURE UP REMOVAL AT DELLORE.
 COUNT TREES AND TURN IN.

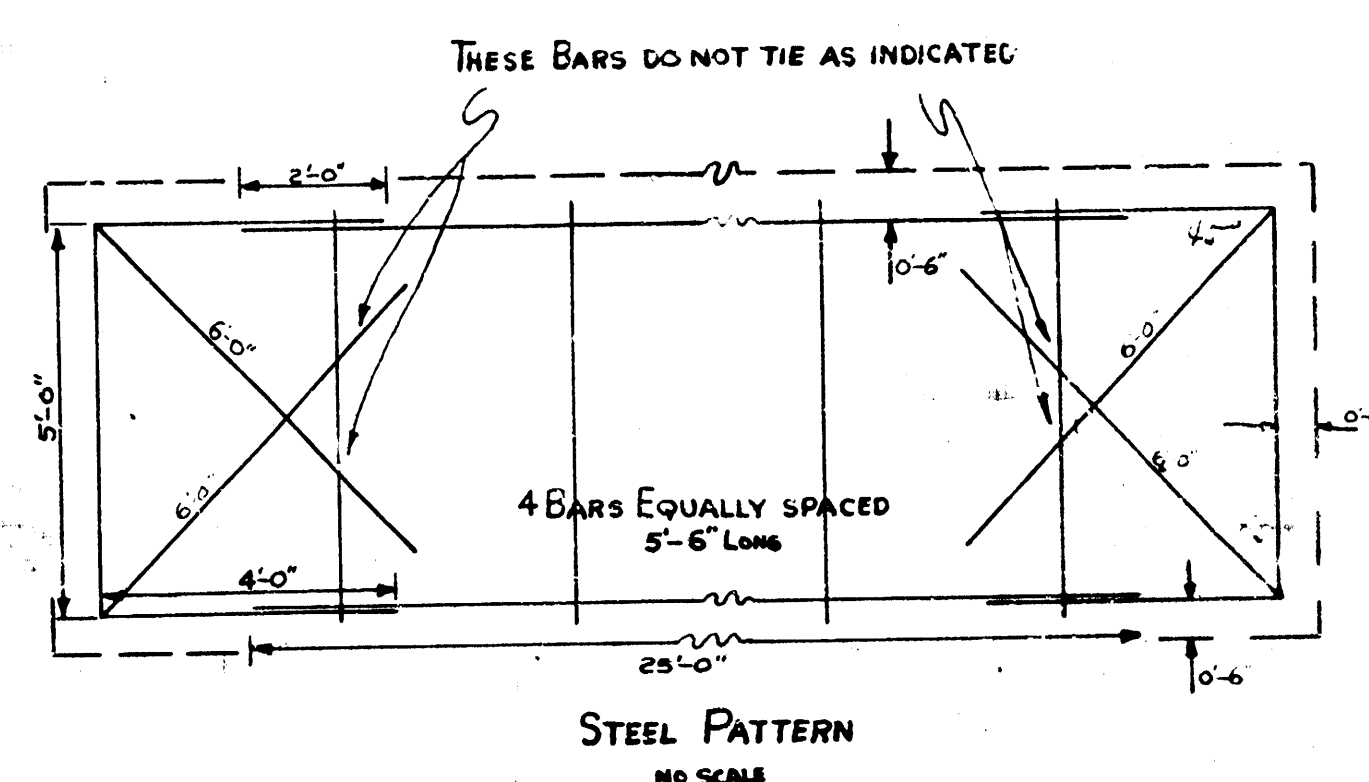

ALLEY N. OF CENTRAL
 EL. DELLORE TO W.L. OLIVER
 7" CONC. 12'
 CITY OF WICHITA, KANSAS
 B.E. SMITH CITY ENGINEER
 OCT. 1954 PROJ. NO. C14-232