
B.M. 124.23 "A" in Hurst Ctr. of Wk. West SW cor. Park Place & 21st.

SCALE 1"=20'

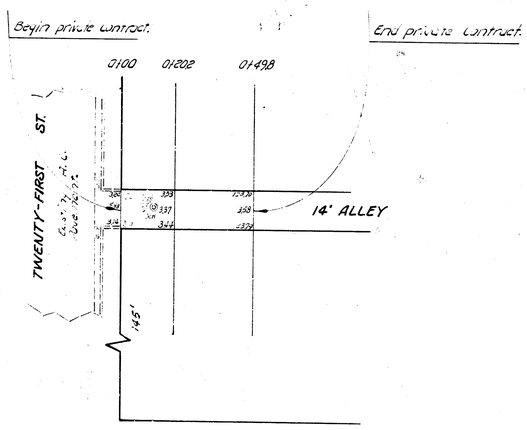

B.M. 124.13

ALLEY
BETW. WELLINGTON PL & PARK PL.
N.L 21ST. ST. TO 49.8' N. OF N.L 21ST. ST.
14' CONC.-6"
CITY OF WICHITA, KANSAS
B. E. SMITH CITY ENGINEER
OCT. 1957, PRIVATE CONTRACT