

B.M. 13.73 'G' in Goose E. cb Jeannette NL 13TH ST.
B.M. 12.91 W. cor. NW Wing 13th St. bridge (Minisq)
Starting ℄ base line on ℄ alley from Sta 0+00 to 1+50.

SCALE 1" = 10'

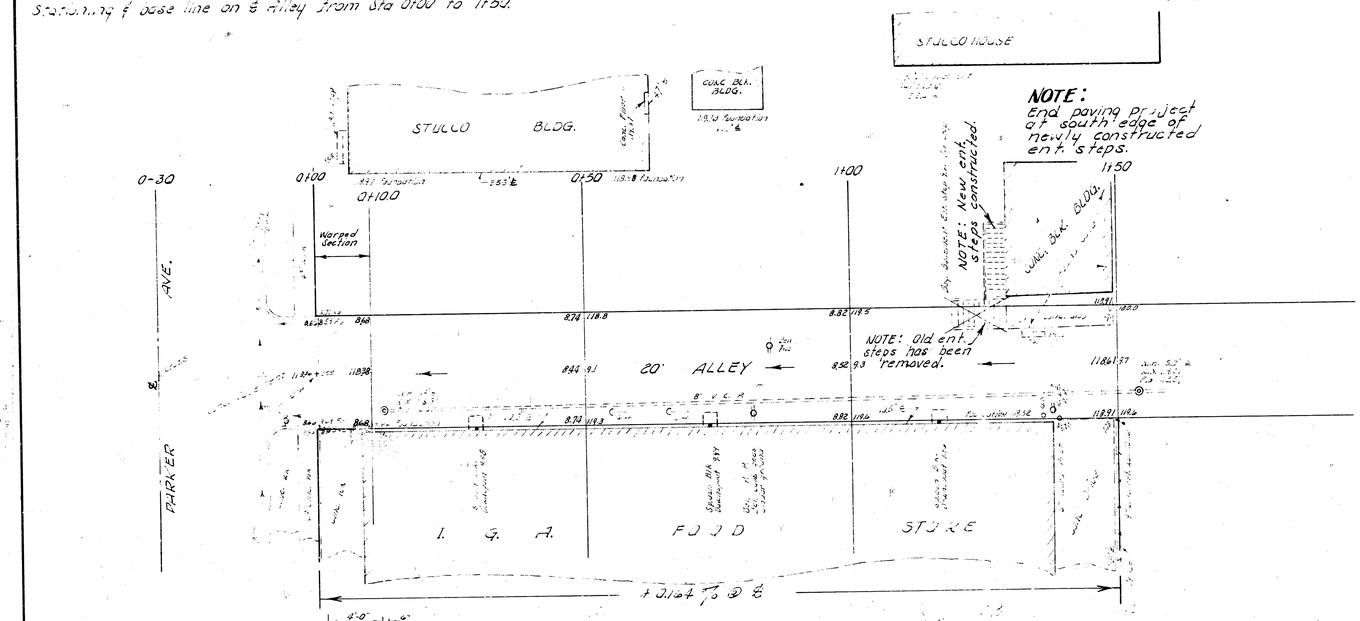


ESTIMATED QUANTITIES *	
* 277.8	Sq. Yd. 6" Conc.
1875.0	lbs. Reinf. Steel
101.4	Cu. Yd Excavation
125.0	Lin. ft. of Mastic Joint
1.93	Cu. Yds Conc.
1.93	Cu. Yds. Special Excav.


*NOTE: Quantities estimated for 125 Lin. ft. of pavement.

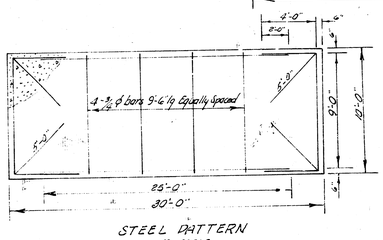

STEEL PATTERN
NO SCALE

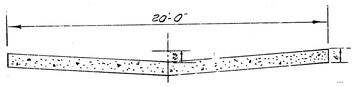

TYPICAL SECTION
EXCEPTION AT WARPED SECTIONS
NO SCALE

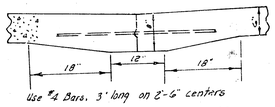

Use #4 Bars, 3' long on 2'-6" centers
DETAIL OF MASTIC JOINT

ALLEY
BETW. WOODLAND AVE. & JEANNETTE AVE.
NL PARKER AVE. TO 125' N. OF NL PARKER AVE.
20' CONC. - 6"
CITY OF WICHITA, KANSAS
B. E. SMITH - CITY ENGINEER
JAN. 1959, PRIVATE CONTRACT