
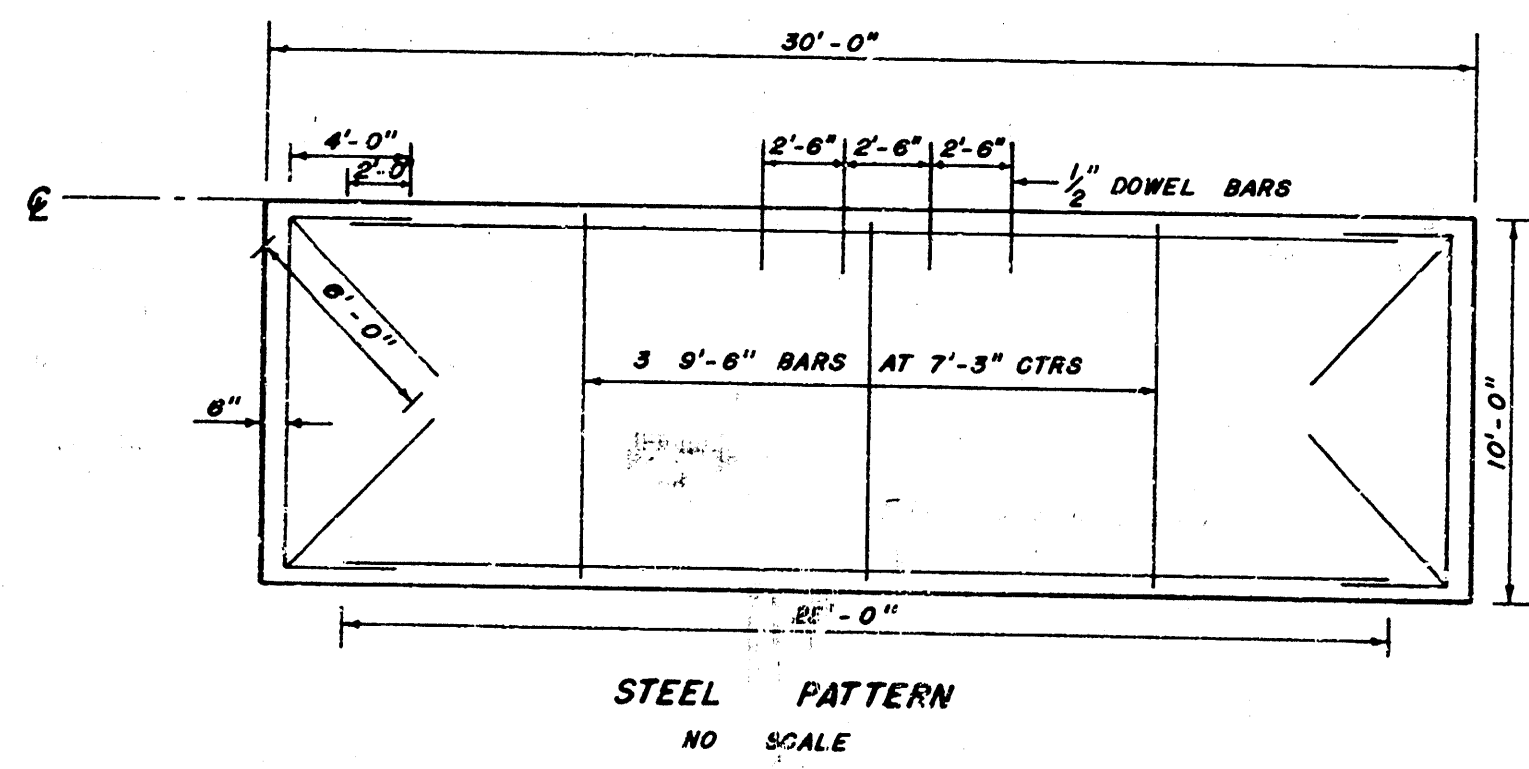
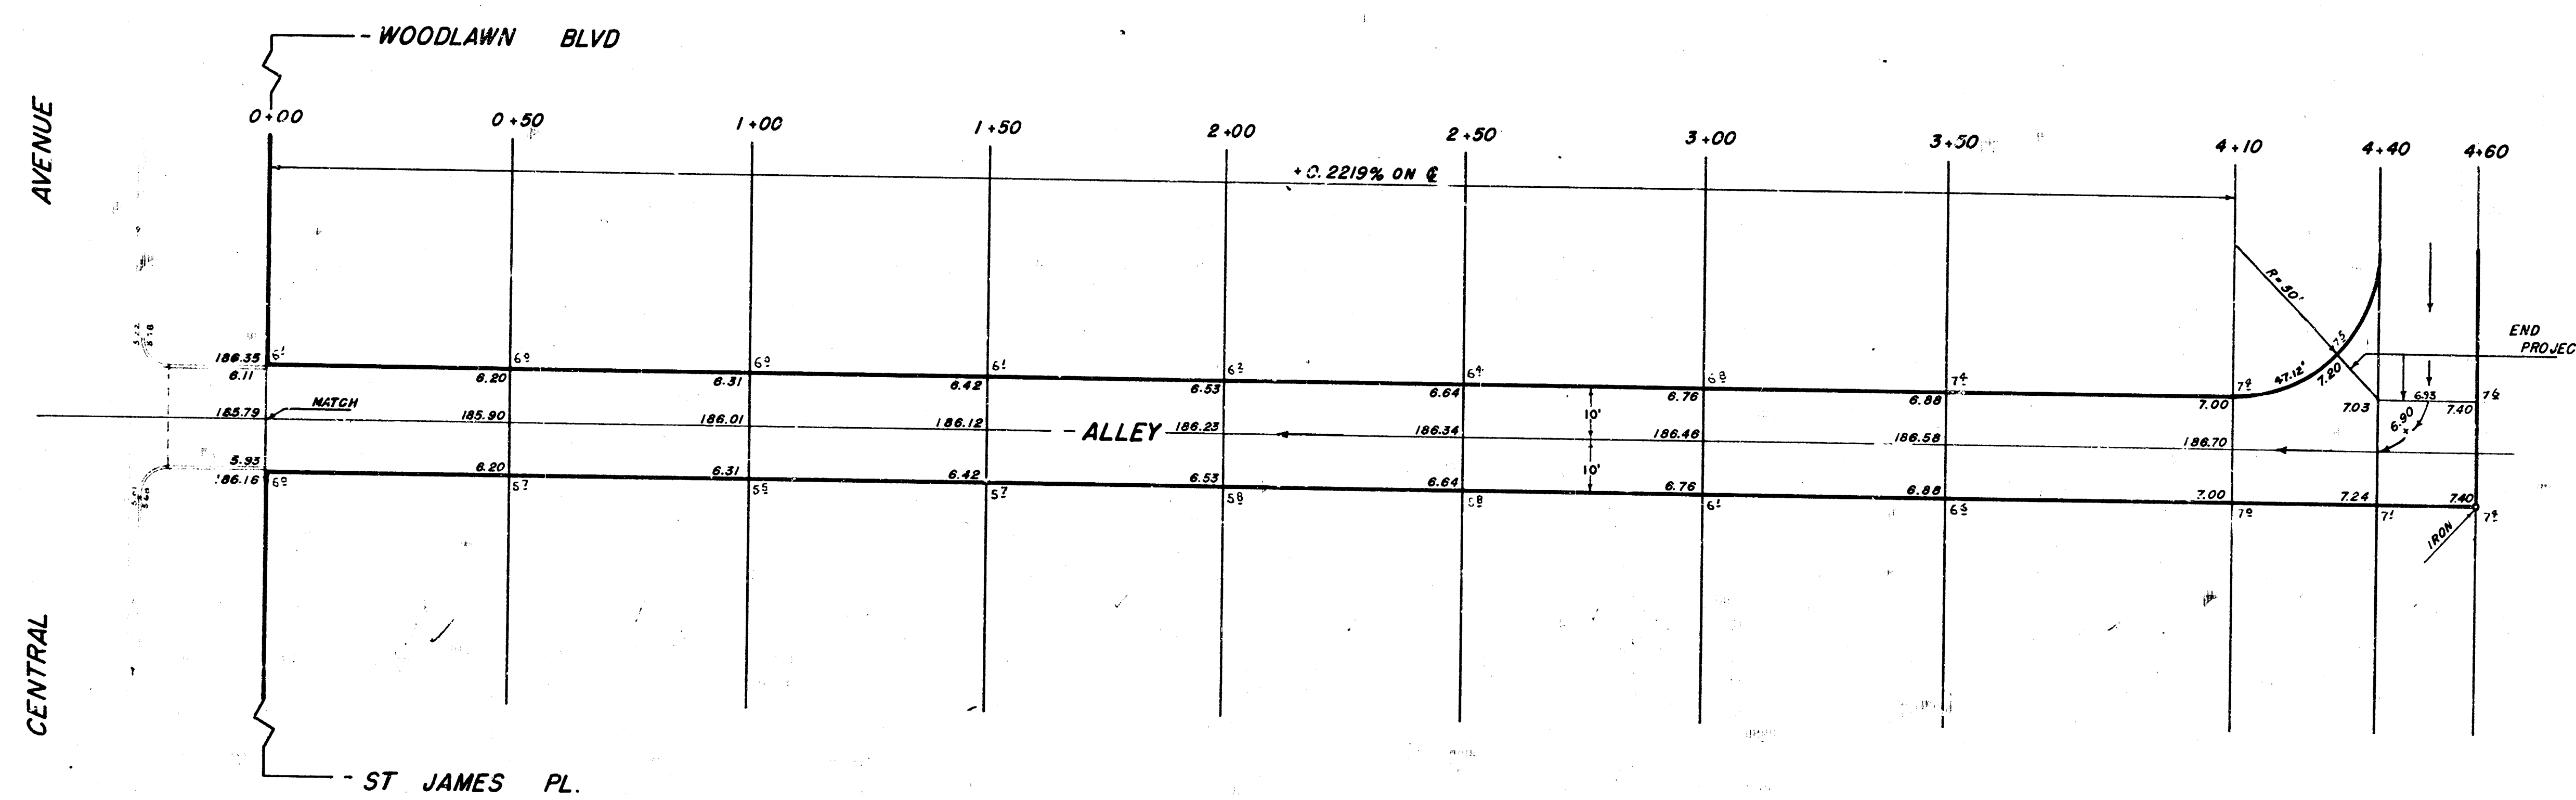



BM+192.15 STANDARD N.W. COR WOODLAWN & CENTRAL
 BM+194.12 "E" IN RITCHIE, W. CURB, ST JAMES & N.L. CENTRAL.
 B.M.+195.86 R.R. SPIKE N. SIDE P. POLE ON N. SIDE CENTRAL 40' EAST
 OF ALLEY, BET WOODLAWN & ST JAMES.

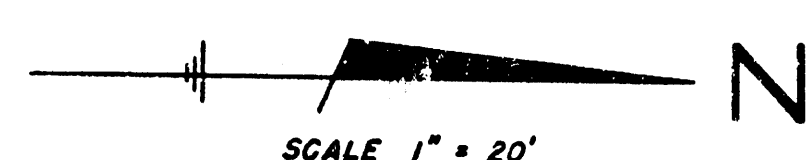

NOTE:
 ALL REINF STEEL TO
 BE 3/8" Ø BARS - EXCEPT
 DOWEL BARS.

EXCAVATION
 162.4 CU YARDS
 10% 16.2 " "
 TOTAL 178.6 CU YARDS

COMP FILL
 3.3 CU YARDS
 10% 0.3 " "
 3.6 CU YARDS

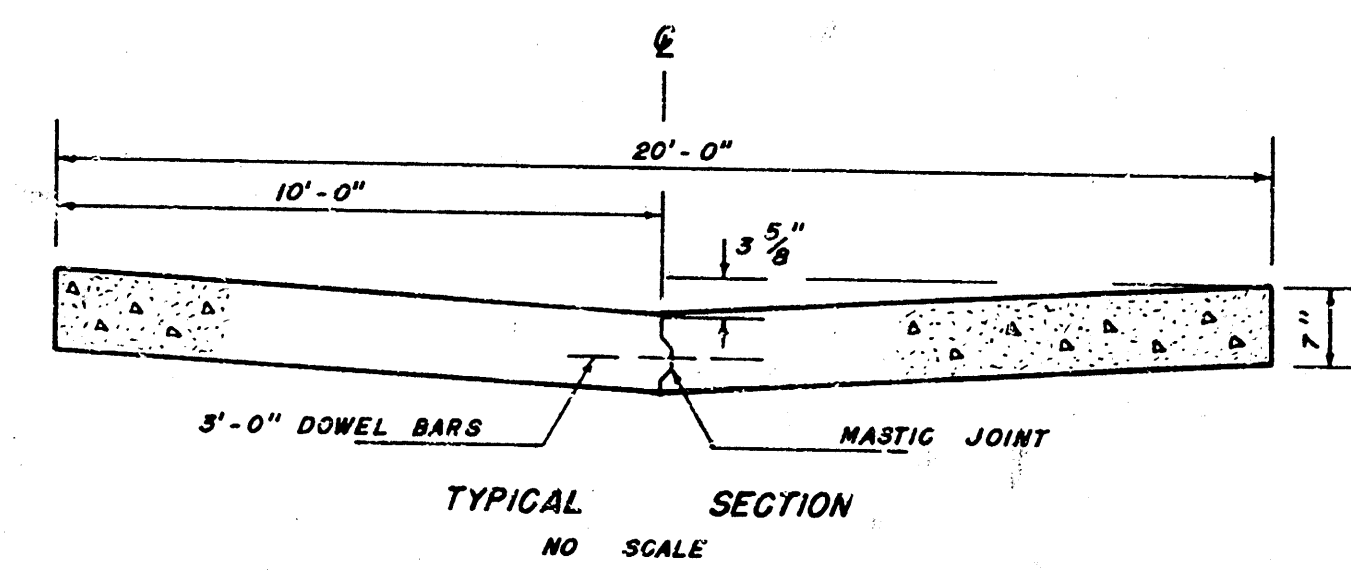

LIST OF QUANTITIES			FINAL
1030.0	SQ YDS	PAVEMENT	1,040.35
178.6	CU YDS	EXCAVATION	162.50
3.6	CU YDS	COMP FILL	3.30
460.0	LIN FEET	MASTIC	863.04
6705.0	LBS	REIN STEEL	6,930.45

ALLEY E. OF WOODLAWN
 N.L. CENTRAL TO N.L. ALLEY N. OF CENTRAL.

20' - 7" CONC-PAVEMENT

B.E. SMITH CITY ENGINEER
 CITY OF WICHITA, KANSAS
 DATE: 4/11/65 PRIVATE PROJECT