




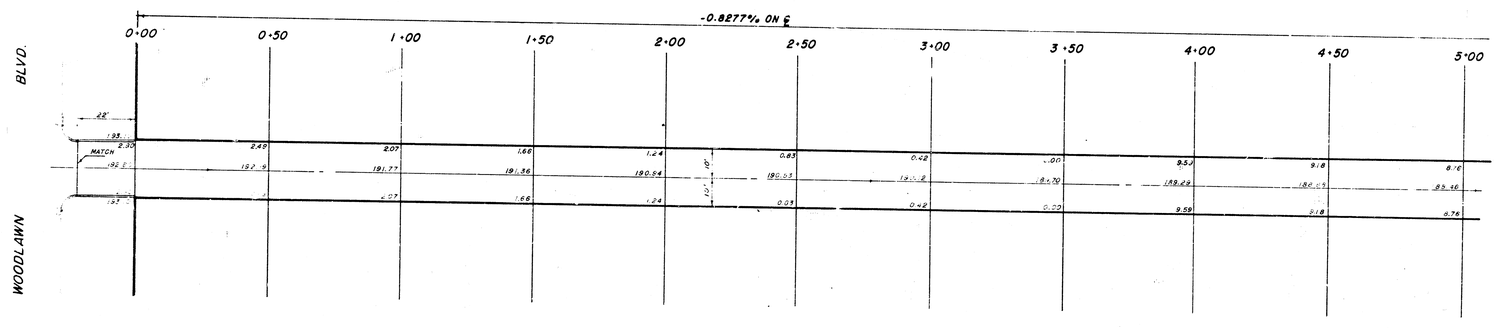

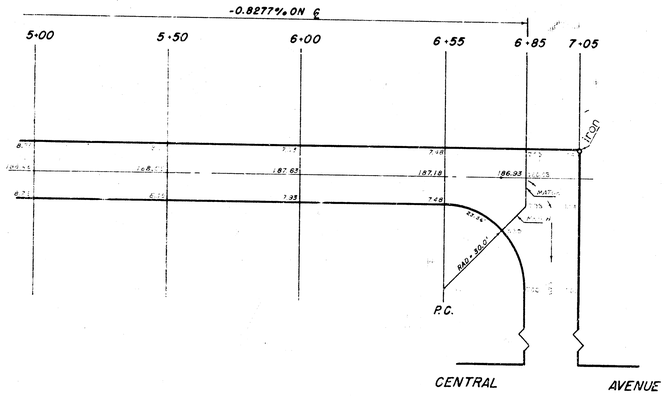


| LIST OF QUANTITIES | | FINAL |
|---|---|---|
| 1,555 | Sq. yds pavement | 1,586.6 S.Y. |
| 685 | Lin. feet mastic | 707.0 L.F. |
| 10,300 | Lbs. rein steel | 10,395 Lbs. |
| NOTE: | Fied Eng to cross section prior to construction for earthwork quantities. | |
| 44 | Lin. feet int. curb | 43.8 L.F. |

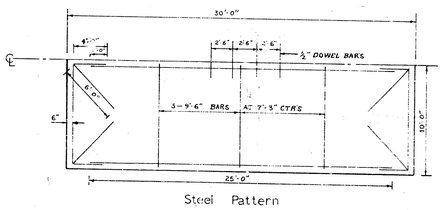


Steel Pattern
no scale

NOTE:
ALL REINF. STEEL TO BE ⅝" ℄ BARS EXCEPT ¾" DOWEL BARS

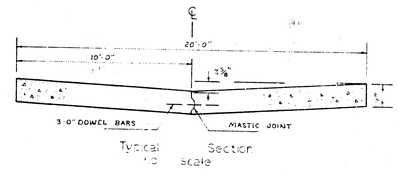


Typical Section
no scale

**ALLEY NORTH OF CENTRAL**
East Line Woodlawn Blvd. to East Line Alley East of Woodlawn Blvd.
**20'-7" CONC - PAVEMENT**
B.E. SMITH City Engineer
CITY OF Wichita, Kansas
DATE: _____ Private Project