


CHN 83
P.S.
D.S.

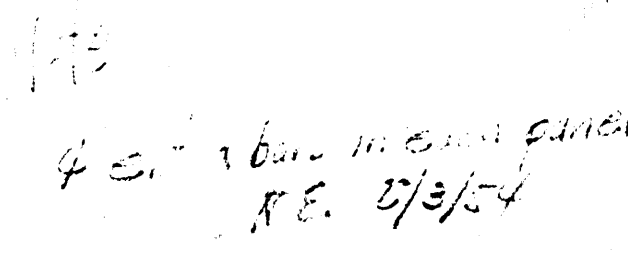

CITY OF WICHITA
BESMITH CITY ENGINEER
MARCH 1954 PROJ. C13-185