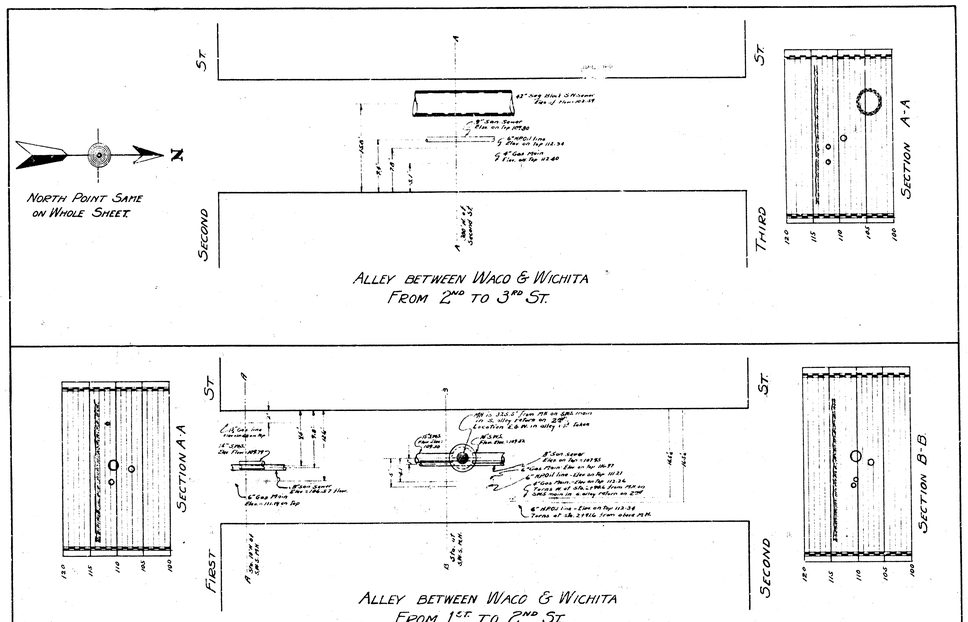

ST.
ST.
SECOND
THIRD
N
NORTH POINT SAME ON WHOLE SHEET.
SECTION A-A
ALLEY BETWEEN WACO & WICHITA
FROM 2ND TO 3RD ST.
FIRST
SECOND
SECTION B-B
ALLEY BETWEEN WACO & WICHITA
FROM 1ST TO 2ND ST.
ALLEY BETWEEN WICHITA & WATER
FROM 1ST TO 2ND ST.