


ALLEY- between Topoka & Emporia.

Waterman- to English
Concrete- 7"

B.M. Elev. 1083.38 "K" in Keeler N.S. Waterman S.S. Alley Lot Topoka & Emporia.

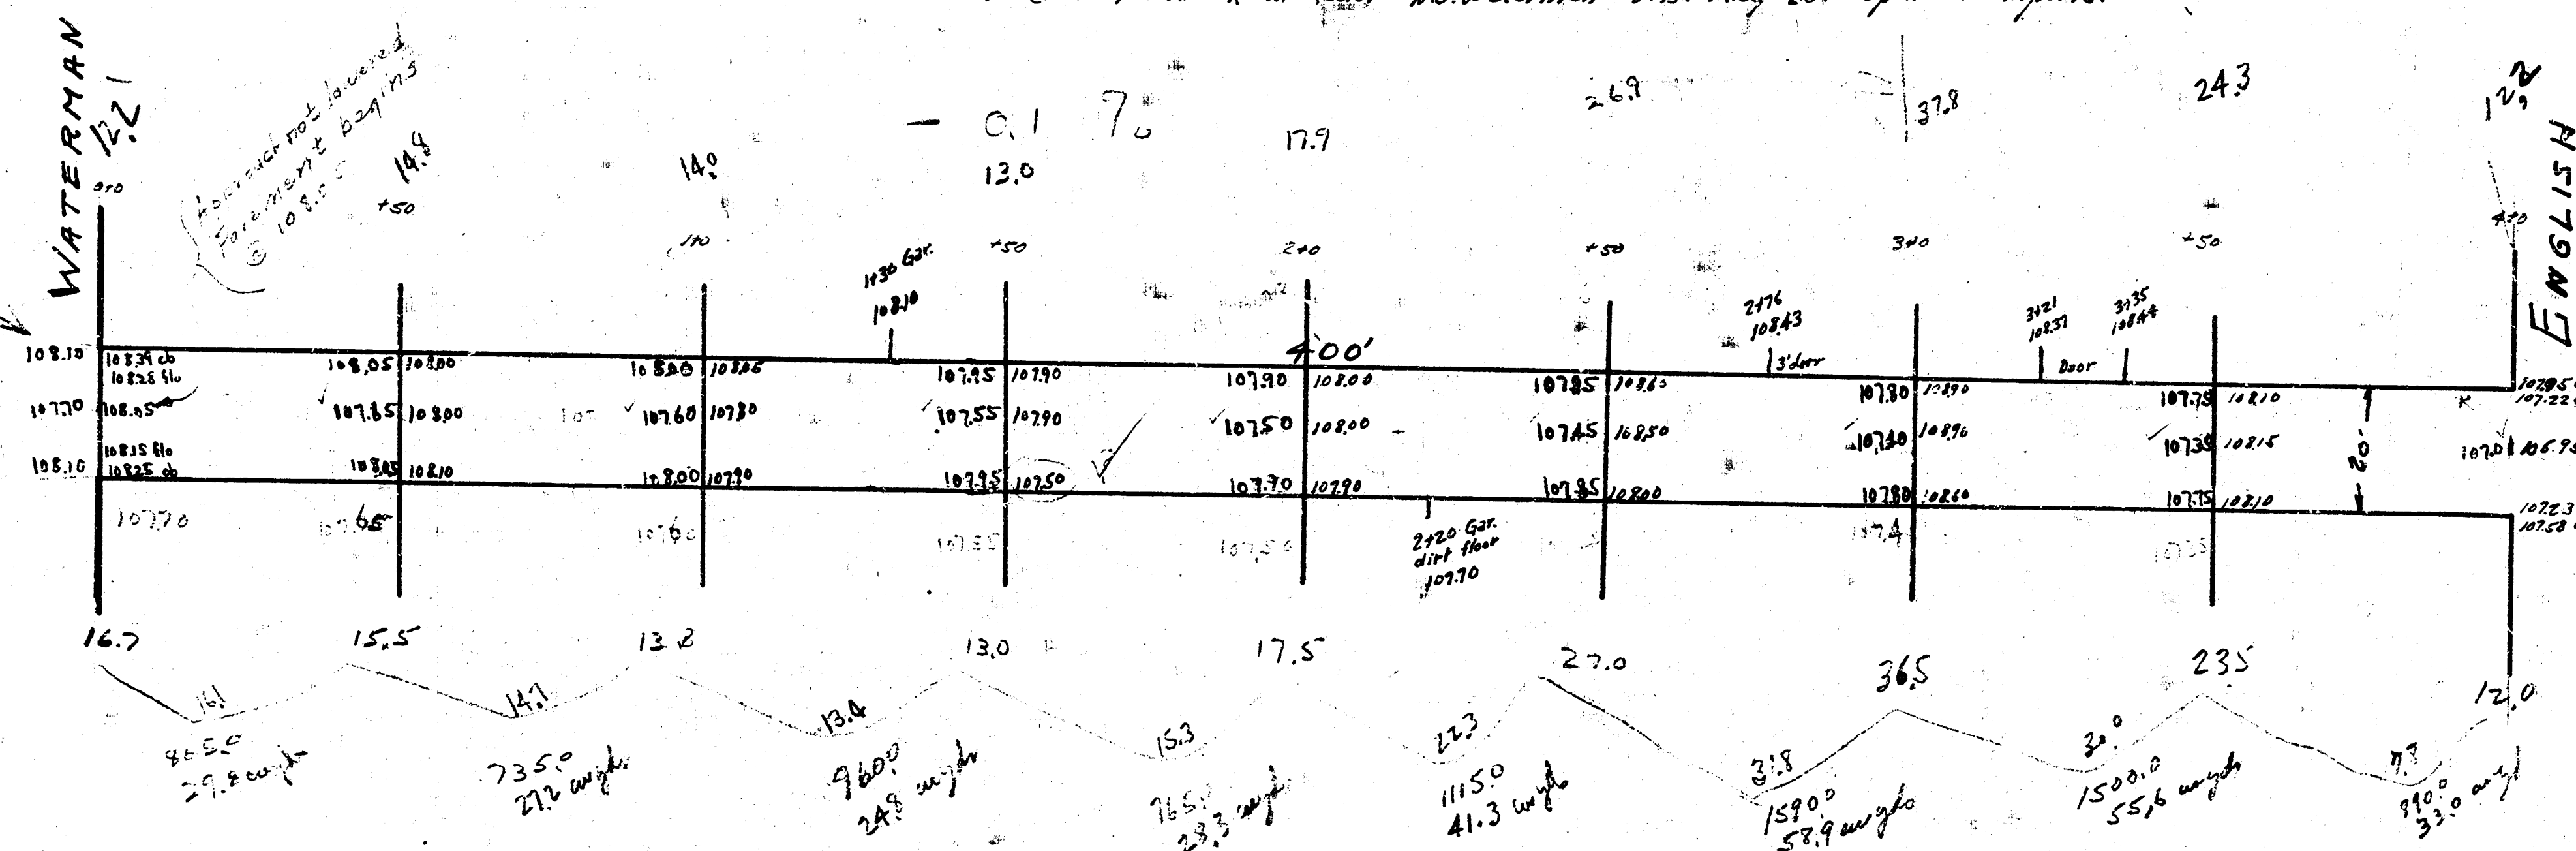

Length = 277.9
+ 17.0 = 294.9
326.8 wgt