
PAVING PLAN
ALLEY NORTH OF CENTRAL AVENUE
E.L. ST. FRANCIS AVE. TO W.L. SANTA FE AVE.
20' Concrete 6" thick
¾" ϕ Reinforcing Steel

NOTE:- Figures on right side of station lines are ground elevations, those on left side are elevations of the Finished pavement.

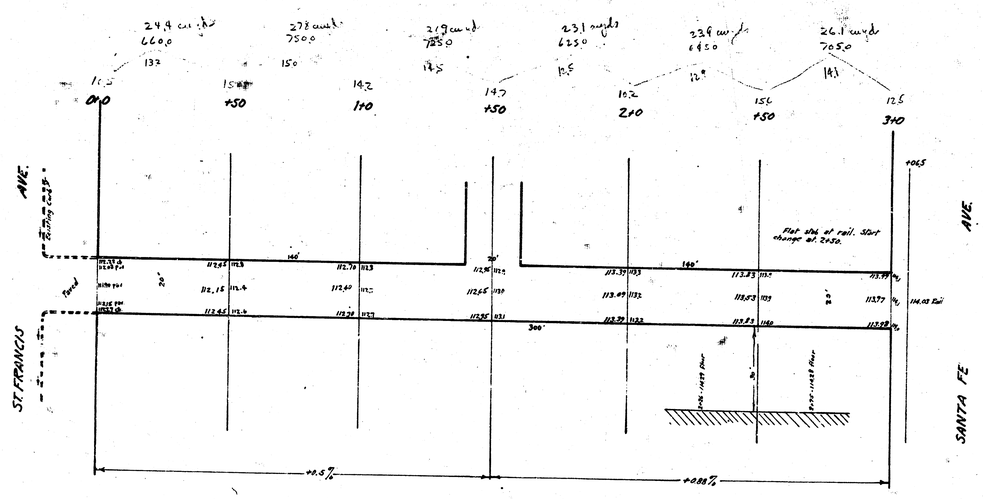

B.M. Elev. 112.58 N.W. cor. conc. base signal light S.E. cor. St. Francis & Central

N
1"=20'