



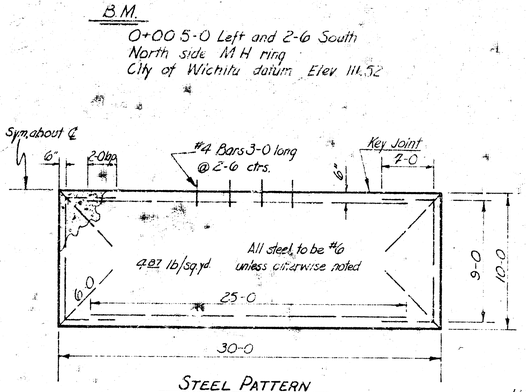

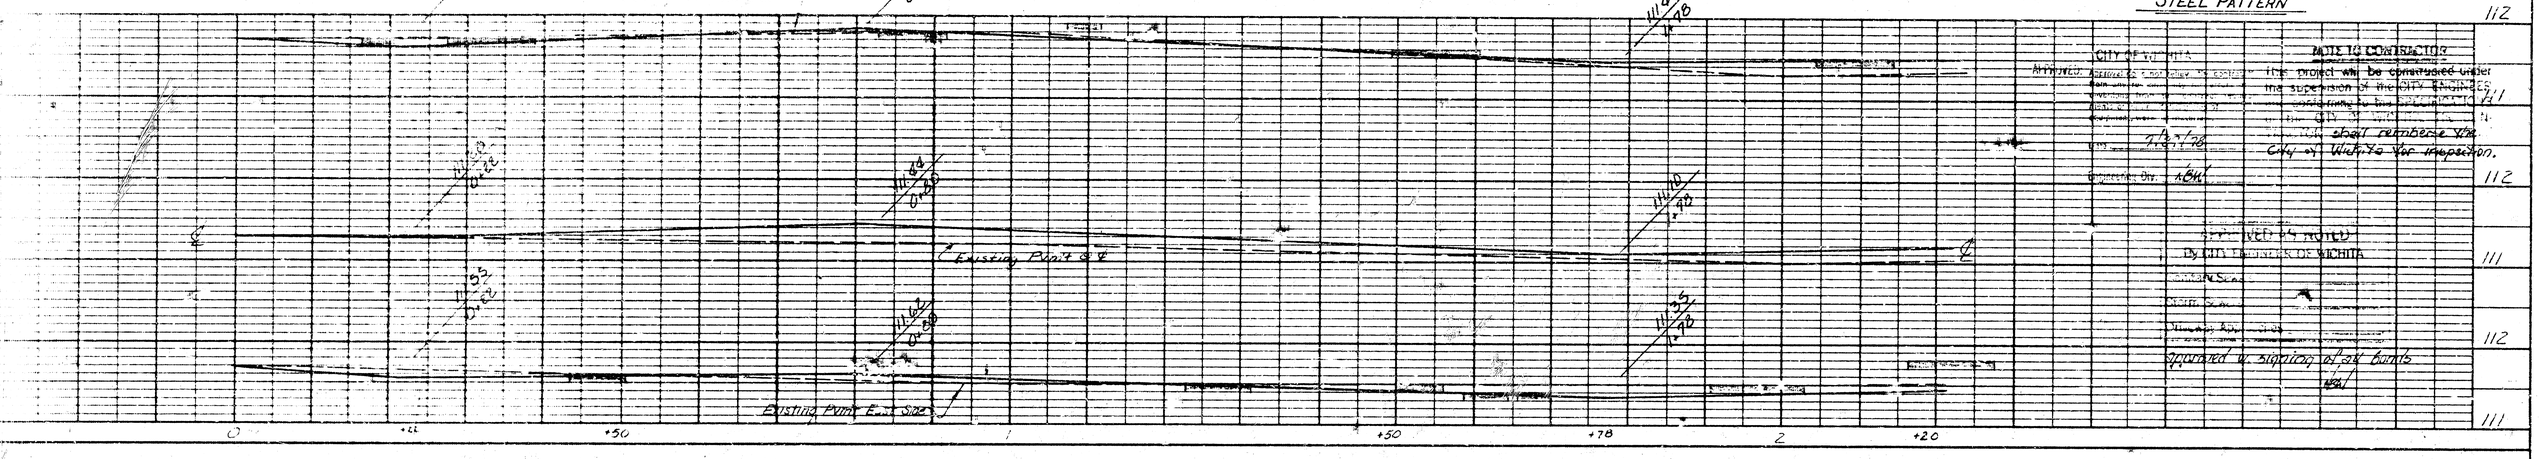



NOTE TO CONTRACTOR
This project will be constructed under the supervision of the CITY ENGINEER conforming to the CITY SPECIFICATIONS. The CONTRACTOR shall reimburse the City of Wichita for inspection.

CITY OF WICHITA
APPROVED. Approval is conditional upon compliance with all requirements noted on plans and specifications.
DATE 7/27/78
ENGINEERING DIV. KBH

By CITY ENGINEER OF WICHITA


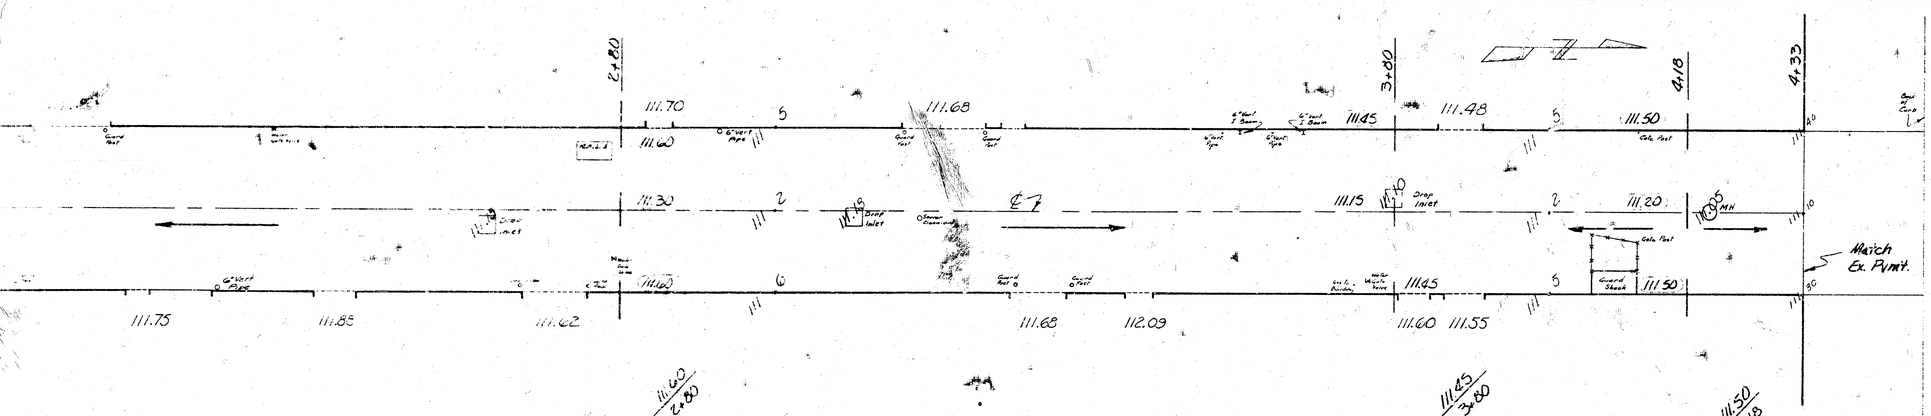

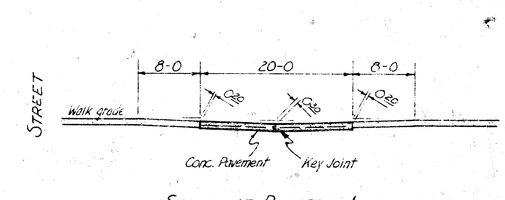

Rev.	Date	By	Description
A	7-27-78	R.F.M.	Deleted prop. grades per City of Wichita request

MAJOR INC.
WICHITA, KANSAS
PLAN AND PROFILE
ALLEY PAVEMENT
SOUTH OF 2ND STREET BETWEEN ST. FRANCIS & EMPORIA STS.

CAMPBELL & CASTLE
ENGINEERS
WICHITA, KANSAS

DSG
DR RFM
CH
APP

DWG. FILE NO. 7810-D-80,012

DATE June 1978

SHEET NO 7 OF 7

REV. A