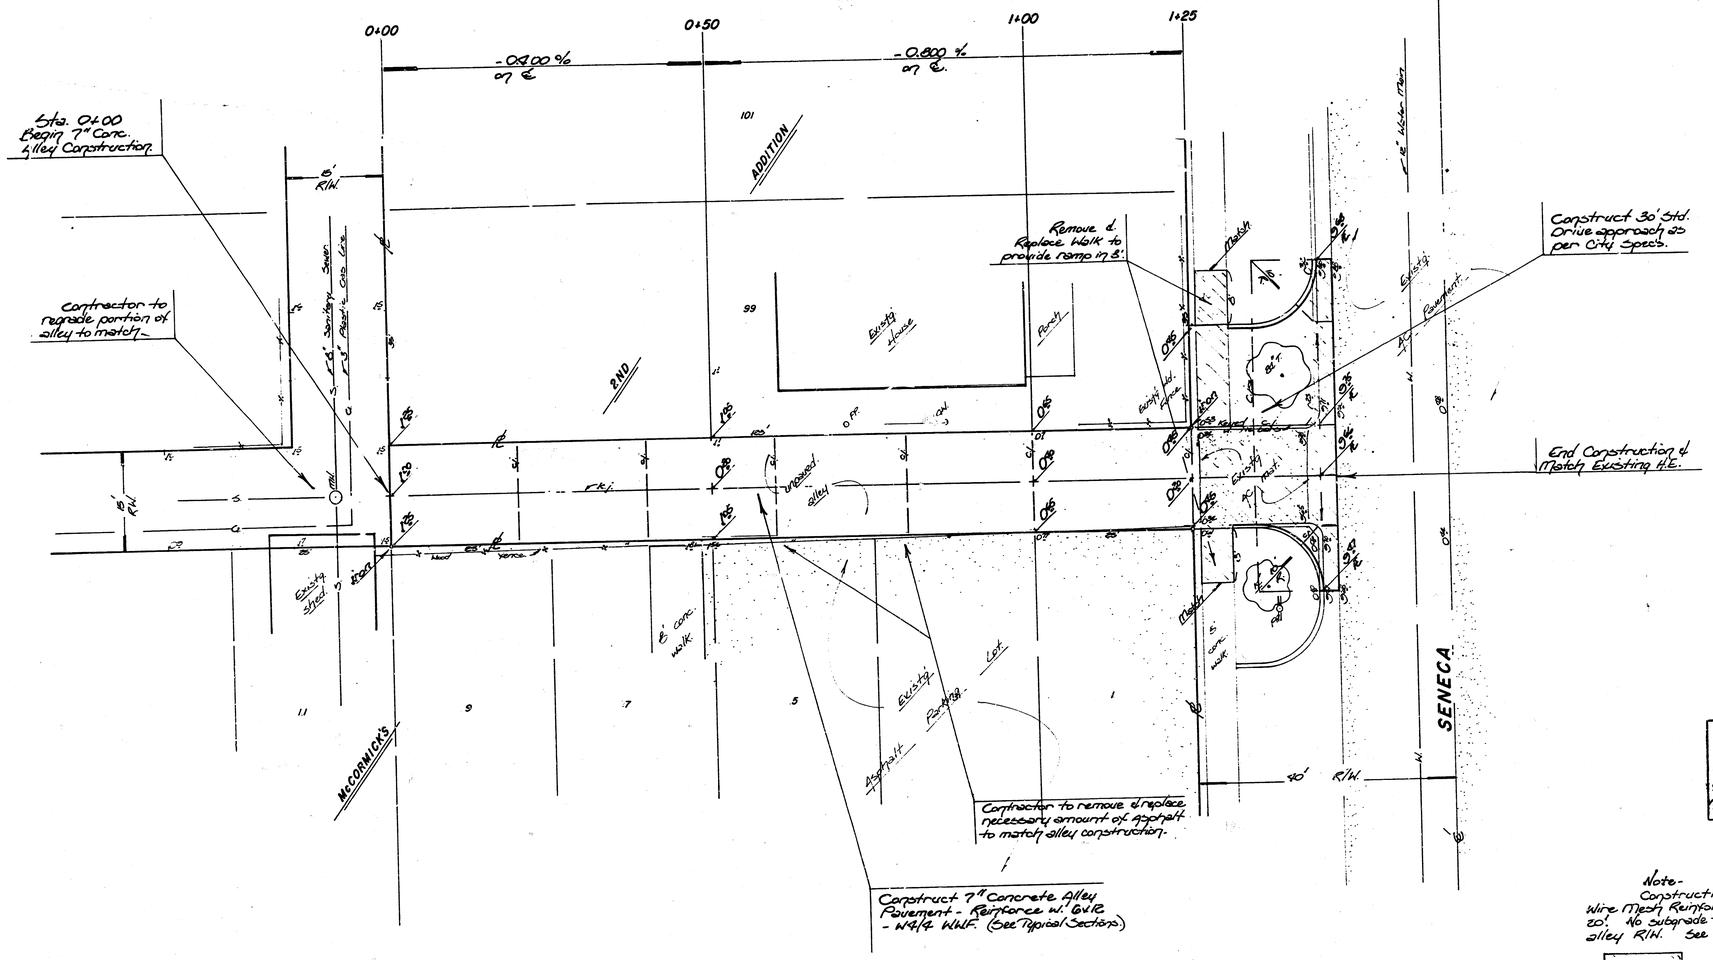

12-8-83

APPROVED AS NOTED
By CITY ENGINEER OF WICHITA
Sanitary Sewers _____
Storm Sewers Alley Pavmt. D.E.P.
~~Driveway Approaches~~

Note-
Construction of alley pavement shall include Wire Mesh Reinforcing w/ contraction joints every 20'. No subgrade treatment shall be required for the alley R/W. See detail sections.

[ ] - indicates Removal.

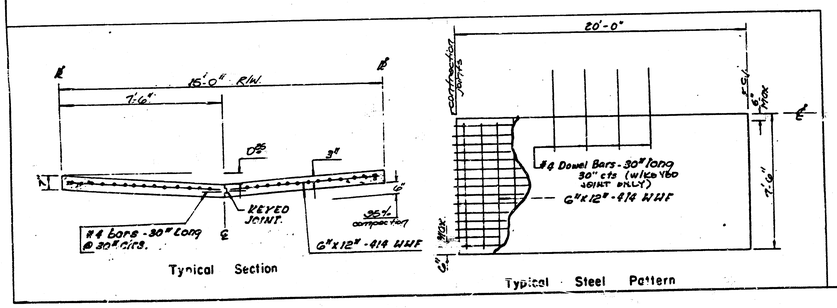

N. BRENT WOOTEN LICENSED 8470 KANSAS PROFESSIONAL ENGINEER

ALLEY PAVEMENT PROJECT FOR THE ALLEY NORTH OF 2ND STREET - 125' WEST OF W.L. SENECA. TO W.L. SENECA
CITY OF WICHITA, KANSAS.
PROJ. NO. 472-76-245-80000-000-000-008

BAUGHMAN COMPANY, P.A.
SURVEYING & ENGINEERING
316/262-7271 • 330 LAURA • WICHITA, KANSAS 67211

FILMED FROM THE BEST AVAILABLE COPY