


JT 20251 page 27-28

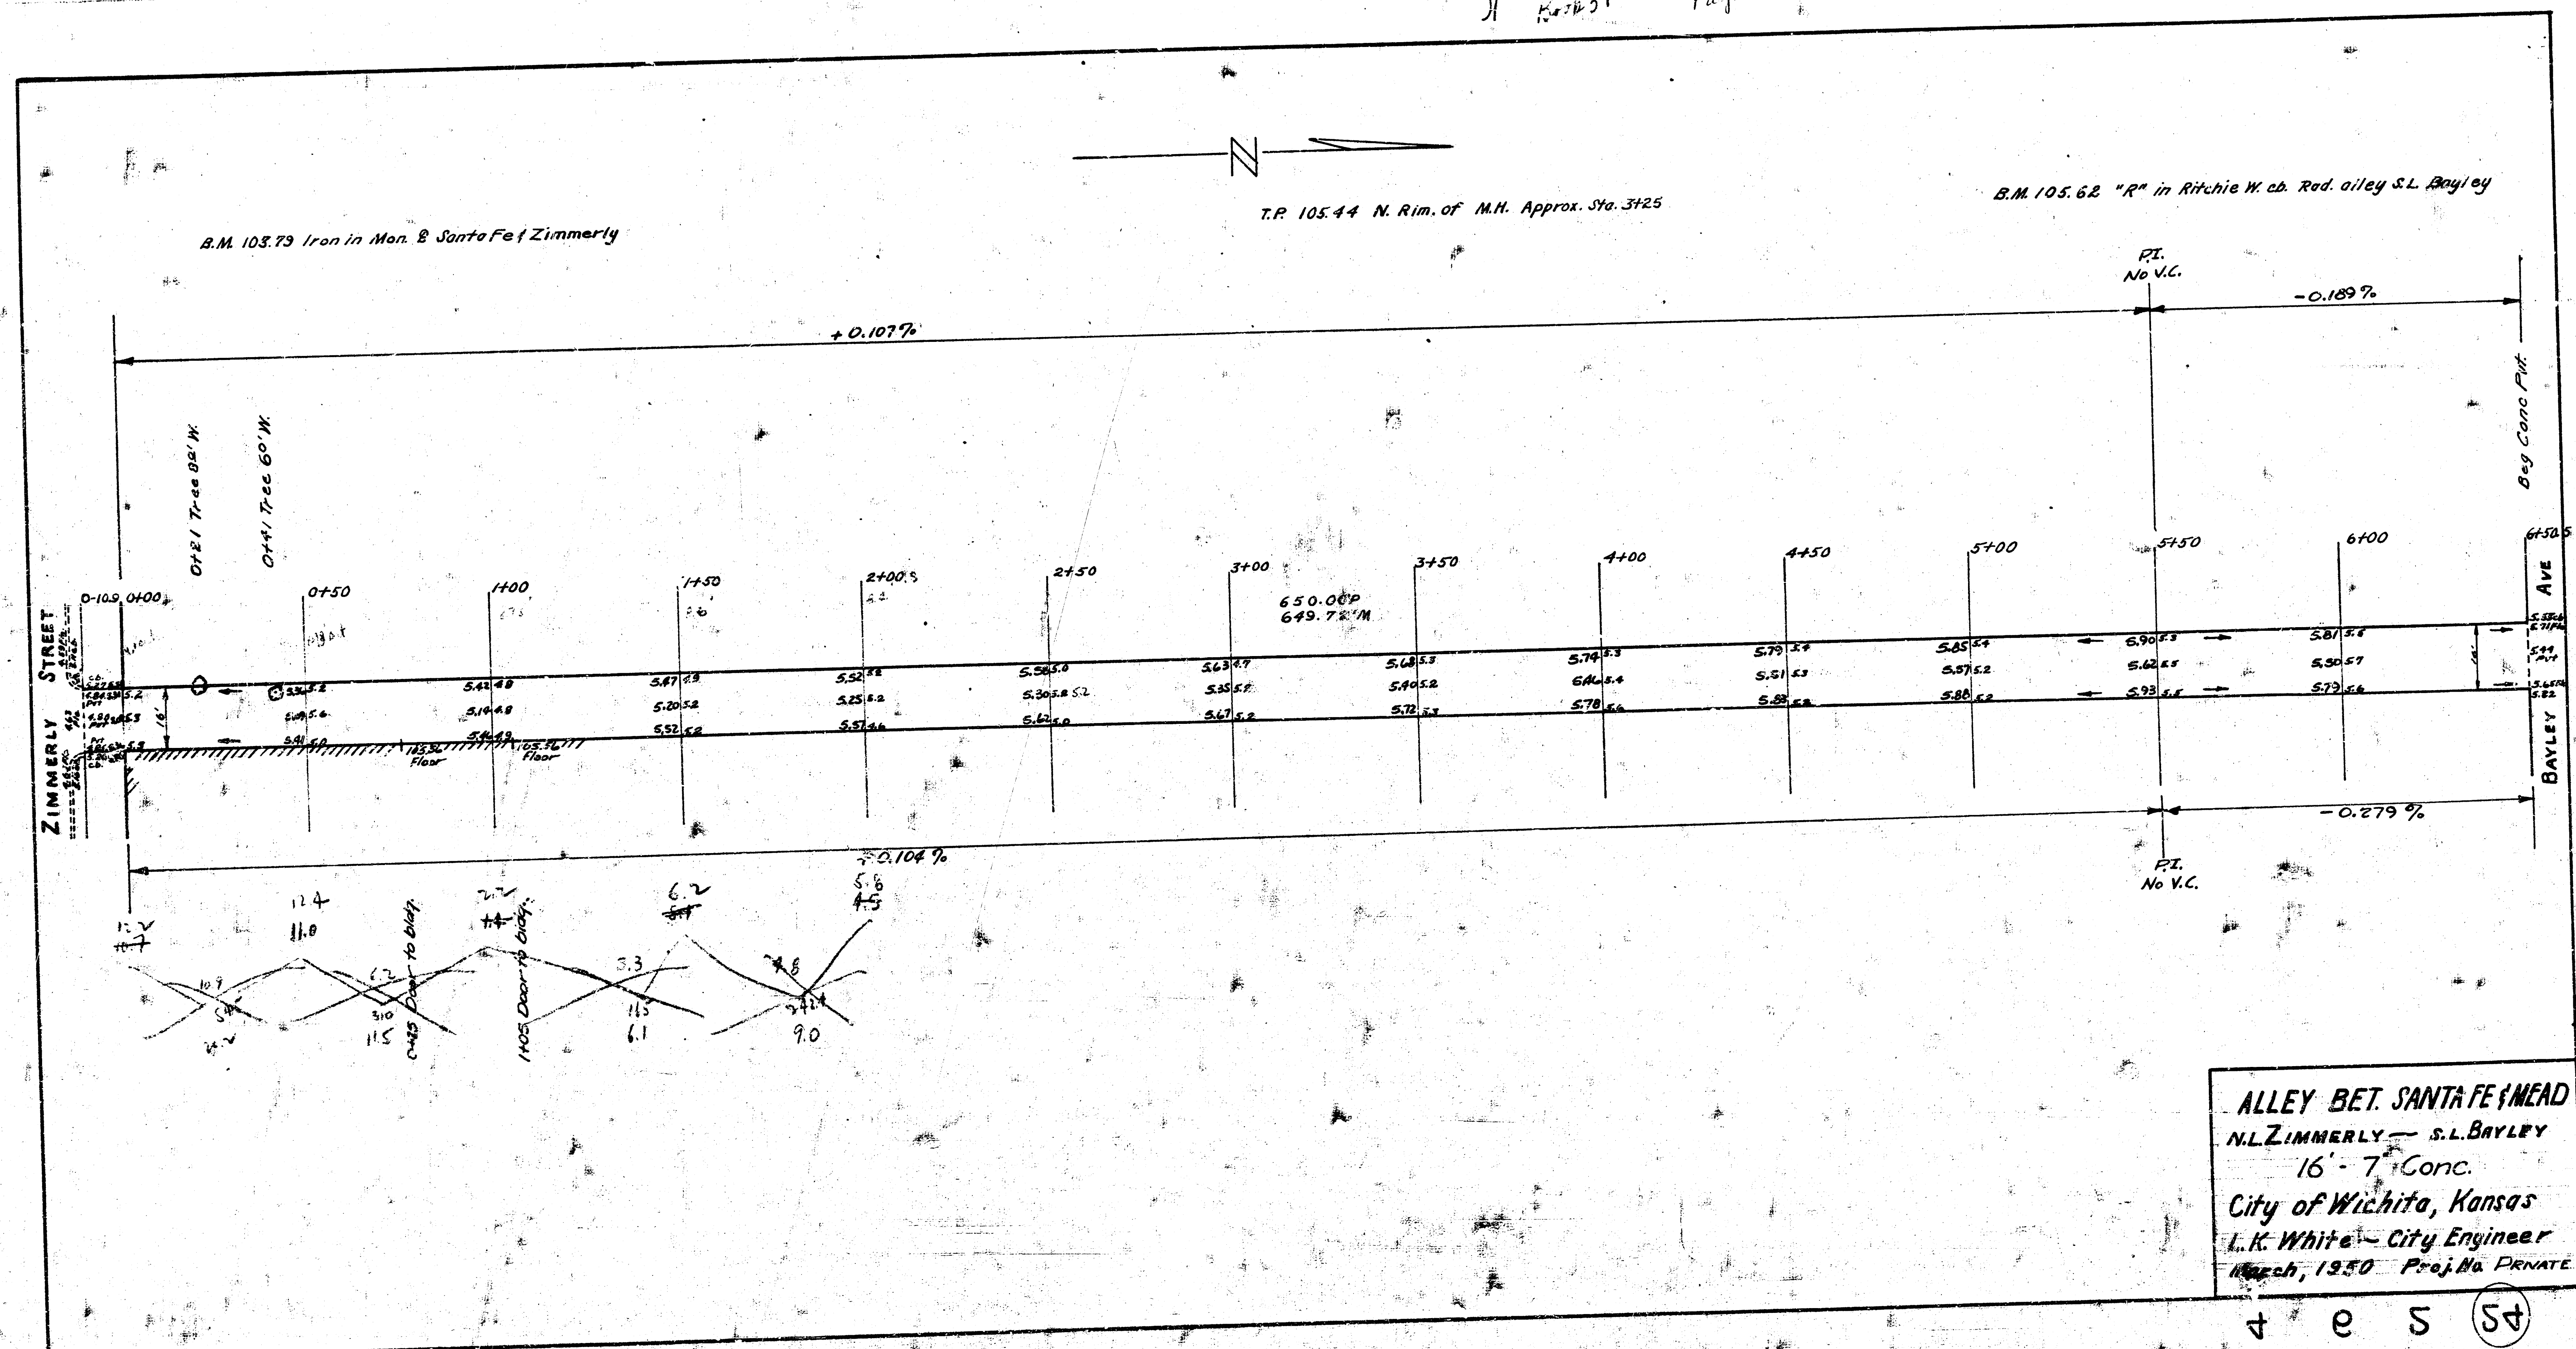

ALLEY BET. SANTA FE & MEAD
 N.L. ZIMMERLY - S.L. BAYLEY
 16' - 7" Conc.
 City of Wichita, Kansas
 L.K. White - City Engineer
 March, 1950 Proj. No. PRNATE

4 e 5 (54)