
B.M. 1151.1 "C" in Carter Ctr. of Wk. N., N.W Cor. Waco & 2nd - 8' N. of N.R.

Chain E. on ℄

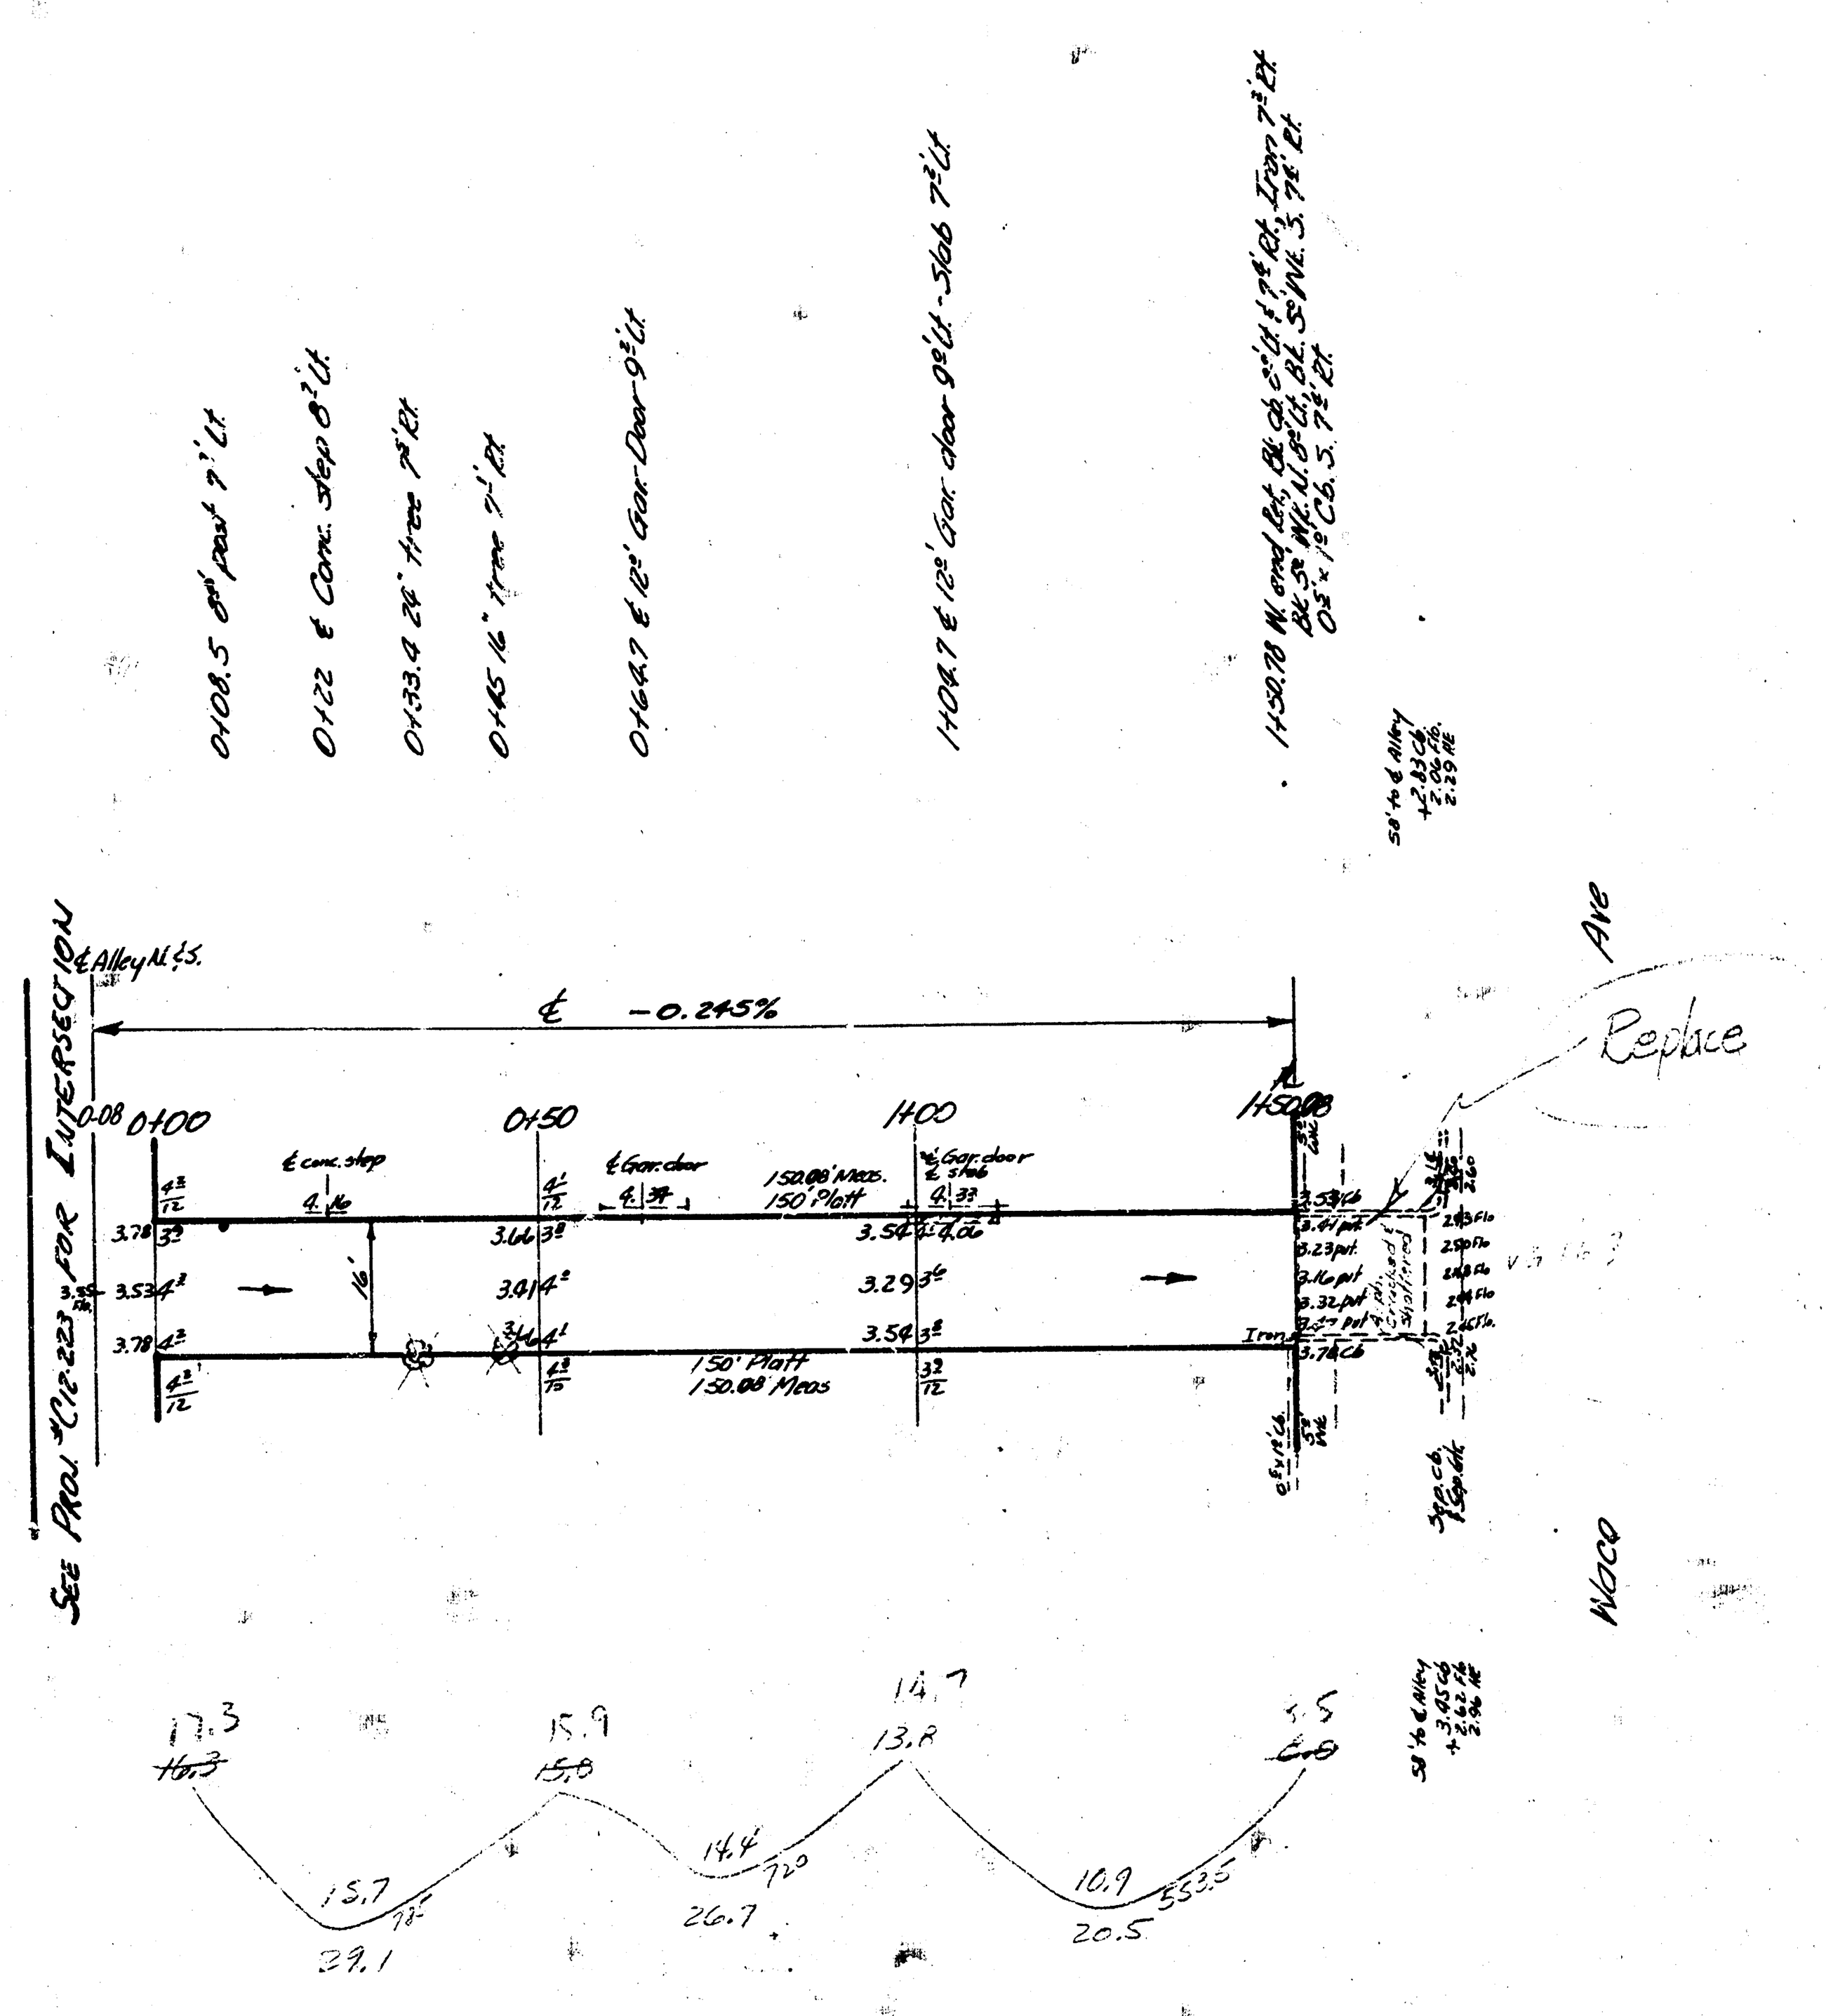

Excav.

Prep 76.3
+10% 7.6
total 83.9 cu. yd.

City 0

Scale 1"=20'

B. E. SMITH LICENSED 436 KANSAS PROFESSIONAL ENGINEER

Wendt
WTD
D.E.C.
W10

ALLEY N OF 2ND

W.L. WACO TO W.L. ALLEY W OF WACO

6" CONC. 16'

CITY OF WICHITA, KANSAS

B.E. SMITH — CITY ENGINEER

JAN. 23, 1953 — PROJ. NO C12-222