
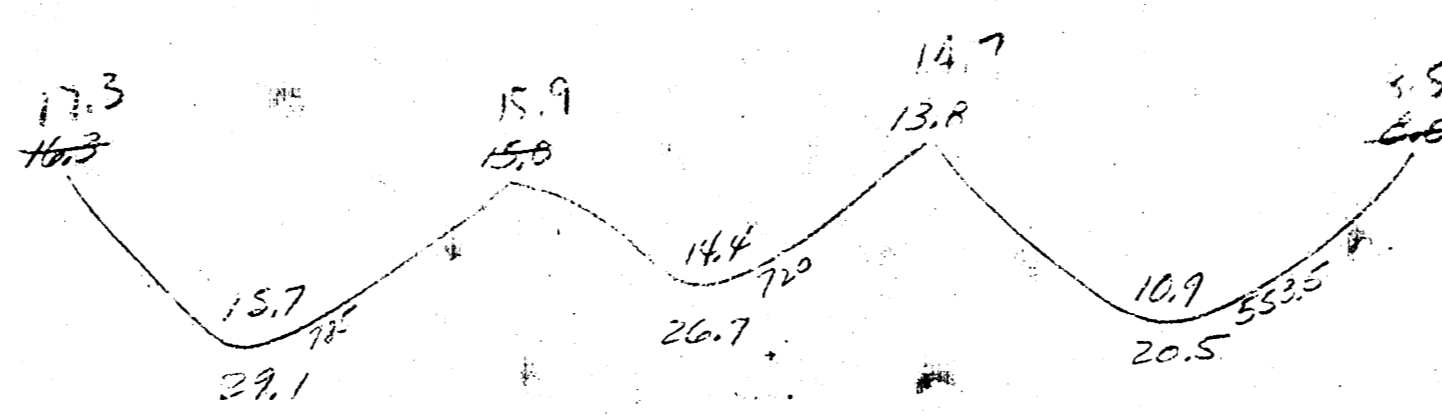


B.M. 115.11 2" in Carter Ctr. of NE. N., NW Cor. Waco & 2nd - 8' N. of N.E.

Chain E. on E

- 0108.5 8" pipe 2' x 1'
- 0122 6" Conc. slab 8' x 4'
- 0133.9 8" pipe 2' x 1'
- 0145 8" pipe 2' x 1'
- 0164.7 6" Conc. slab 8' x 4'
- 1108.7 6" Conc. slab 8' x 4'
- 1108.7 6" Conc. slab 8' x 4'

Excav.  
 Prep 76.3  
 City 31.2  
 Total 83.9 cu. yd.

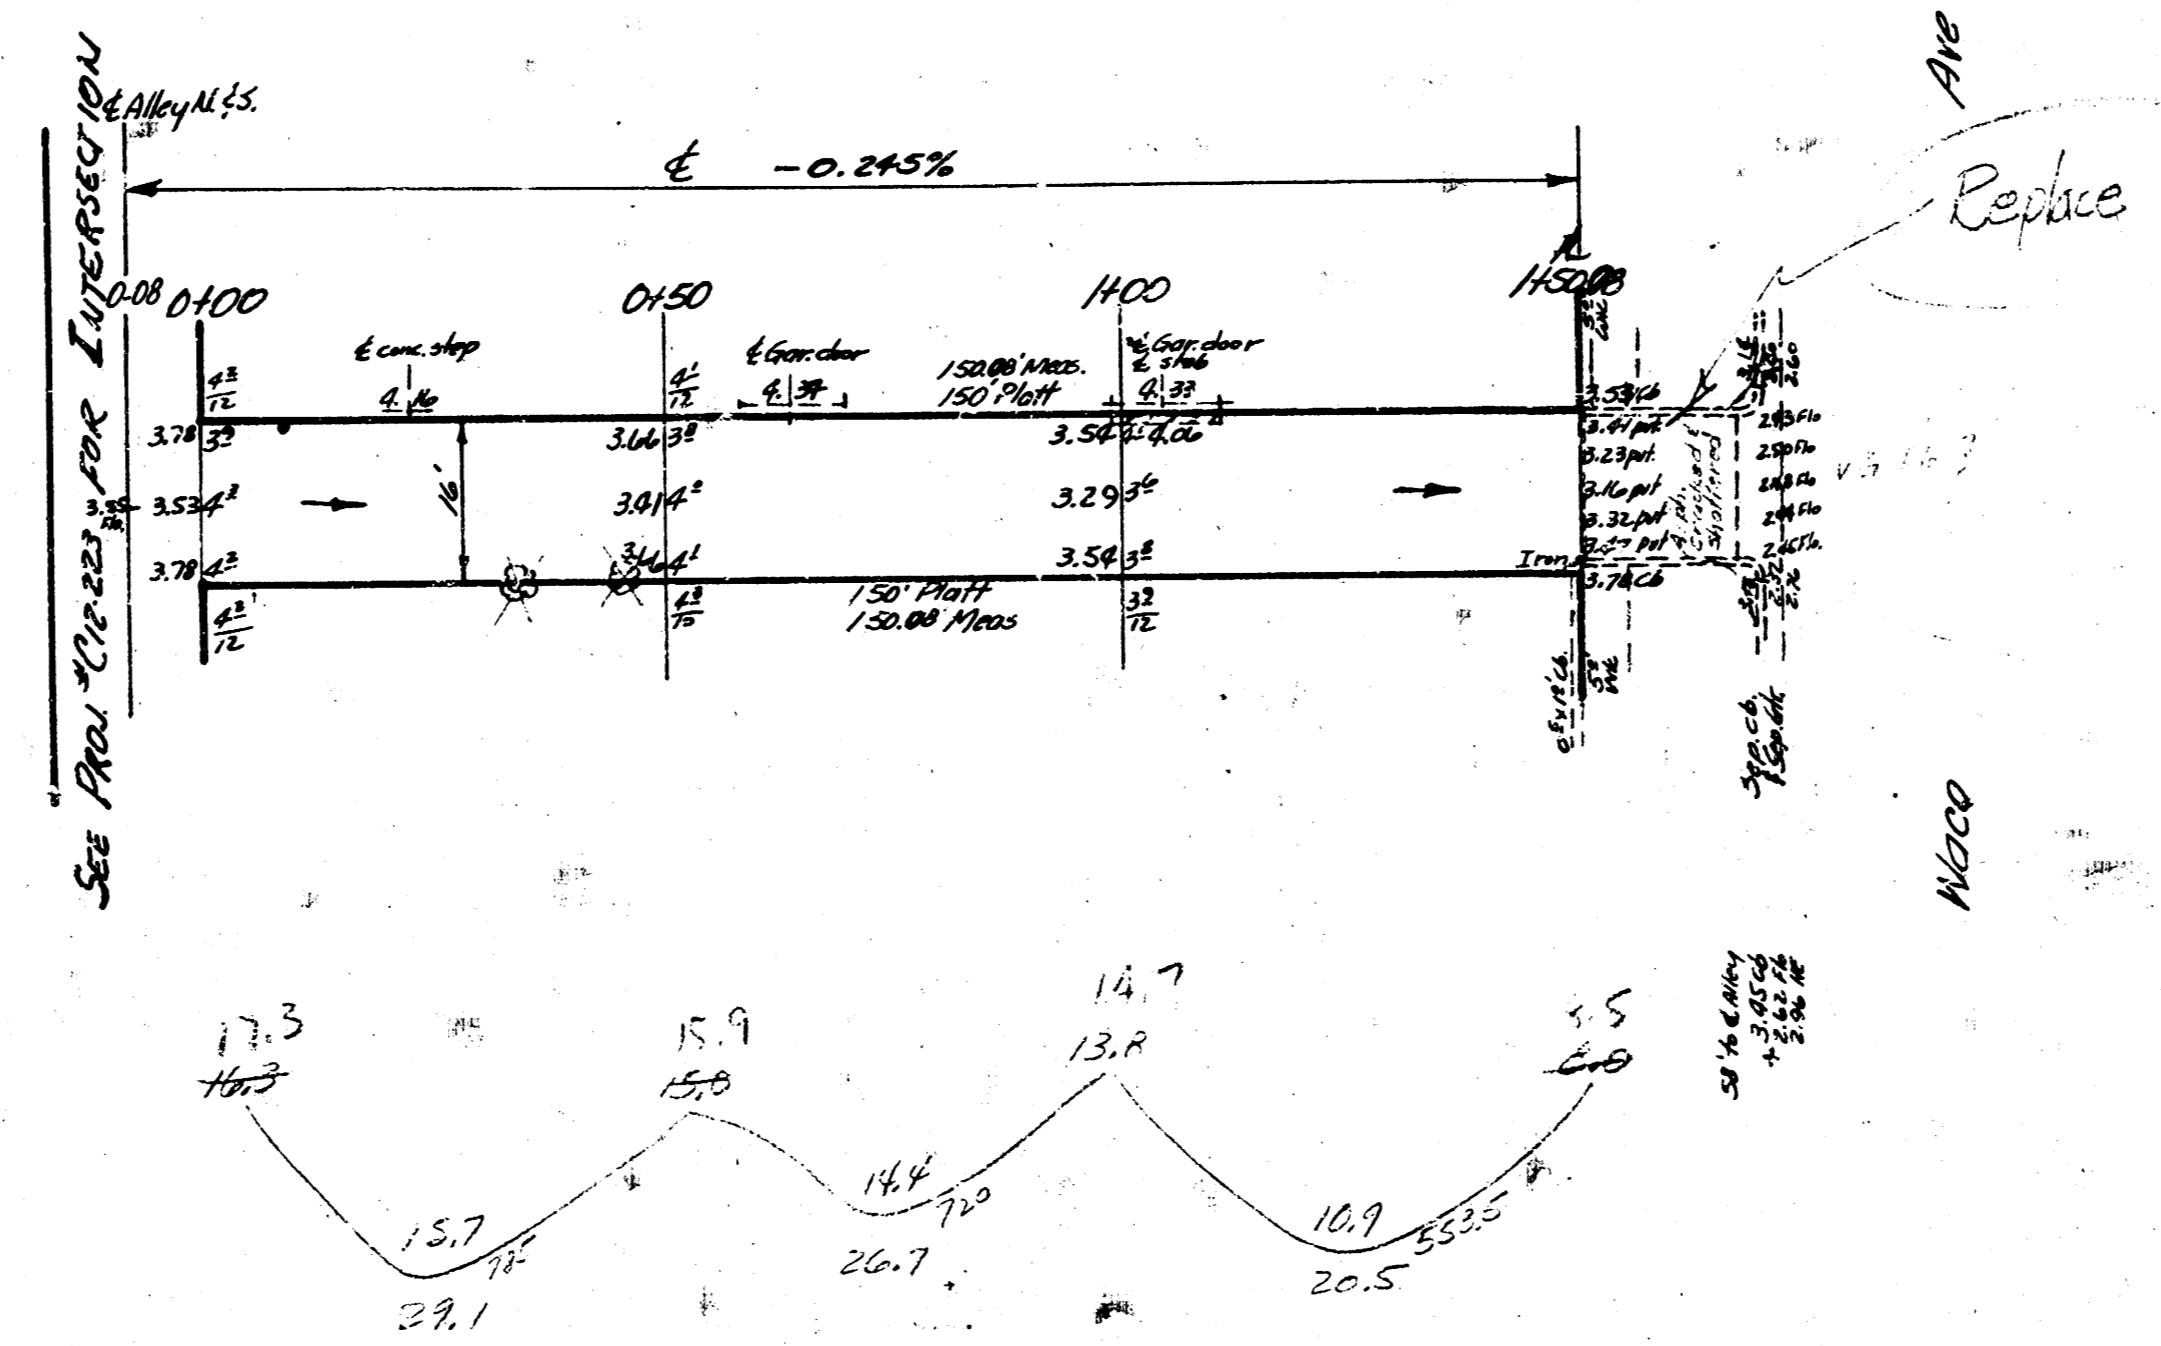

Approved  
 W.D.  
 DEC  
 1933

SCALE 1"=20'



ALLEY N. OF 2ND E. ST.  
 W. WACO TO W. ALLEY W. OF WACO  
 6" CONC. 16'

CITY OF WICHITA, KANSAS  
 B.E. SMITH CITY ENGINEER  
 JAN. 23, 1933 Proj. No. C12-222