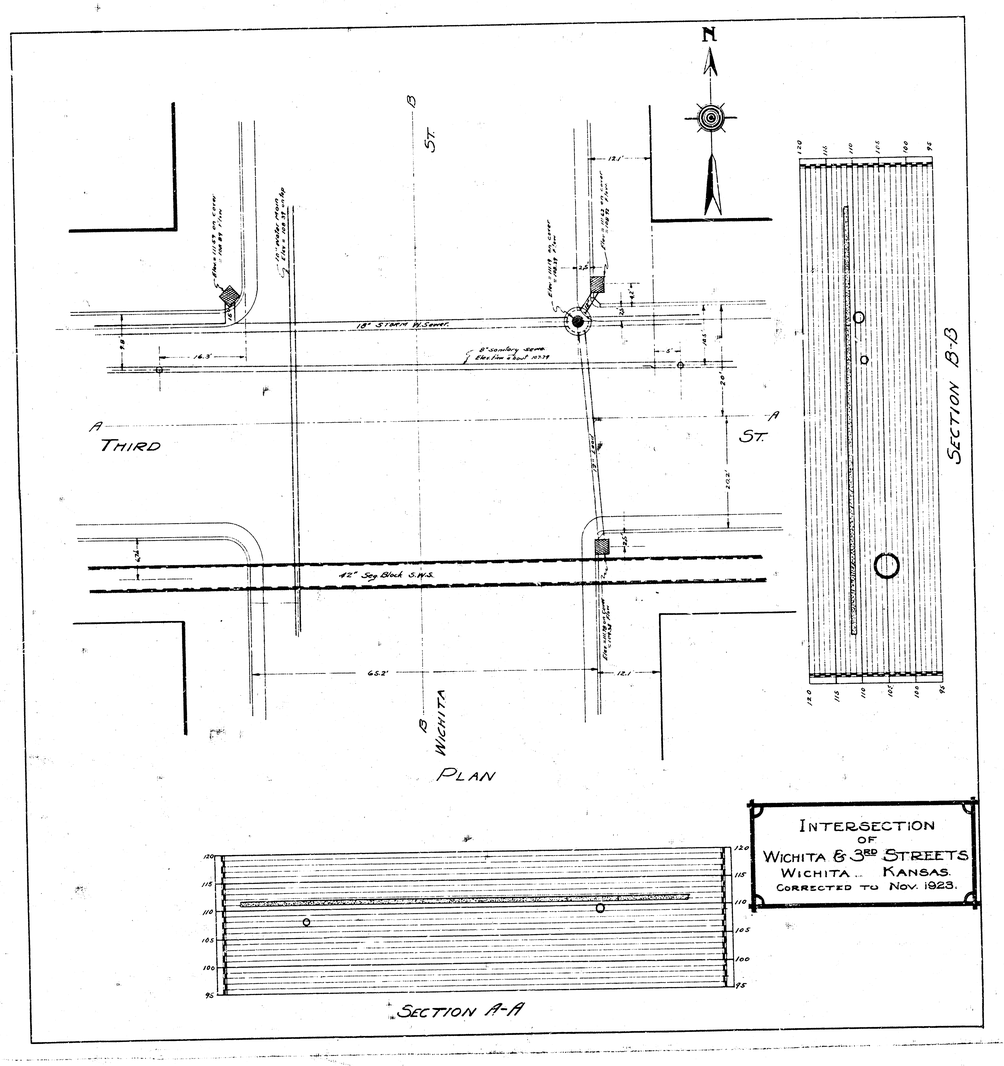
N
B
ST.
18" STORM W. Sewer
8" Sanitary Sewer
A
THIRD
A
ST.
42" Soy Block S.M.S.
B
WICHITA
PLAN
SECTION B-B
SECTION A-A
INTERSECTION
OF
WICHITA & 3RD STREETS
WICHITA .. KANSAS.
CORRECTED TO NOV. 1923.