
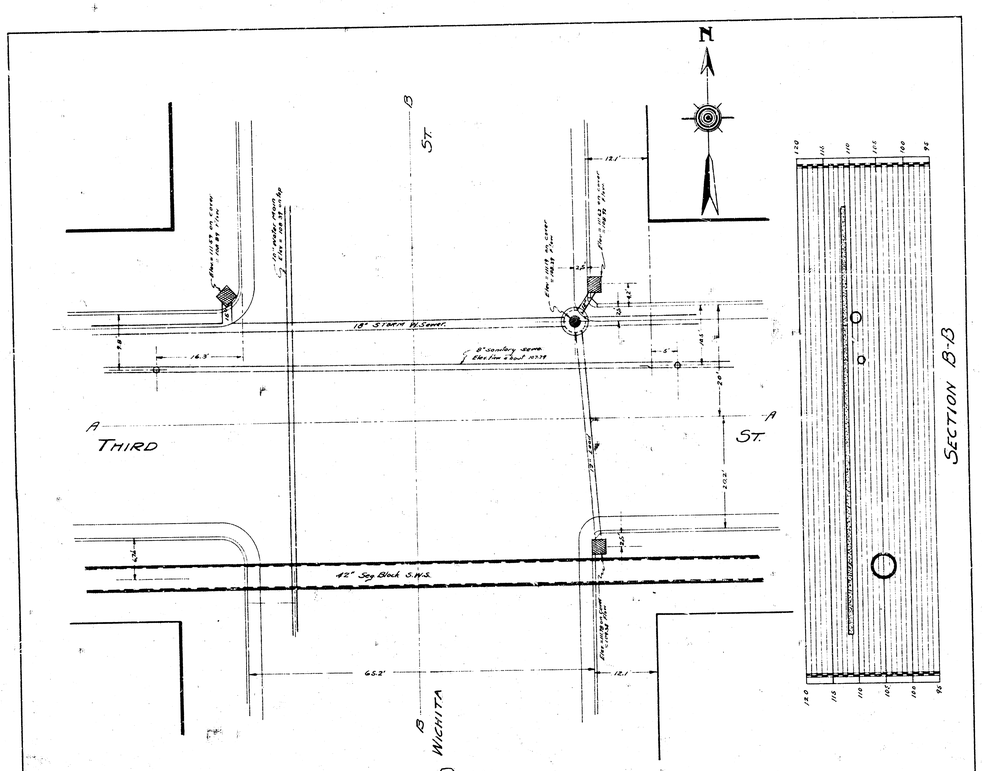


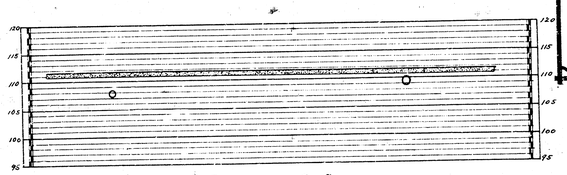

INTERSECTION
OF
WICHITA & 3RD STREETS
WICHITA, KANSAS.
CORRECTED TO NOV. 1923.