
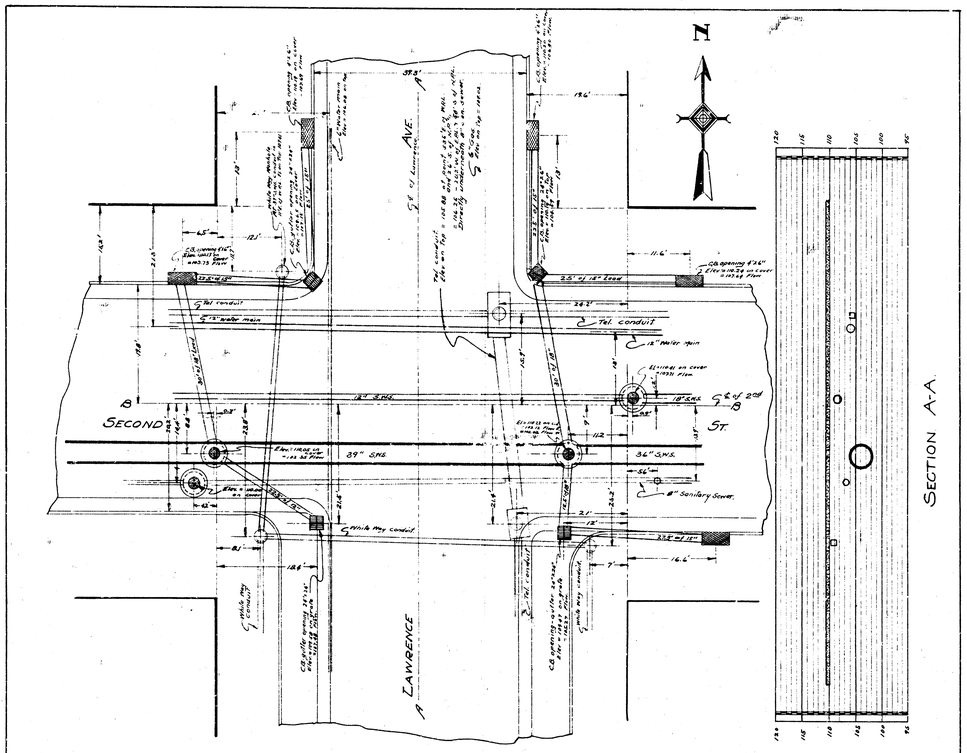


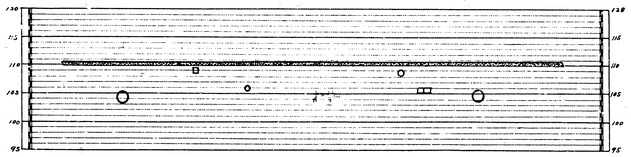

INTERSECTION
OF
SECOND STREET
AND
LAWRENCE AVENUE.
WICHITA KANSAS
CORRECTED TO SEPT 1923.