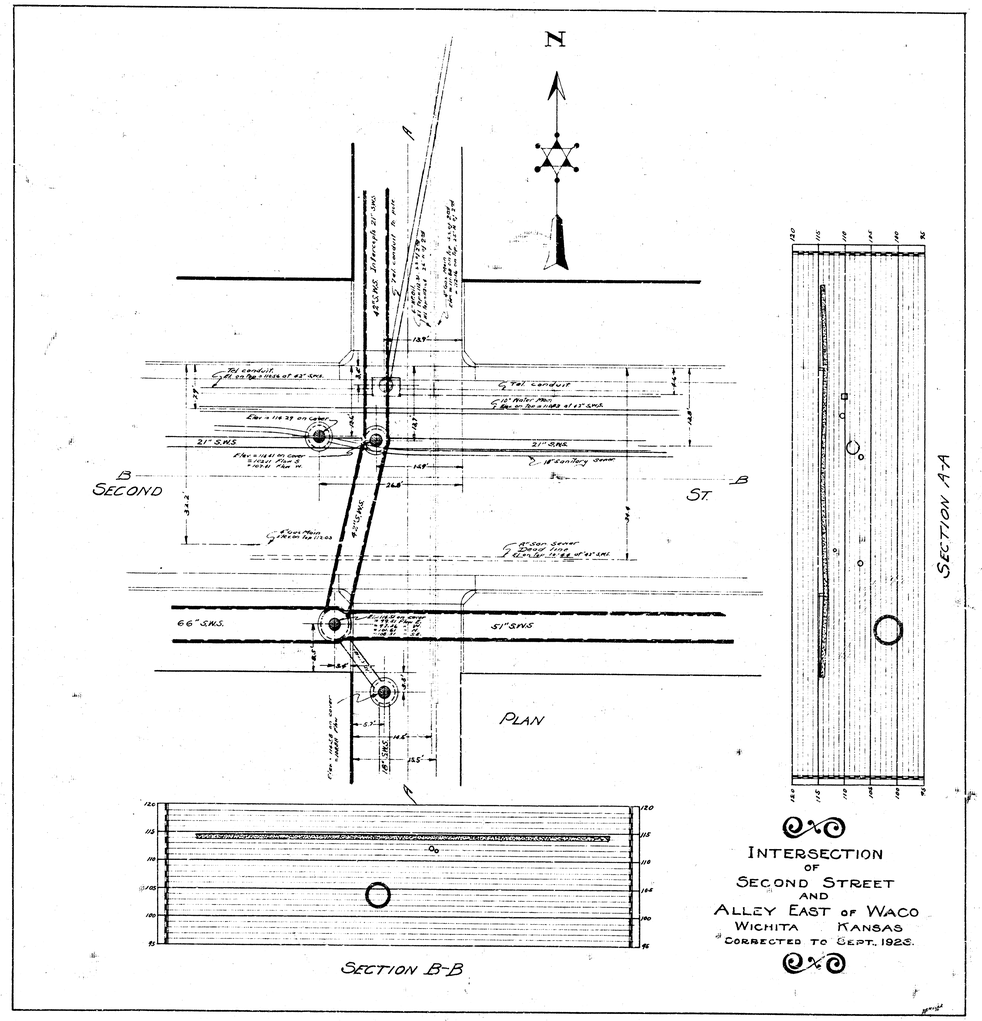
N
SECOND
ST
PLAN
SECTION A-A
SECTION B-B
INTERSECTION
OF
SECOND STREET
AND
ALLEY EAST OF WACO
WICHITA KANSAS
CORRECTED TO SEPT. 1926.