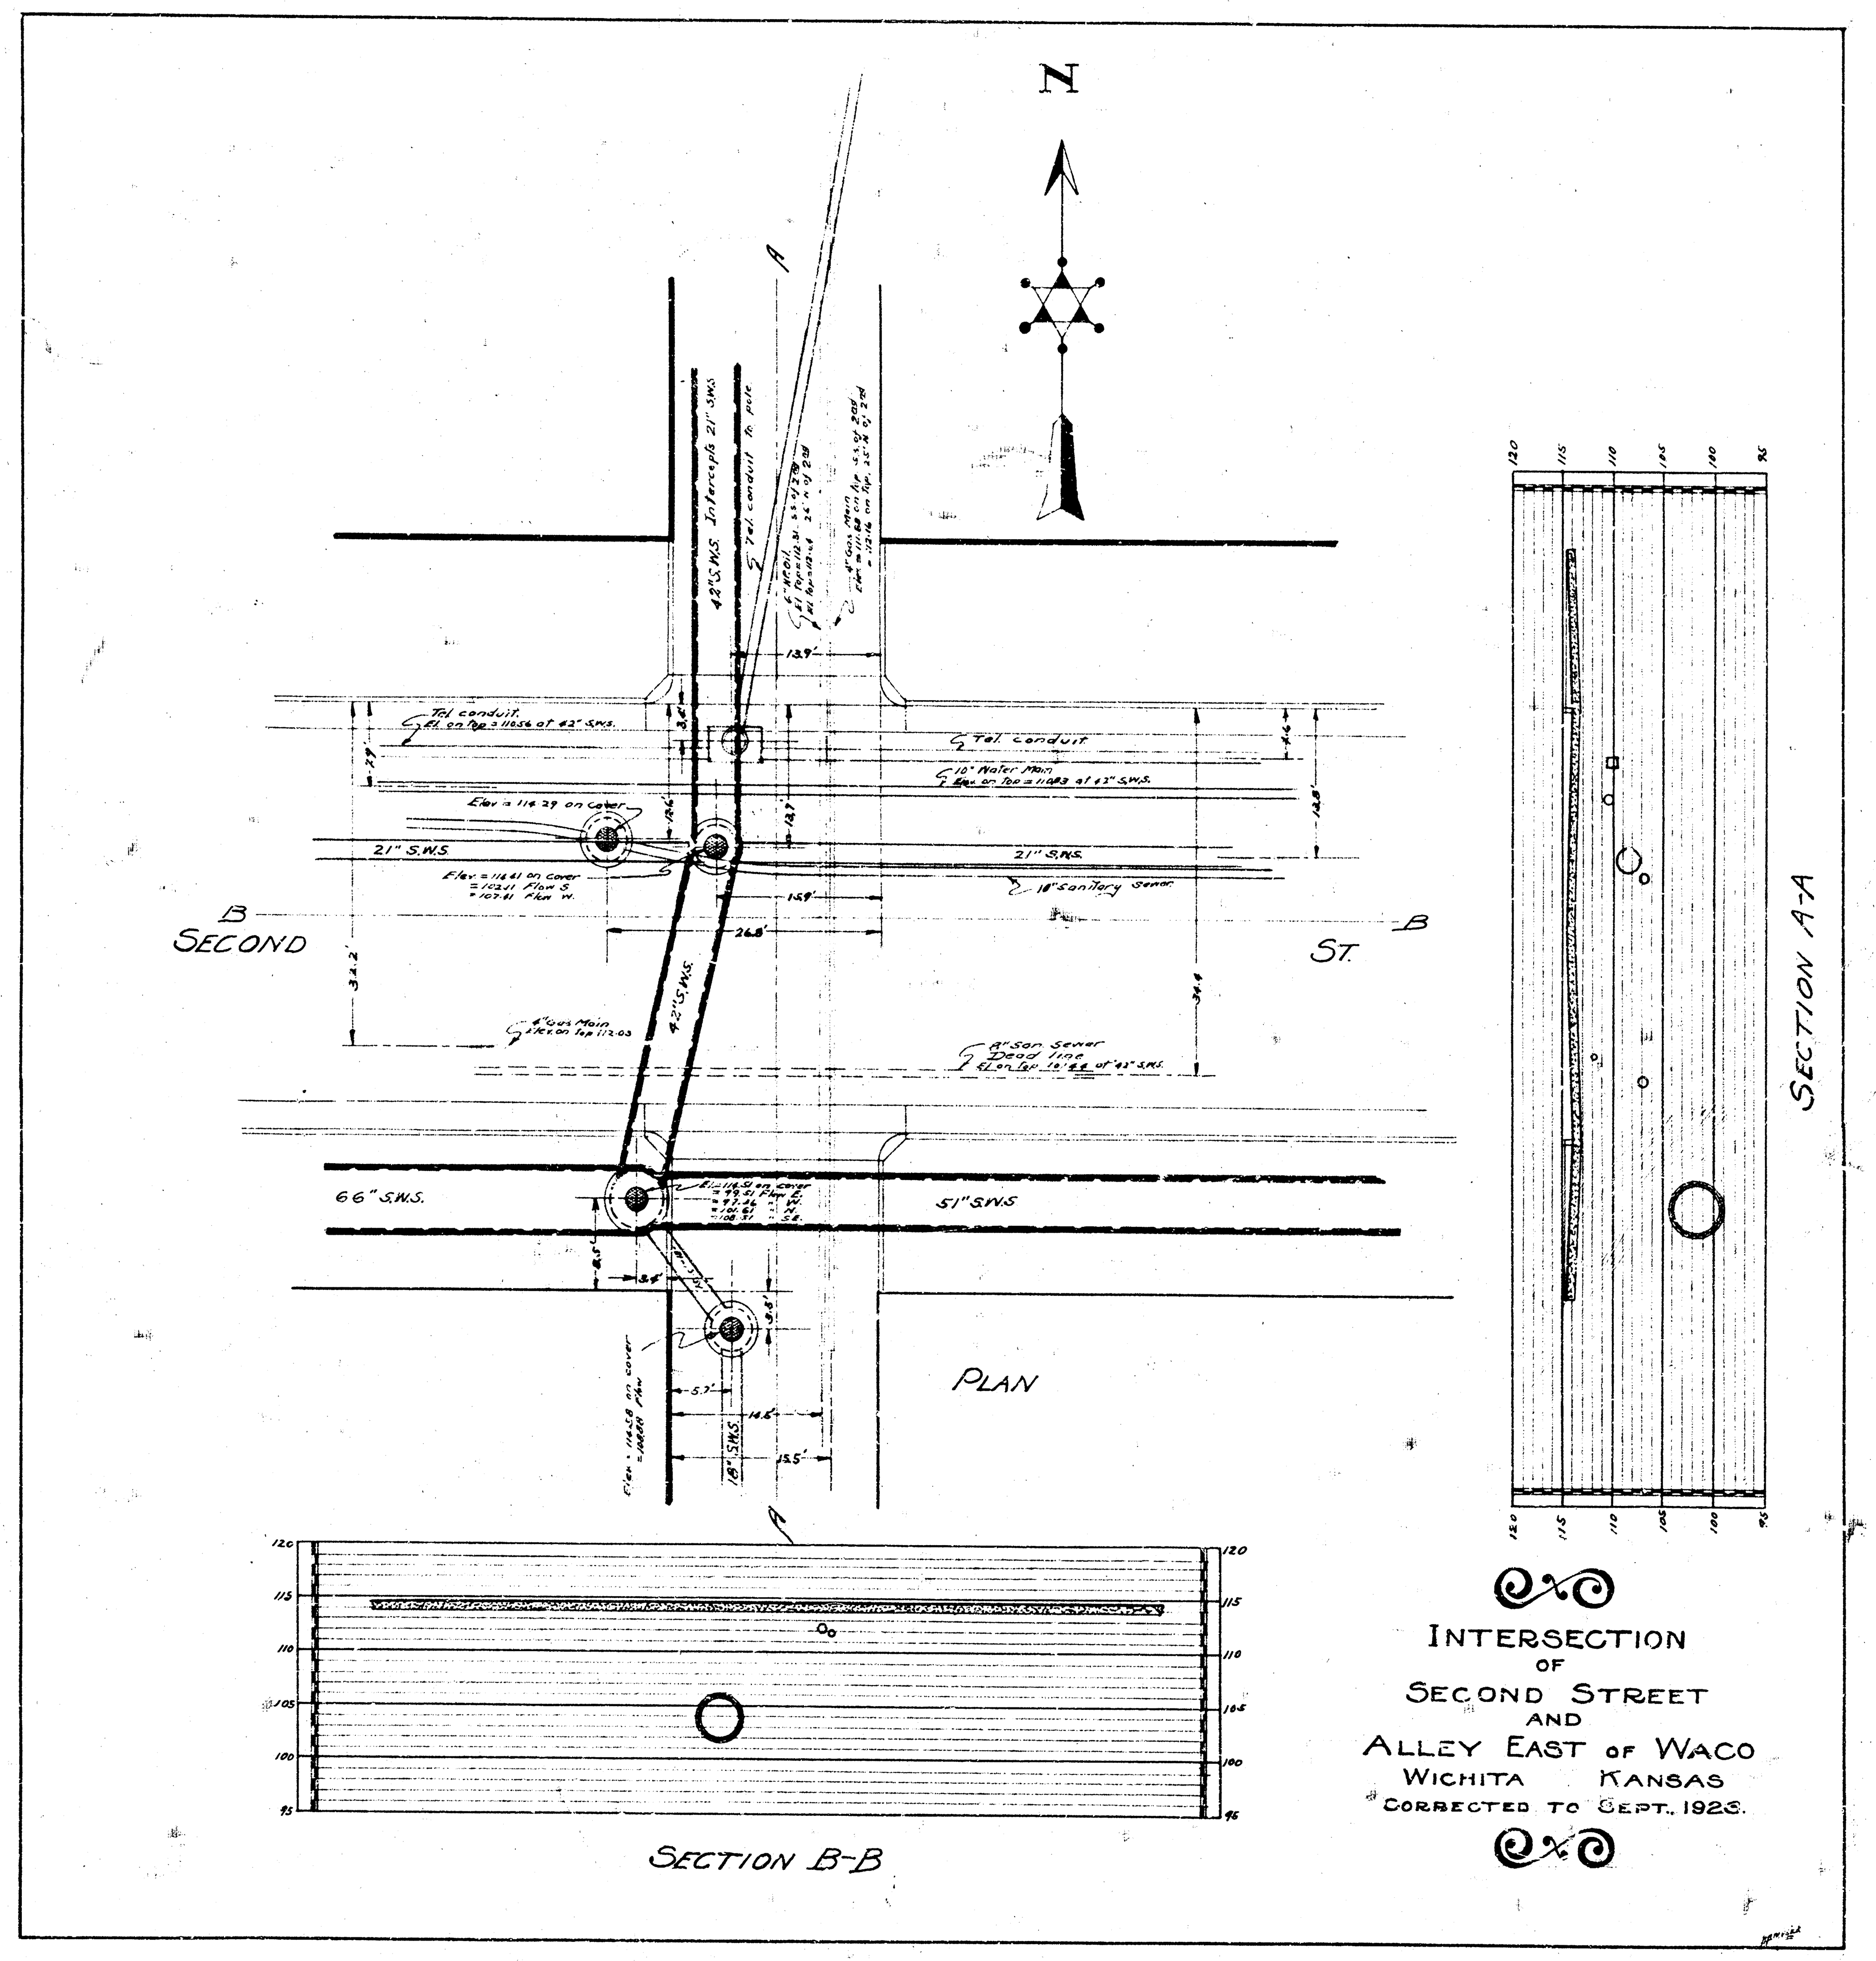


INTERSECTION
OF
SECOND STREET
AND
ALLEY EAST OF WACO
WICHITA KANSAS
CORRECTED TO SEPT. 1923.