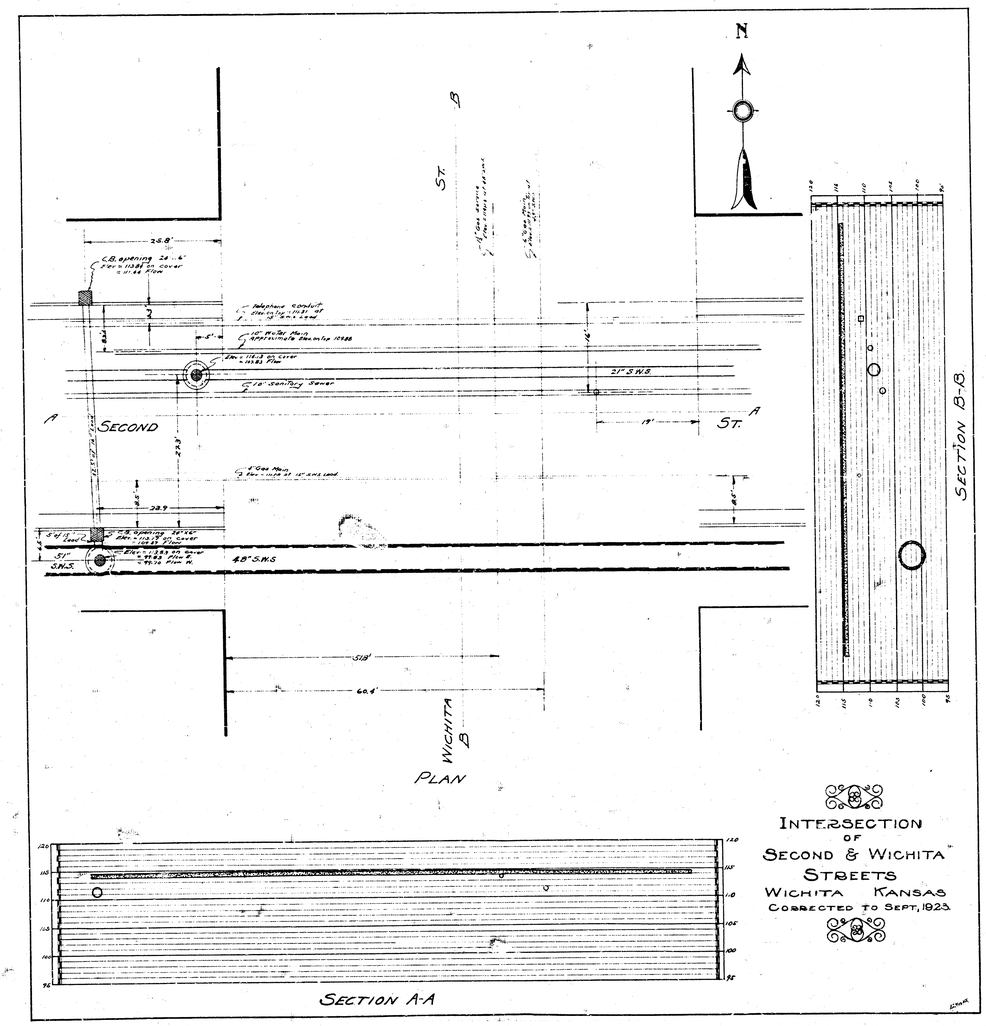

N
ST. B
SECOND
ST. A
WICHITA
ST. B
PLAN
SECTION A-A
SECTION B-B
INTERSECTION
OF
SECOND & WICHITA
STREETS
WICHITA KANSAS
CORRECTED TO SEPT, 1923