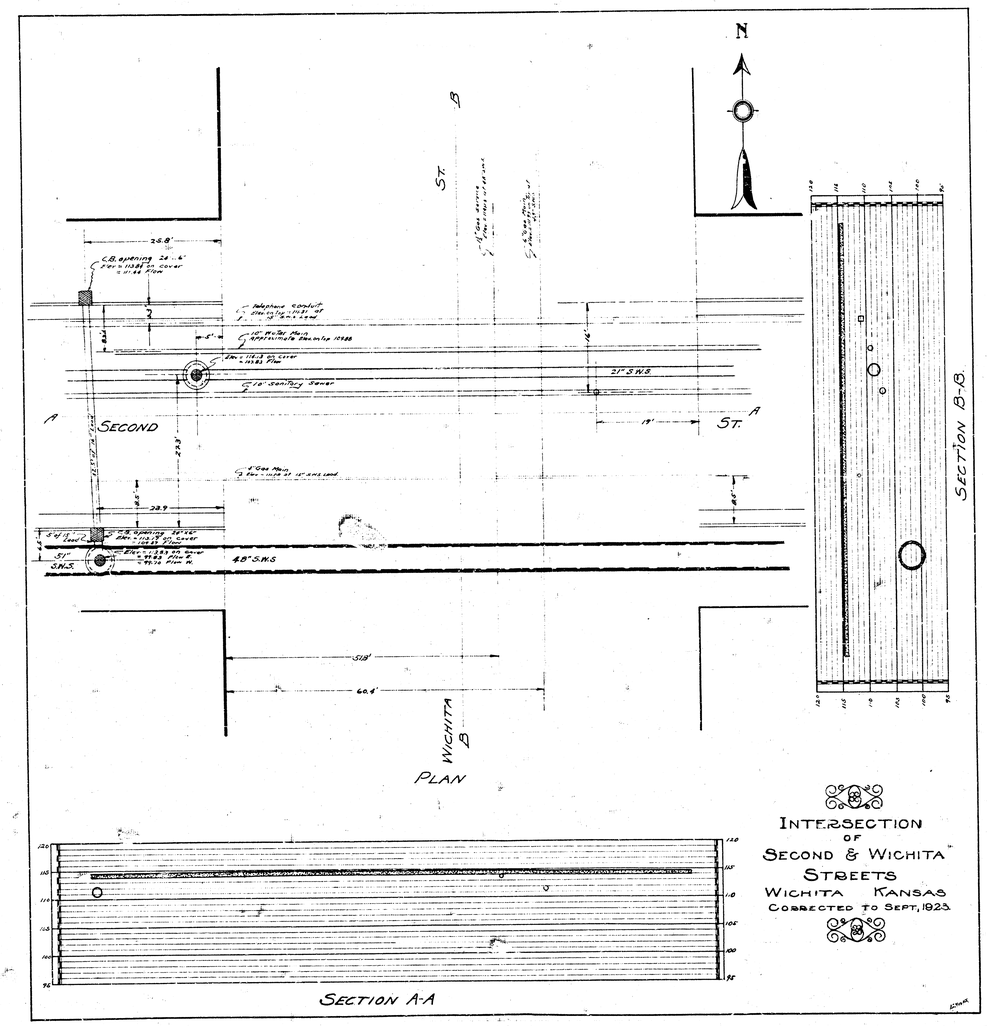
N
ST.
B
SECOND
ST.
A
A
21" S.W.S.
48" S.W.S.
WICHITA
B
PLAN
SECTION B-B
SECTION A-A
INTERSECTION
OF
SECOND & WICHITA
STREETS
WICHITA KANSAS
CORRECTED TO SEPT, 1923