
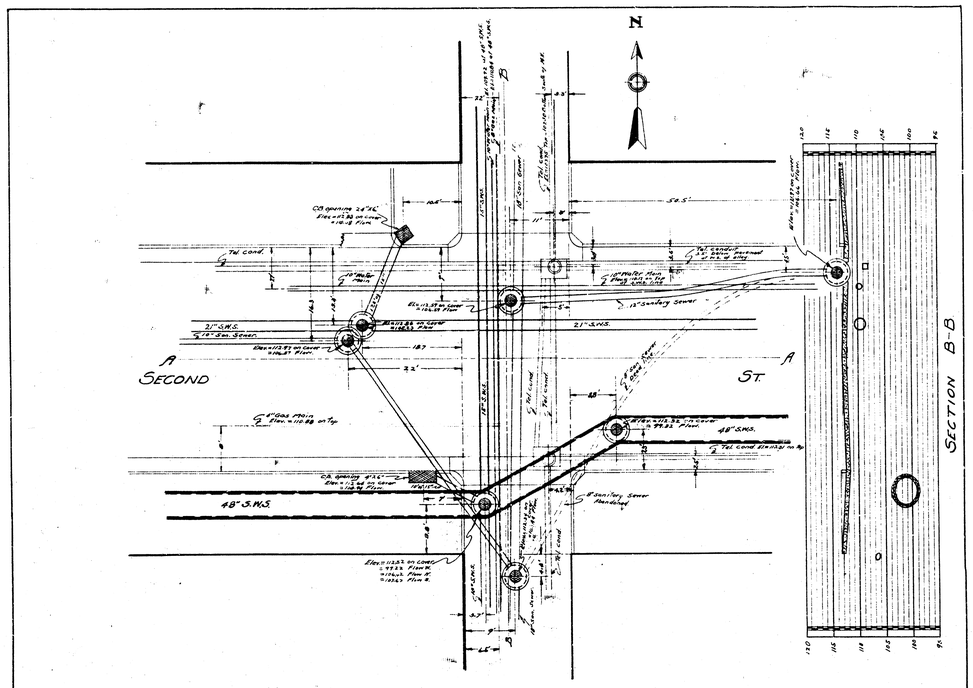


PLAN

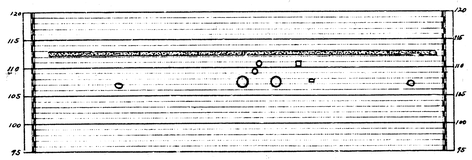

SECTION A-A.

INTERSECTION
OF
SECOND STREET
AND
ALLEY WEST OF WATER
WICHITA KANSAS
CORRECTED TO SEPT. 1923.