
INTERSECTION 2nd & RIDGEWOOD


26' ~~30'~~ Conc. ~~C.G.~~

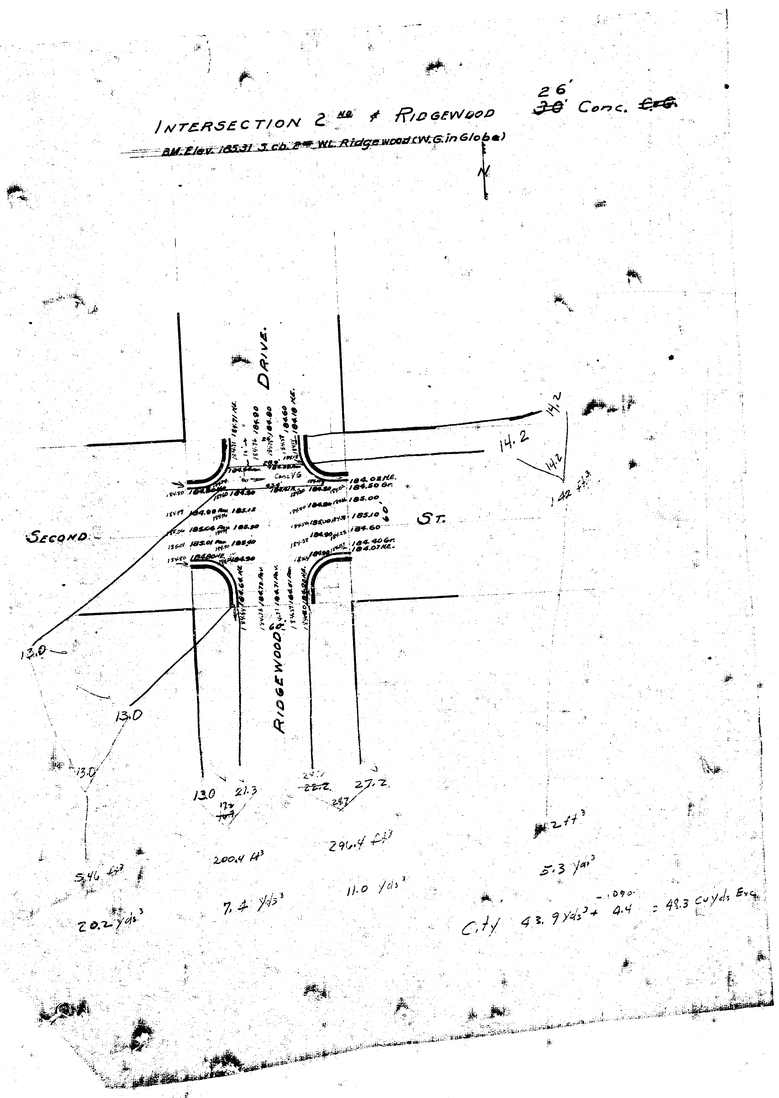

Paving Plan
Intersection
Drive
1940