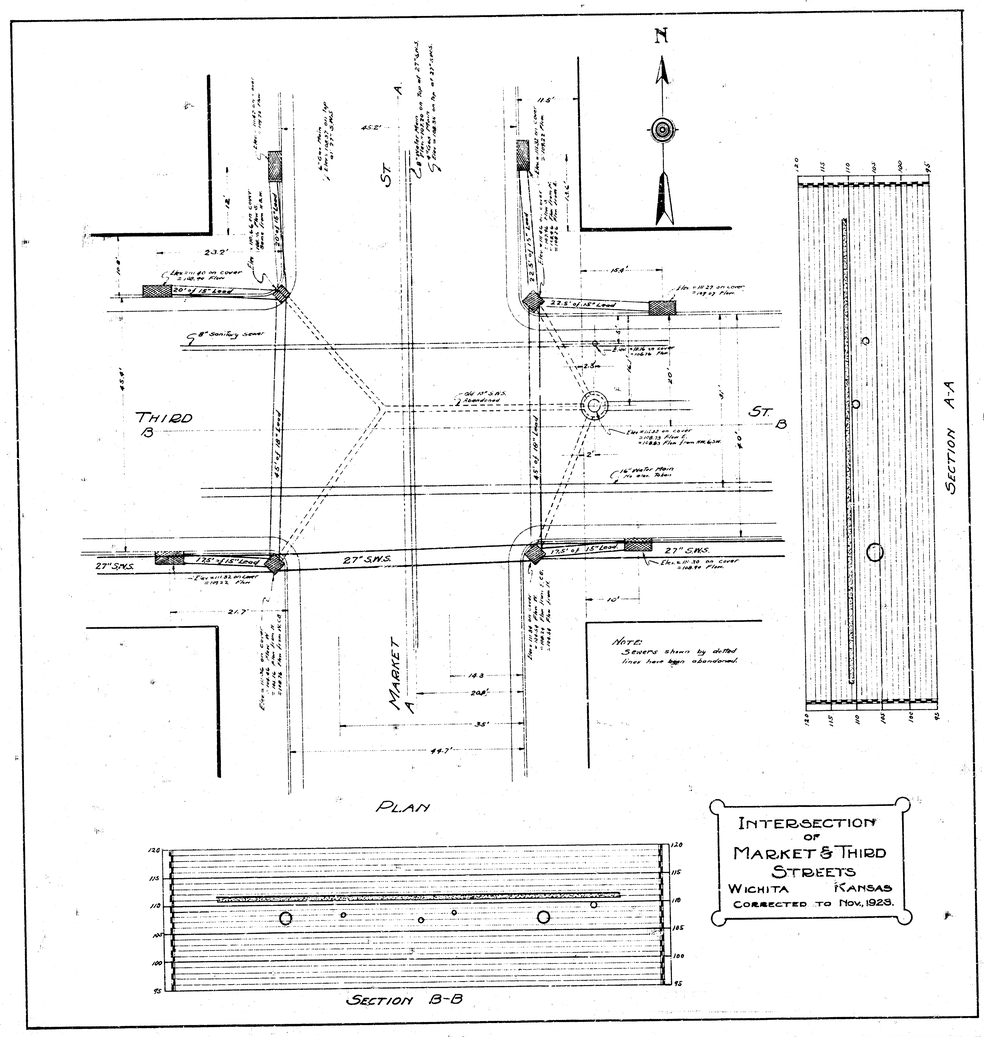

N
THIRD
B
ST.
A
ST.
B
MARKET
A
27" S.W.S.
27" S.W.S.
27" S.W.S.
Sewers shown by dotted lines have been abandoned.
PLAN
SECTION A-A
SECTION B-B
INTERSECTION
OF
MARKET & THIRD
STREETS
WICHITA KANSAS
CORRECTED TO NOV. 1928.