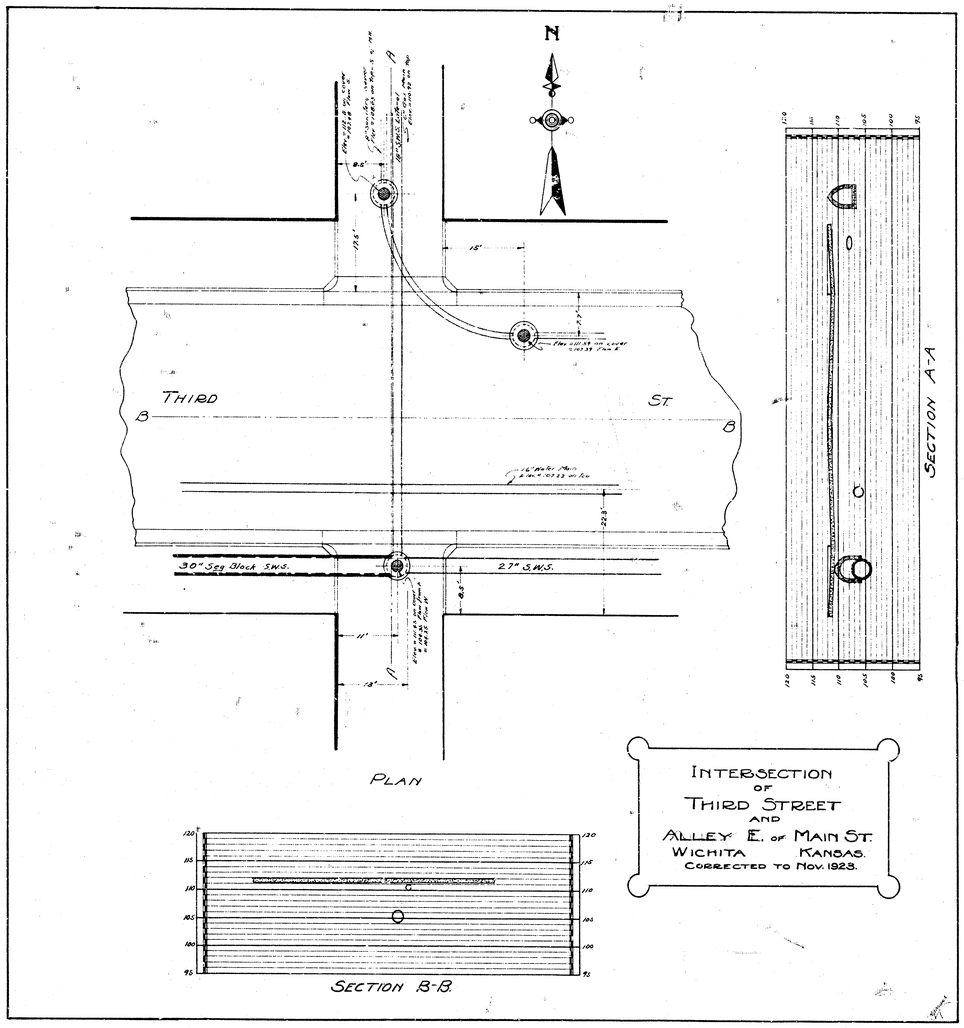
N
THIRD
ST
B
B
30" Seg Block S.W.S.
27" S.W.S.
PLAN
SECTION A-A
SECTION B-B
INTERSECTION
OF
THIRD STREET
AND
ALLEY E. OF MAIN ST.
WICHITA KANSAS.
CORRECTED TO NOV. 1923.