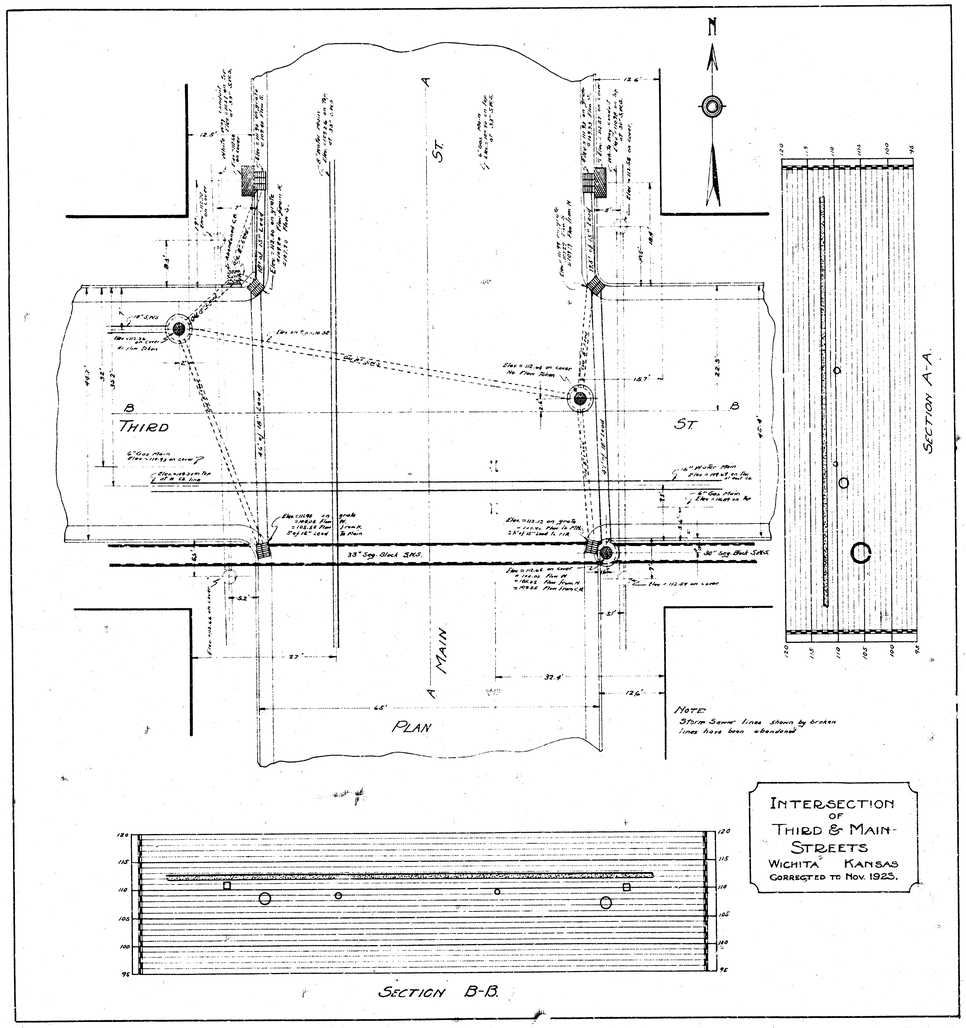


INTERSECTION OF THIRD & MAIN STREETS
WICHITA KANSAS
CORRECTED TO NOV. 1925.