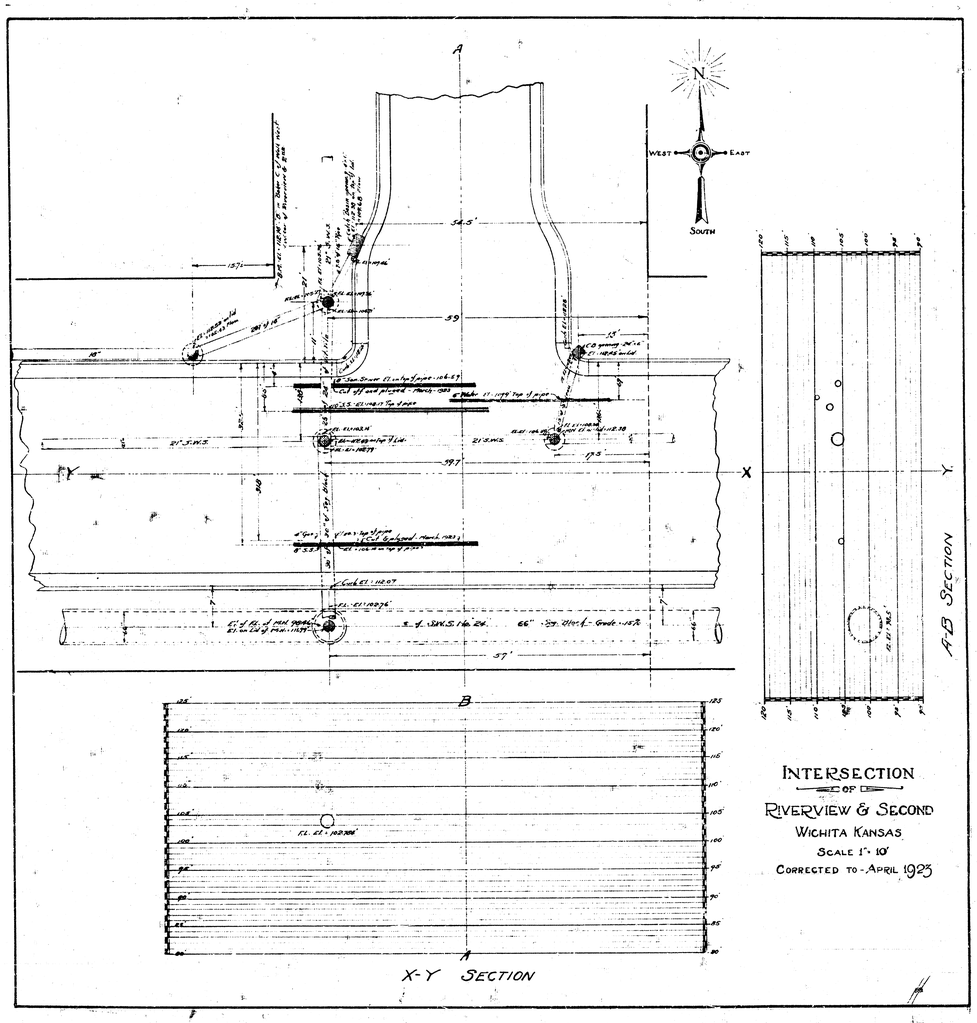

A
B
X
Y
N
WEST
EAST
SOUTH
34.5'
39'
37'
397'
A-B SECTION
X-Y SECTION
INTERSECTION
OF
RIVERVIEW & SECOND
WICHITA KANSAS
SCALE 1" = 10'
CORRECTED TO - APRIL 1925