



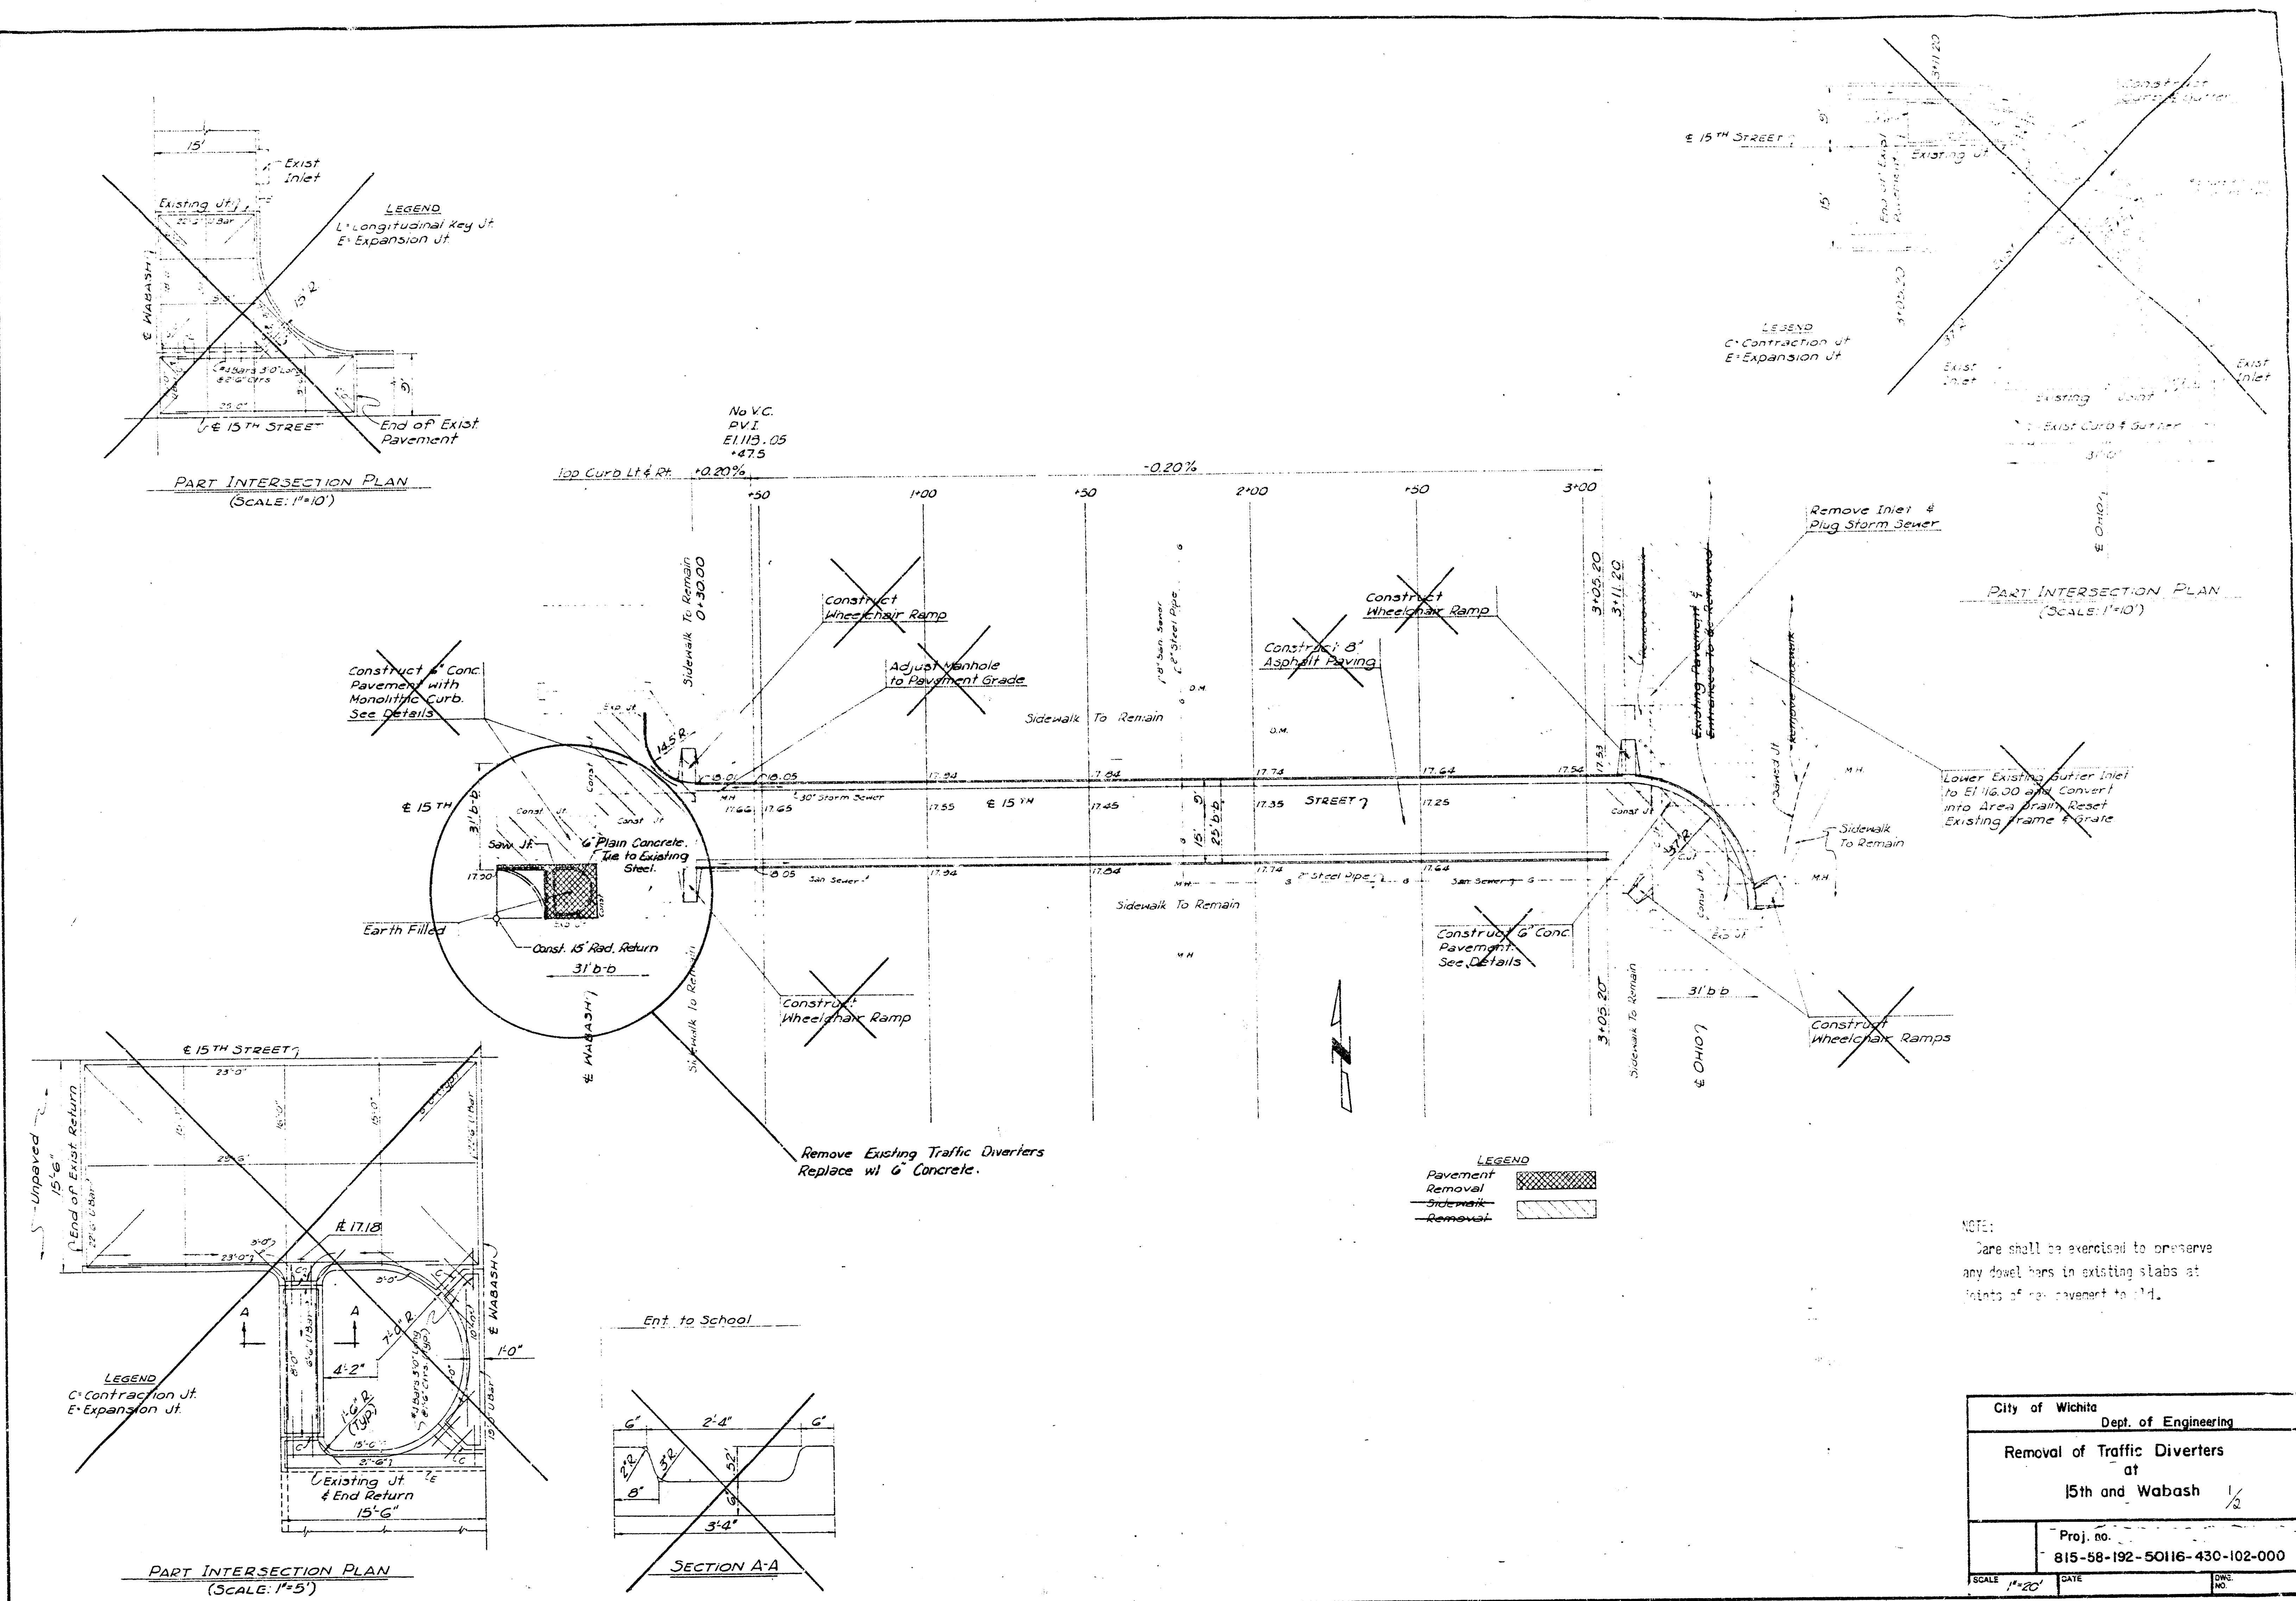

City of Wichita	
Dept. of Engineering	
Removal of Traffic Diverters	
at	
15th and Wabash 1/2	
Proj. No.	
815-58-192-50116-430-102-000	
SCALE 1"=20'	DATE

FILMED FROM THE BEST
AVAILABLE COPY

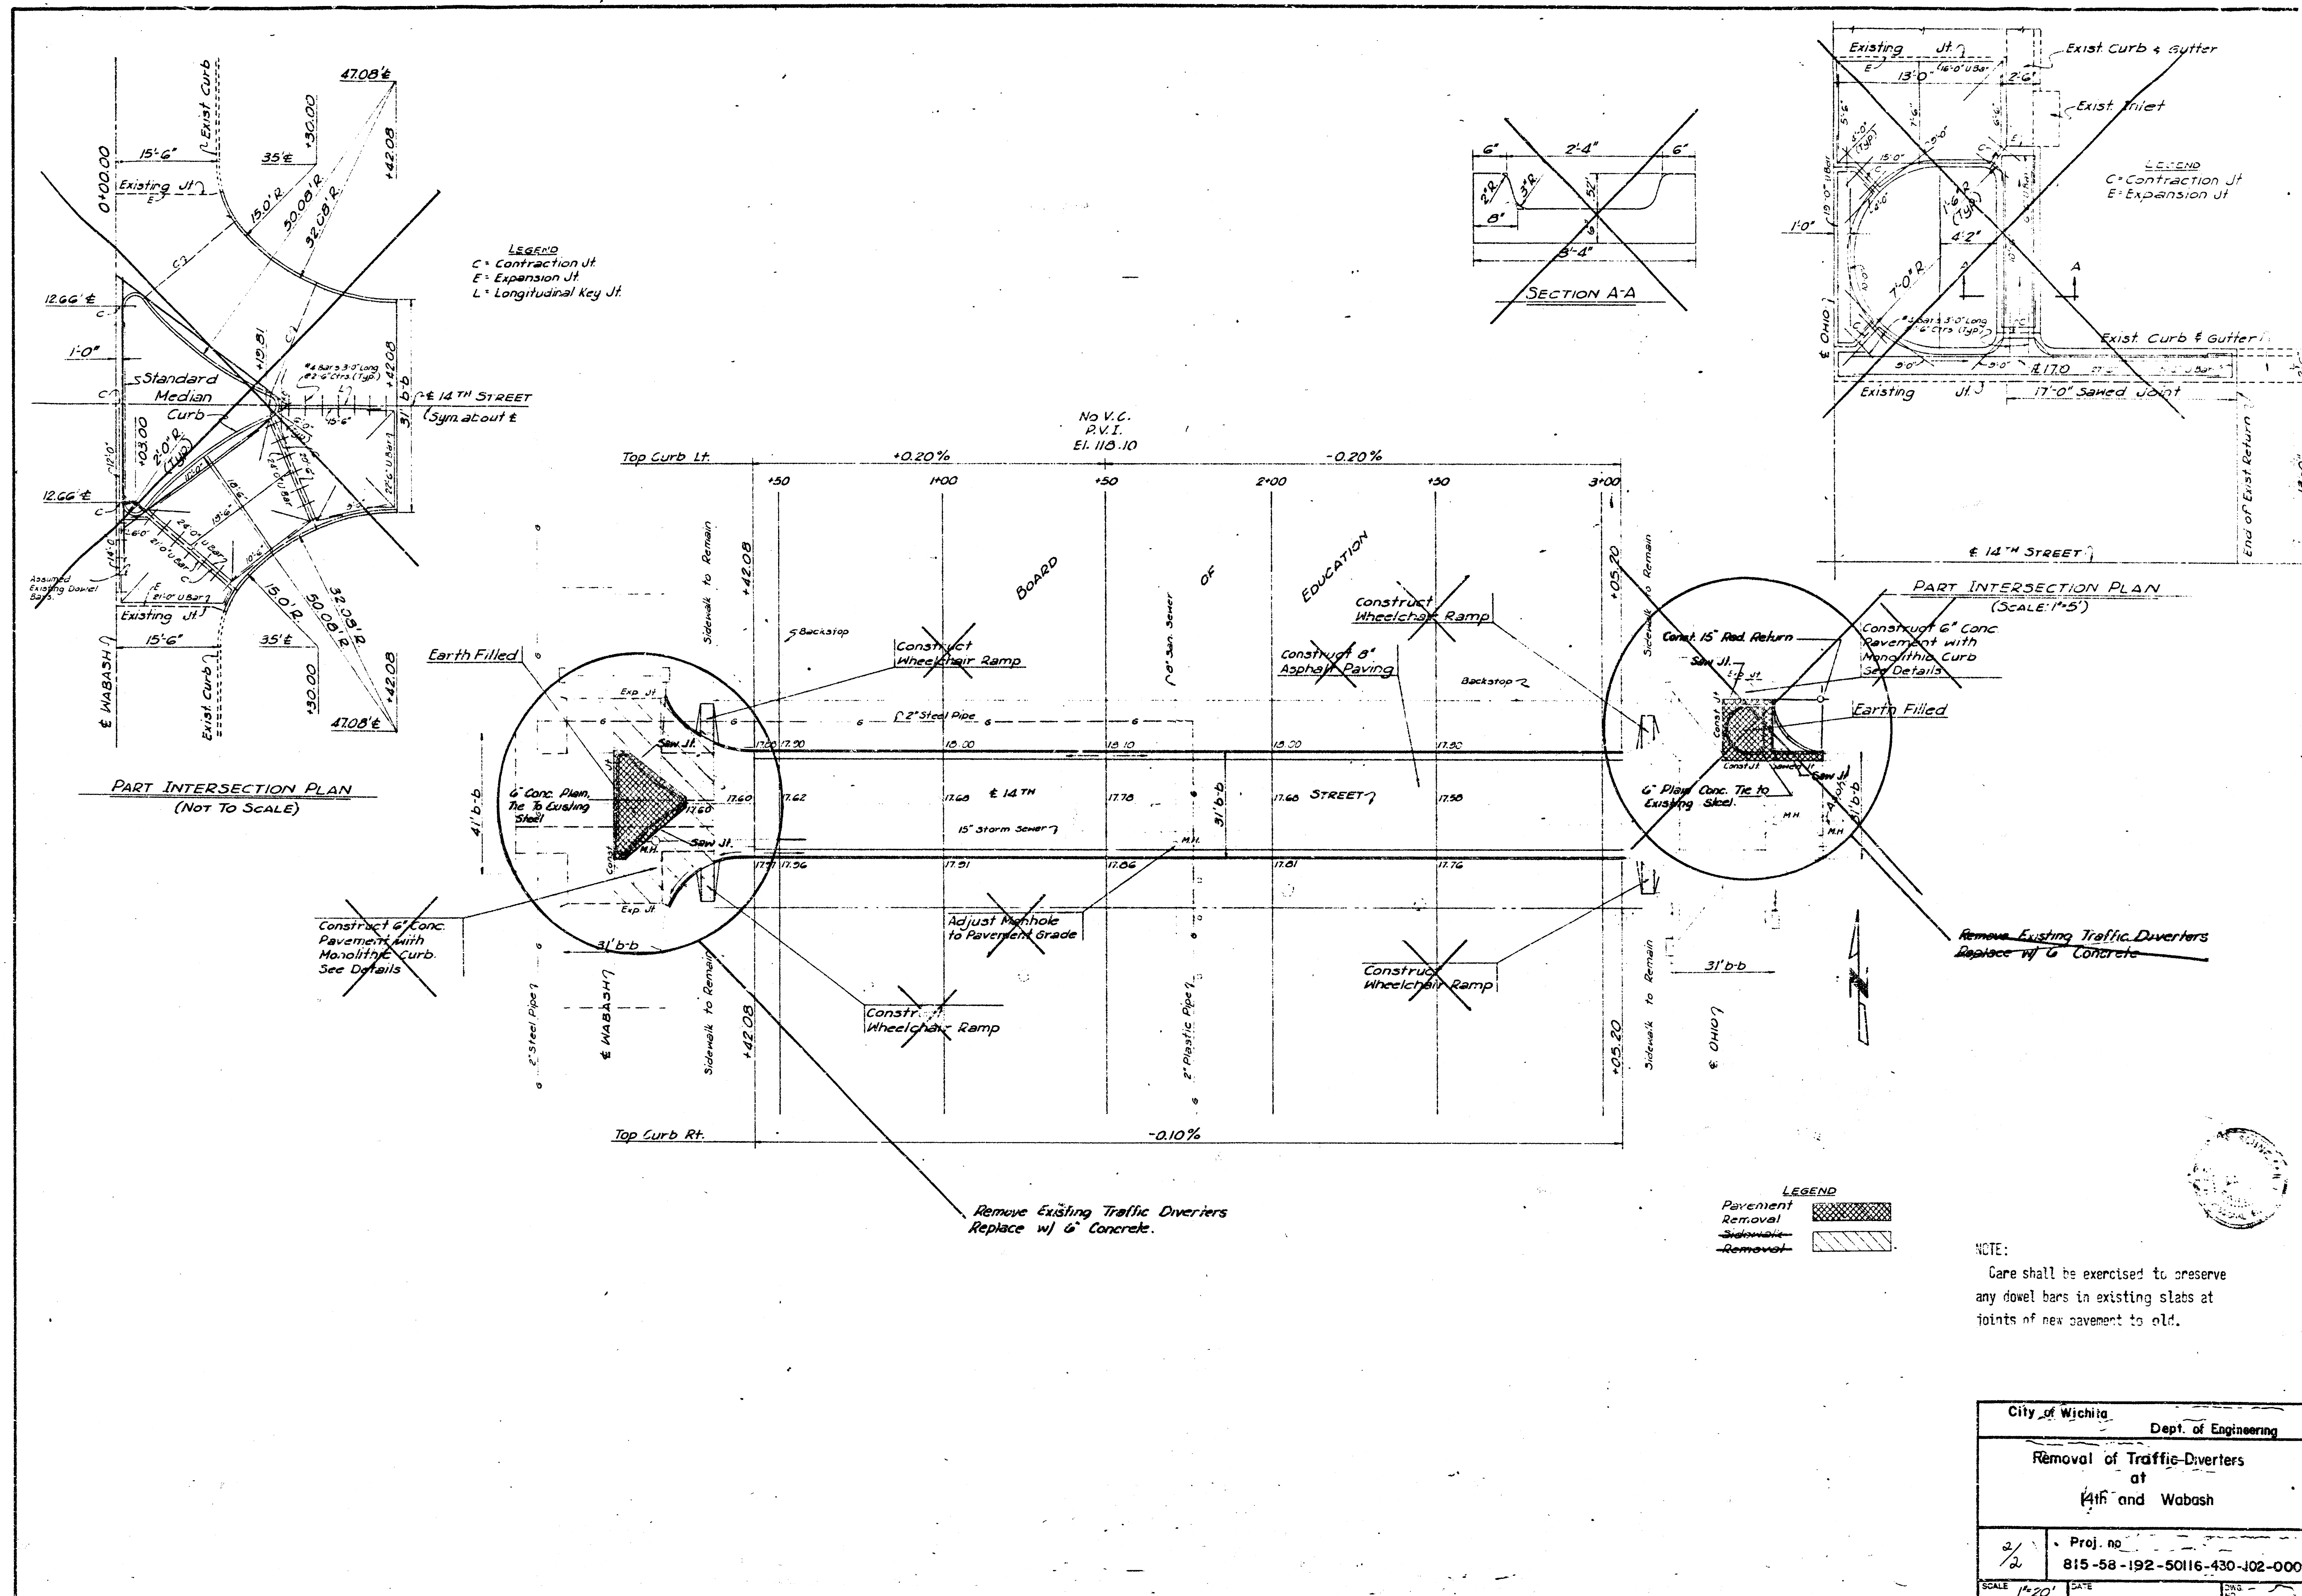

FILMED FROM THE BEST AVAILABLE COPY....