

2000
 90.2
 90.7
 91.2
 102.2
 97.3
 101.5
 108.8
 122.0
 123.8
 154.6
 167.1
 180.3


 1450.7
 + 1090


 1545.8 cu yds.

Grand Total



1595.8		
966.6		
1445.4		
4007.8		


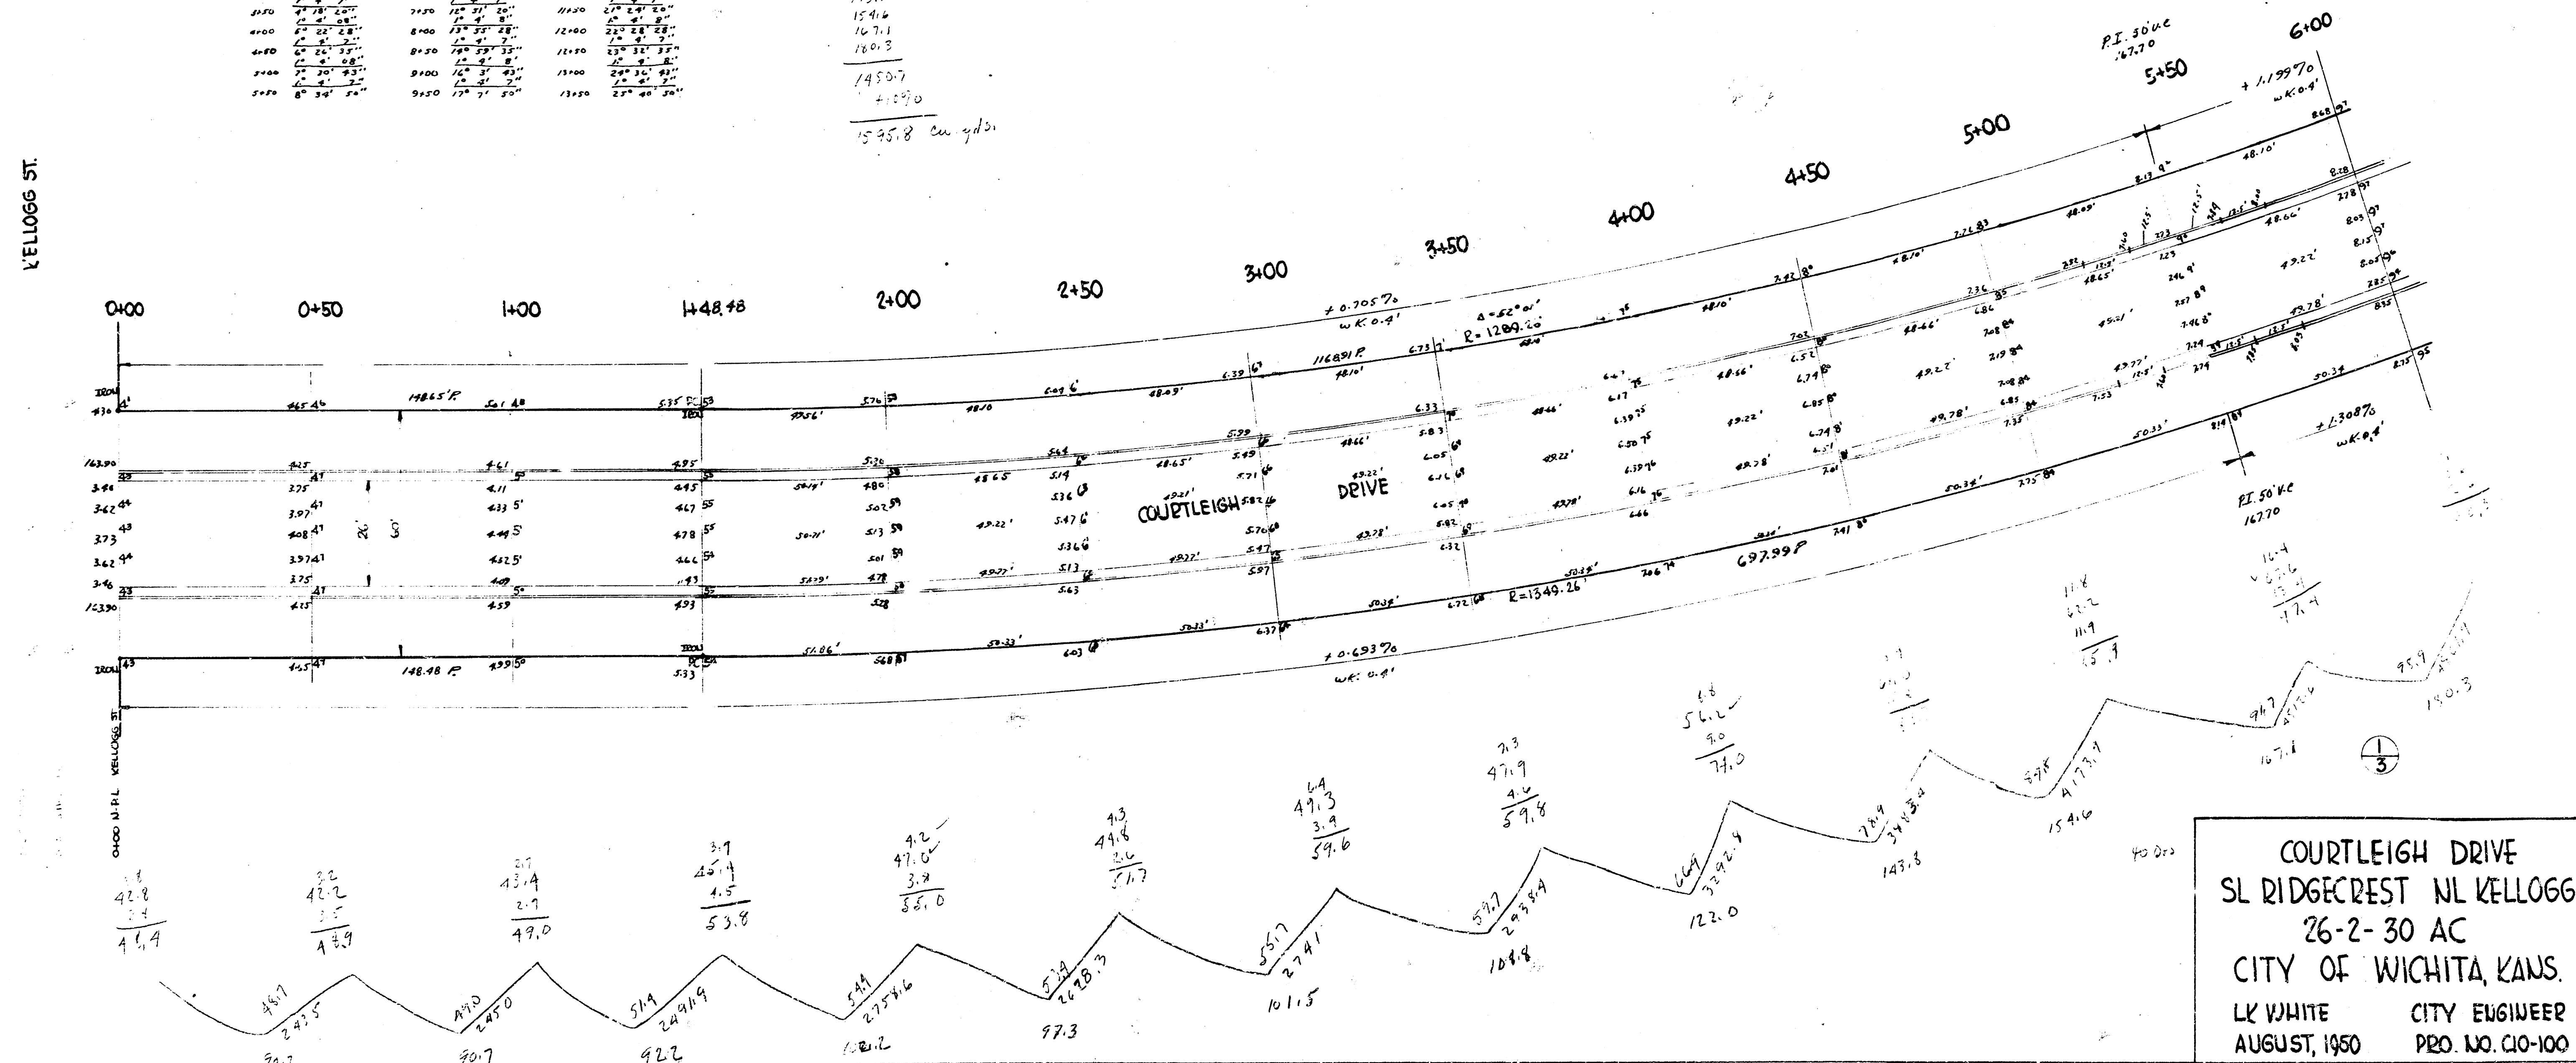

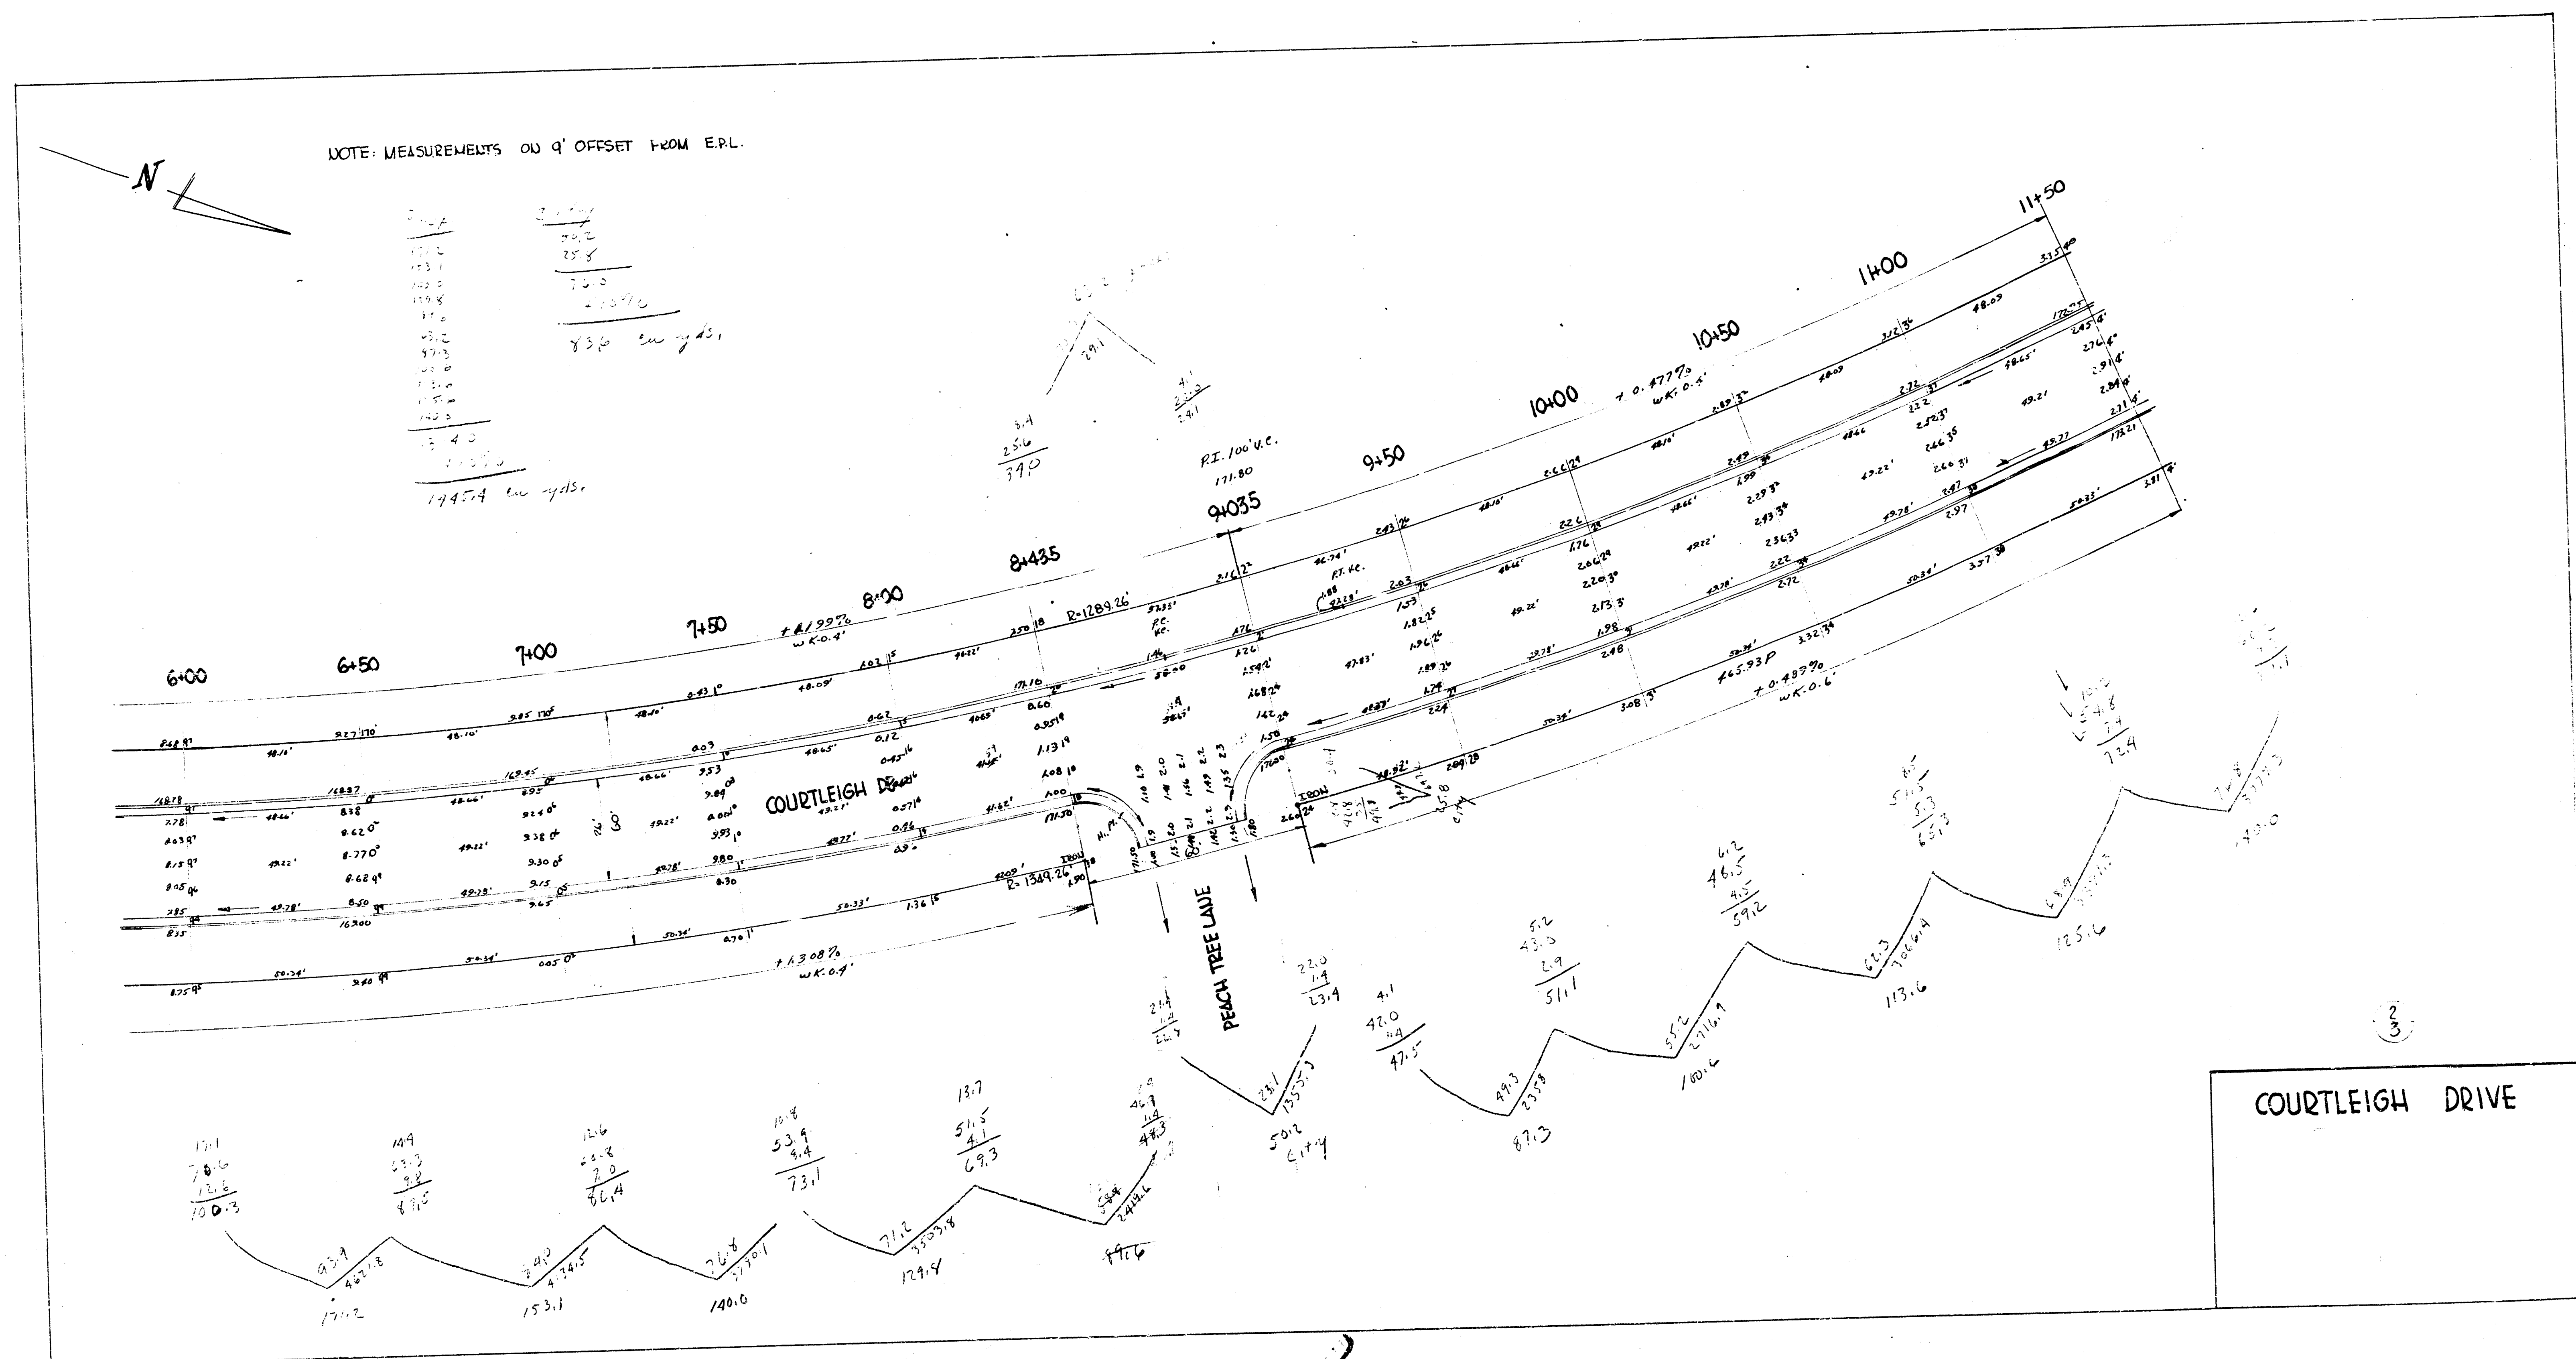

BM 17491 2' U G.T.M.E U.L. RIDGECREST E.C.B. COURTLEIGH DR
 NOTE: MEASUREMENTS ON 'Q' OFFSET FROM E.P.L.

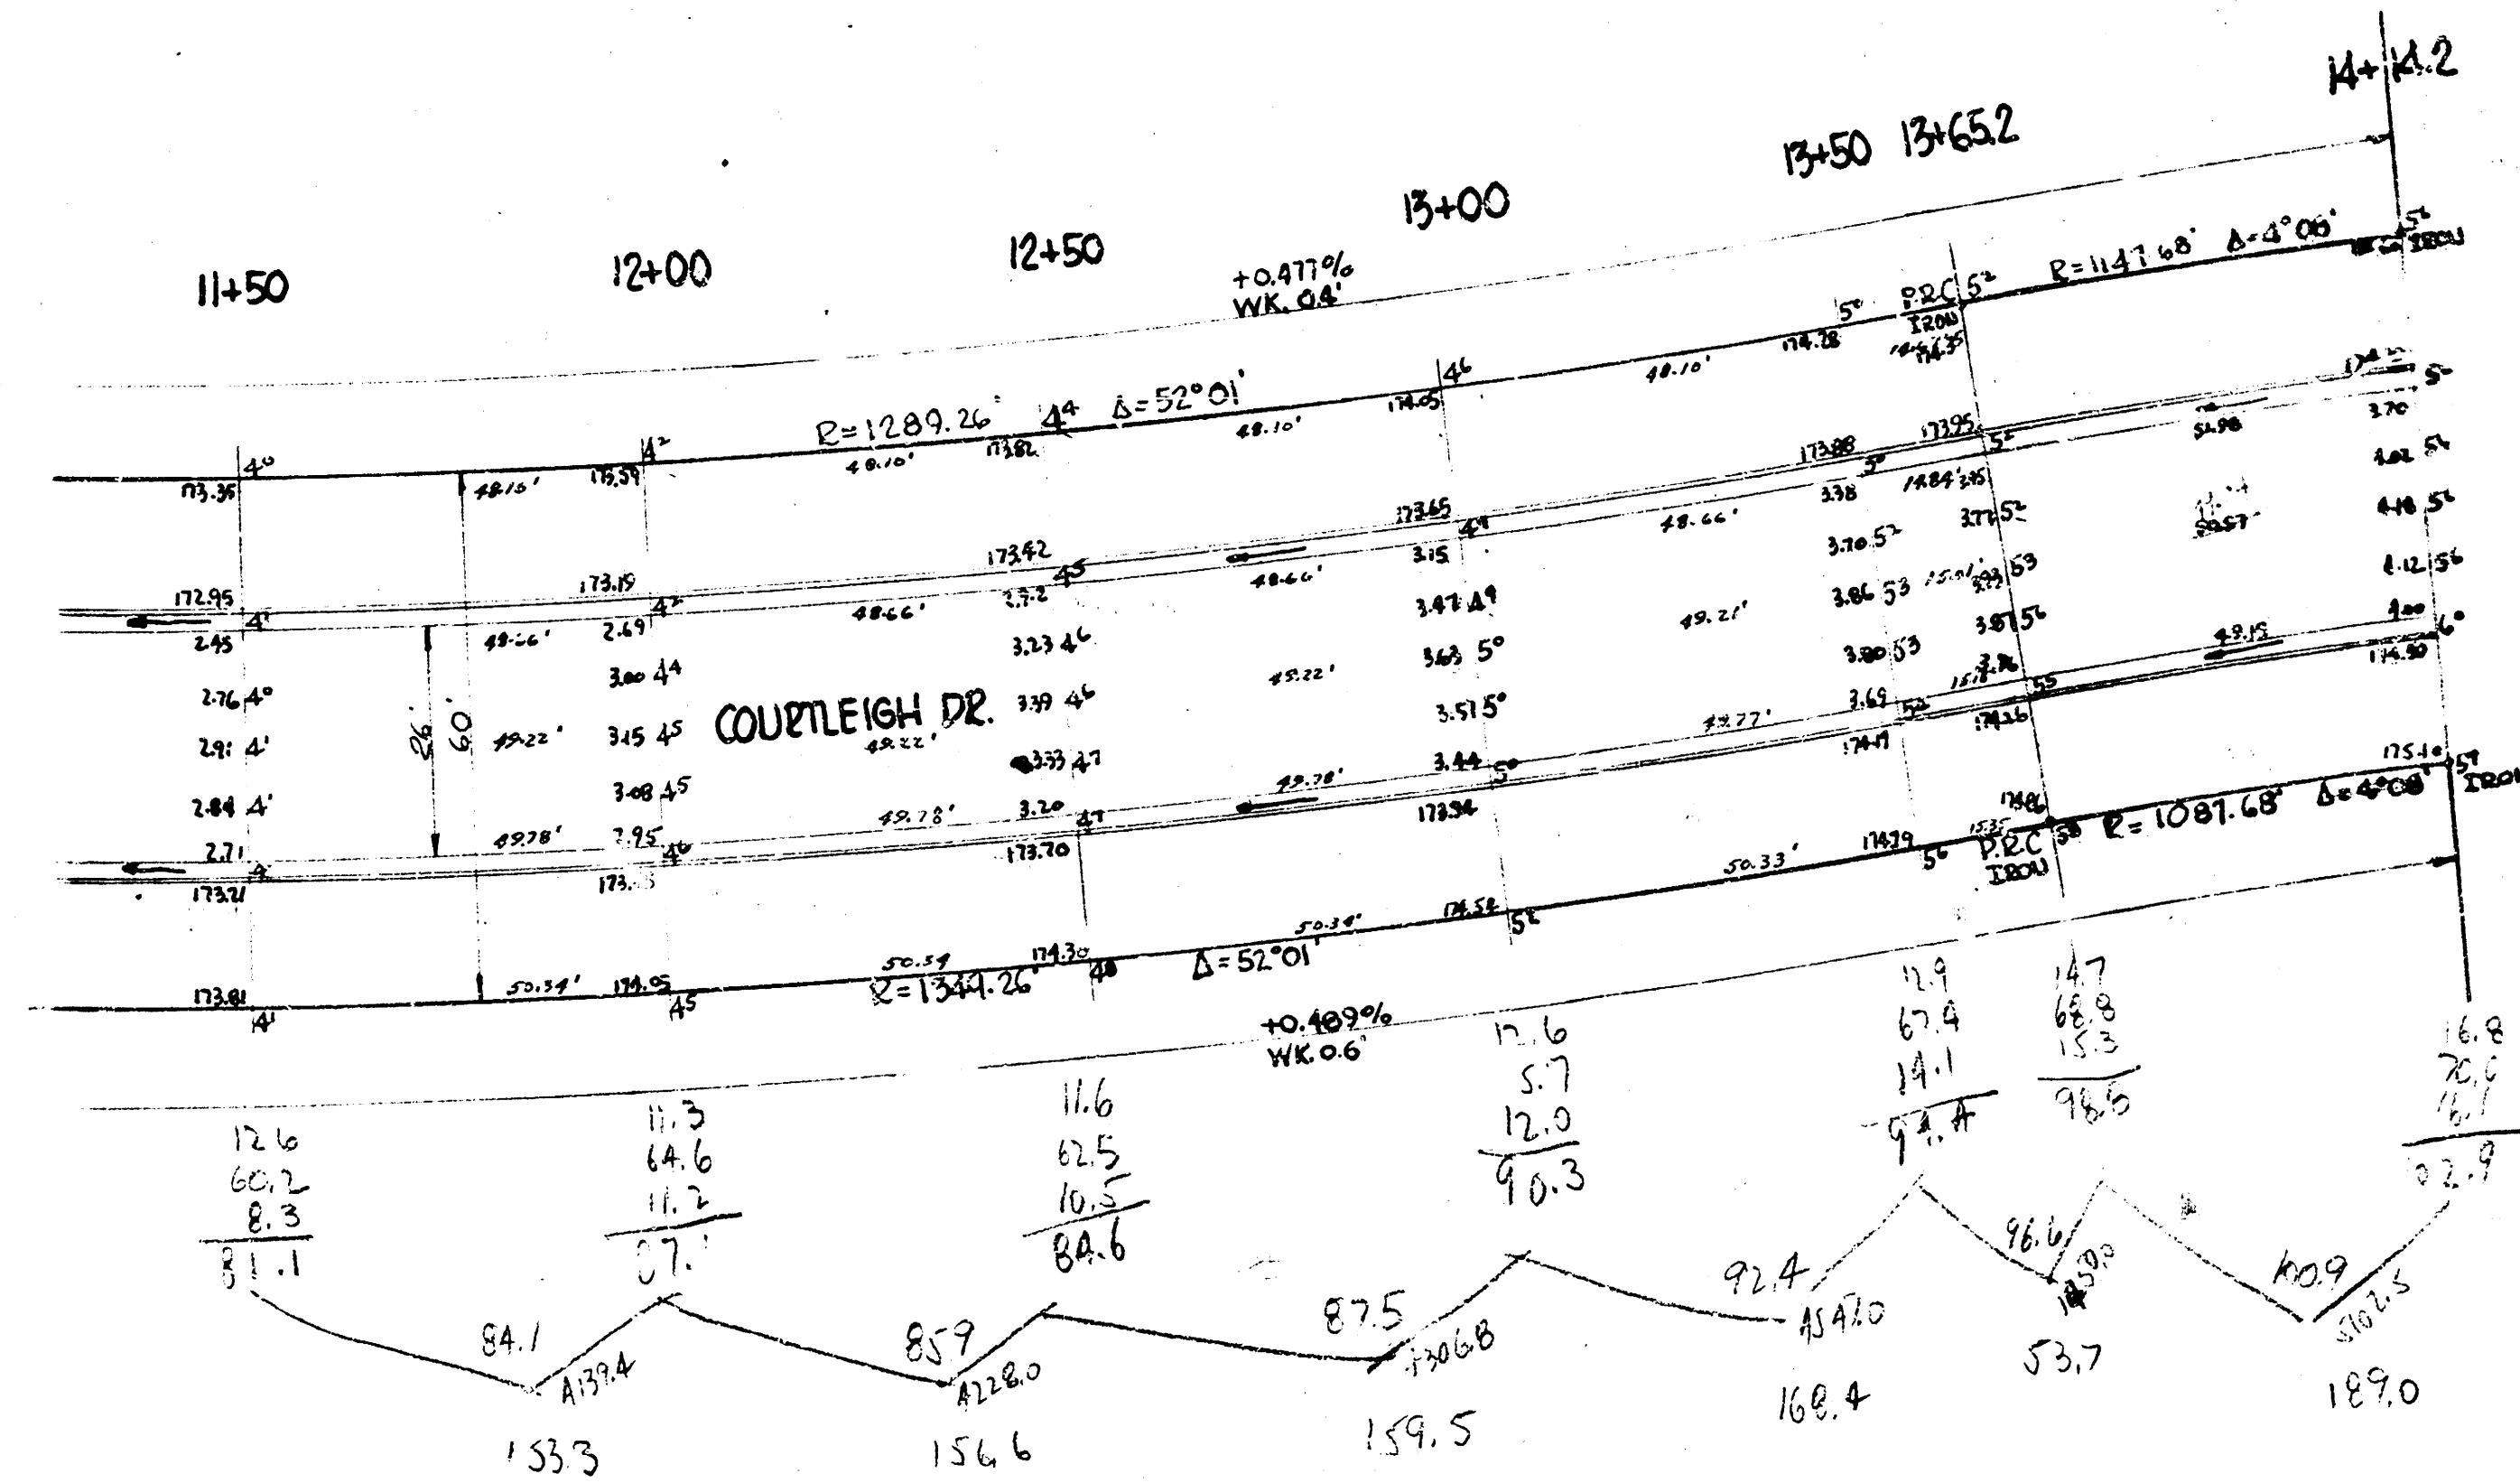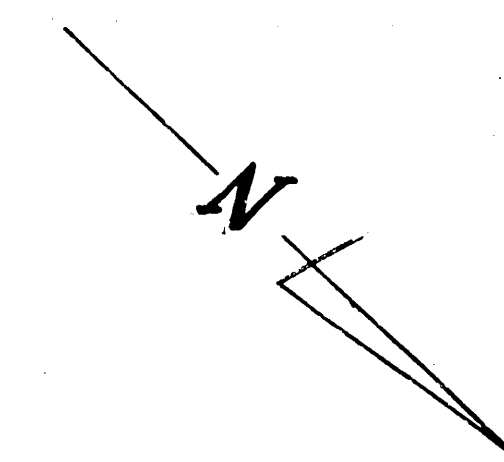

RIDGECREST ROAD

153.3
 173.4
 178.5
 168.4
 153.7
 158.0
 650.5
 4.00
 962.5

COURTLEIGH DRIVE