


SCALE 1" = 2'

 

APPROVED AS NOTED  
By CITY ENGINEER OF WICHITA

Sanitary Sewers \_\_\_\_\_  
Storm Sewers \_\_\_\_\_  
Drainway Approaches \_\_\_\_\_  
Water Mains \_\_\_\_\_  
Ditches C.P.D. 3-6-86

A circular professional engineer seal for N. Brent Wooten. The outer ring contains the text "N. BRENT WOOTEN" at the top and "PROFESSIONAL ENGINEER" at the bottom. Inside this ring, the word "LICENSED" is at the top and "KANSAS" is at the bottom. In the center of the seal is the license number "5470".

**BAUGHMAN COMPANY, P.A.**  
SURVEYING & ENGINEERING

**FILMED FROM THE BEST  
AVAILABLE COPY .....**