NOTE: CONTRACTOR TO CLEAR RIGHT-OF-WAY, GRADE PARKING, & COMPACT FILL IN SIDEWALK AREAS. SIDEWALK TO BE CONSTRUCTED BY "OTHERS."

NOTE: INLETS & STORM SEWER TO BE CONSTRUCTED BY "OTHERS" PRIOR TO CONSTRUCTION OF THIS PROJECT.

NOTE: FIELD ENGINEER SHALL DETERMINE WHICH PORTIONS ARE TO HAVE LIME TREATED SUB-GRADE AND WHICH ARE TO BE SUB-GRADE MODIFIED.

NOTE: ALL EXCESS EXCAVATION FROM THIS PROJECT SHALL BE STOCKPILED AT LOCATIONS DETERMINED BY THE ENGINEER, IN WESTLINK VILLAGE TENTH ADDITION.

NOTE: ROLL-TYPE COMB. CURB & GUTTER TO BE USED THROUGHOUT PROJECT, EXCEPT AS NOTED.

NOTE: TRANSITION FROM FULL CURB & GTR. TO ROLL CURB & GTR. SHALL BE PAID AS LIN. FT. COMB. CURB & GUTTER.

NOTE: BASELINE = ℄ CRESTLINE CIRCLE.

NOTE: SANITARY SEWER TO BE CONSTRUCTED BY "OTHERS" PRIOR TO CONSTRUCTION OF THIS PROJECT.

CURVE DATA BASED ON ℄ RADIUS = 150.00'
Δ = 18° 28'
11.4591 Min/ft ARC.

STATION	ARC	CHORD 8' off to M. curb	LENGTH 8' off to L. curb	DEFLECTION	TOTAL DEFLECTION
p.c. 2181.05					0° 00' 00"
3105.22	24.17'	20.44'	27.85'	4° 37'	4° 37'
p.t. 3129.40'	24.18'	20.44'	27.85'	4° 37'	9° 14'

CURVE DATA BASED ON ℄ RADIUS = 149.93'
Δ = 18° 56'
11.4645 Min/ft ARC.

STATION	ARC	CHORD 8' off to M. curb	LENGTH 8' off to L. curb	DEFLECTION	TOTAL DEFLECTION
p.c. 3163.87'					0° 00' 00"
3188.64'	24.77'	28.54'	20.95'	4° 44'	4° 44'
p.t. 4113.41	24.77'	28.54'	20.95'	4° 44'	9° 28'

SCALE 1" = 20'

B.M. 151.858 ~ R.R. SPK. N.E. FACE P.P. 25 FT. SOUTH & 7 FT. WEST OF IRON N.W. COR. LOT 1 BLK. 8

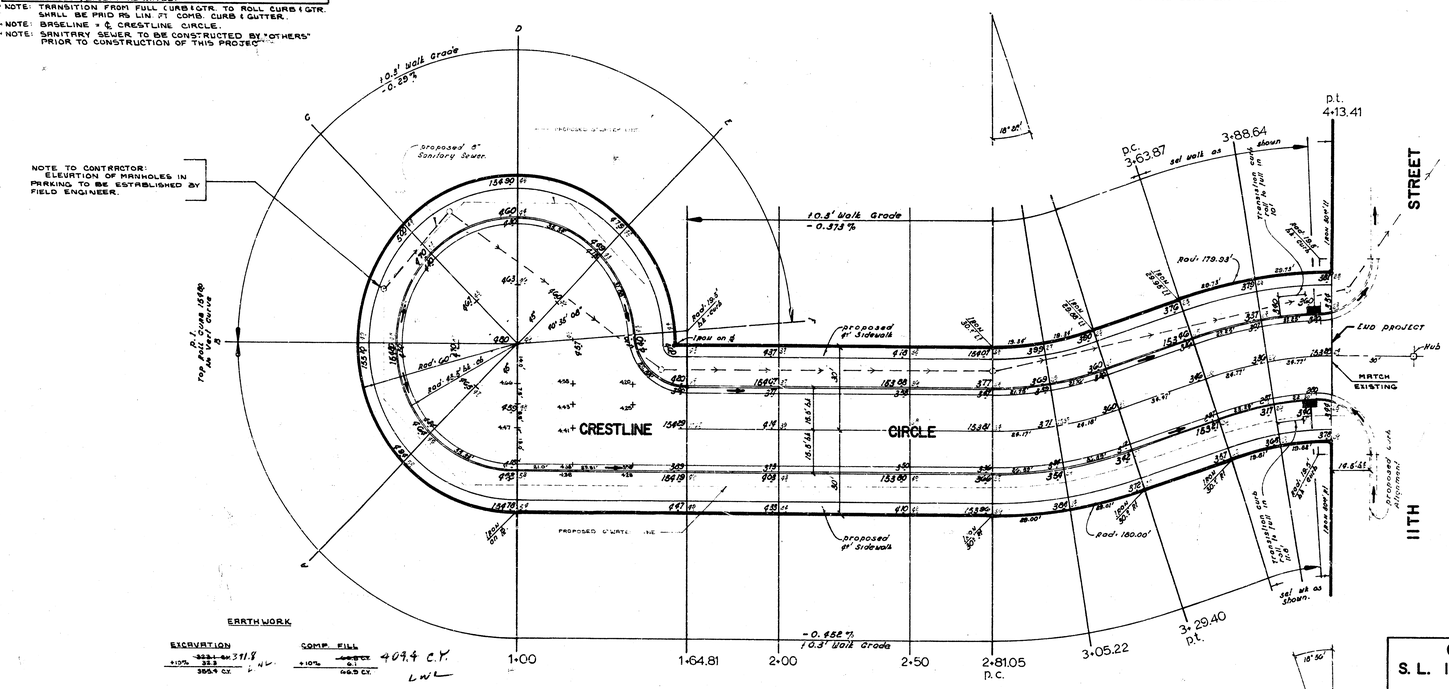

EARTHWORK

EXCAVATION
+10% 331.8 / 32.3 / 365.4 C.Y. LWL

COMP. FILL
+10% 409.4 C.Y. / 6.1 / 46.5 C.Y. LWL

CRESTLINE CIRCLE
S. L. IITH ST. TO & INCLUDING CUL-DE-SAC
ASPHALTIC CONCRETE PAVEMENT
31'B-B (Roll Type Comb Curb & Gtr.)
CITY OF WICHITA, KANSAS
R. W. LINN CITY ENGINEER
PROJ. NO. DAKS 572034
DATE:

1/3