
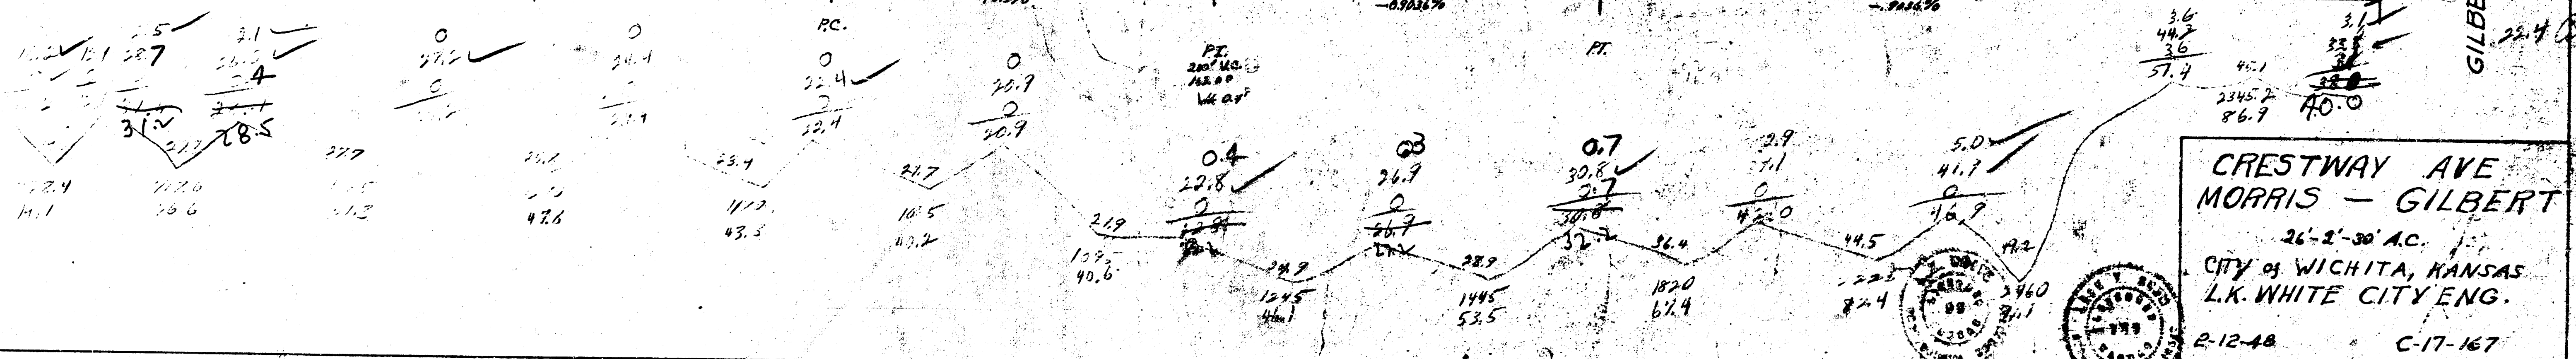


Book Jy 20

Property
 14.1
 26.6

City
CH. 104.00 5th Cr. Conc. Park NE. Cr. Gilbert & Crestway

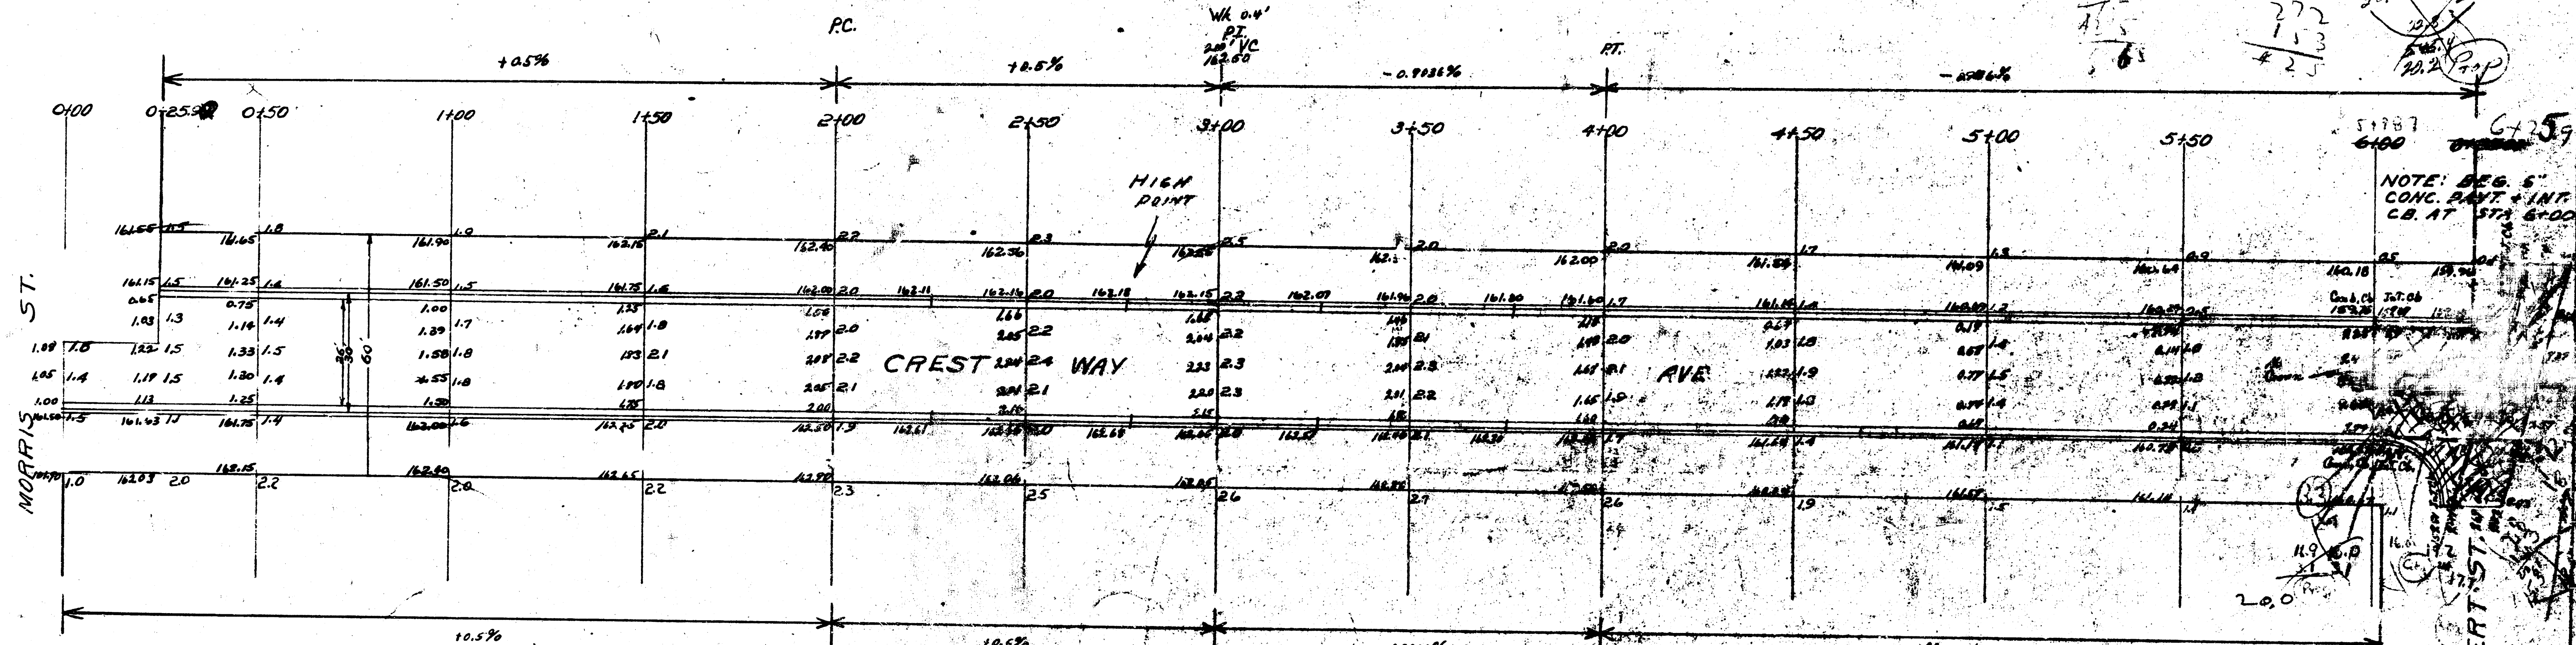

CRESTWAY AVE
MORRIS - GILBERT
26'-2'-30' A.C.
CITY OF WICHITA, KANSAS
L.K. WHITE CITY ENG.
R-12-48 C-17-167