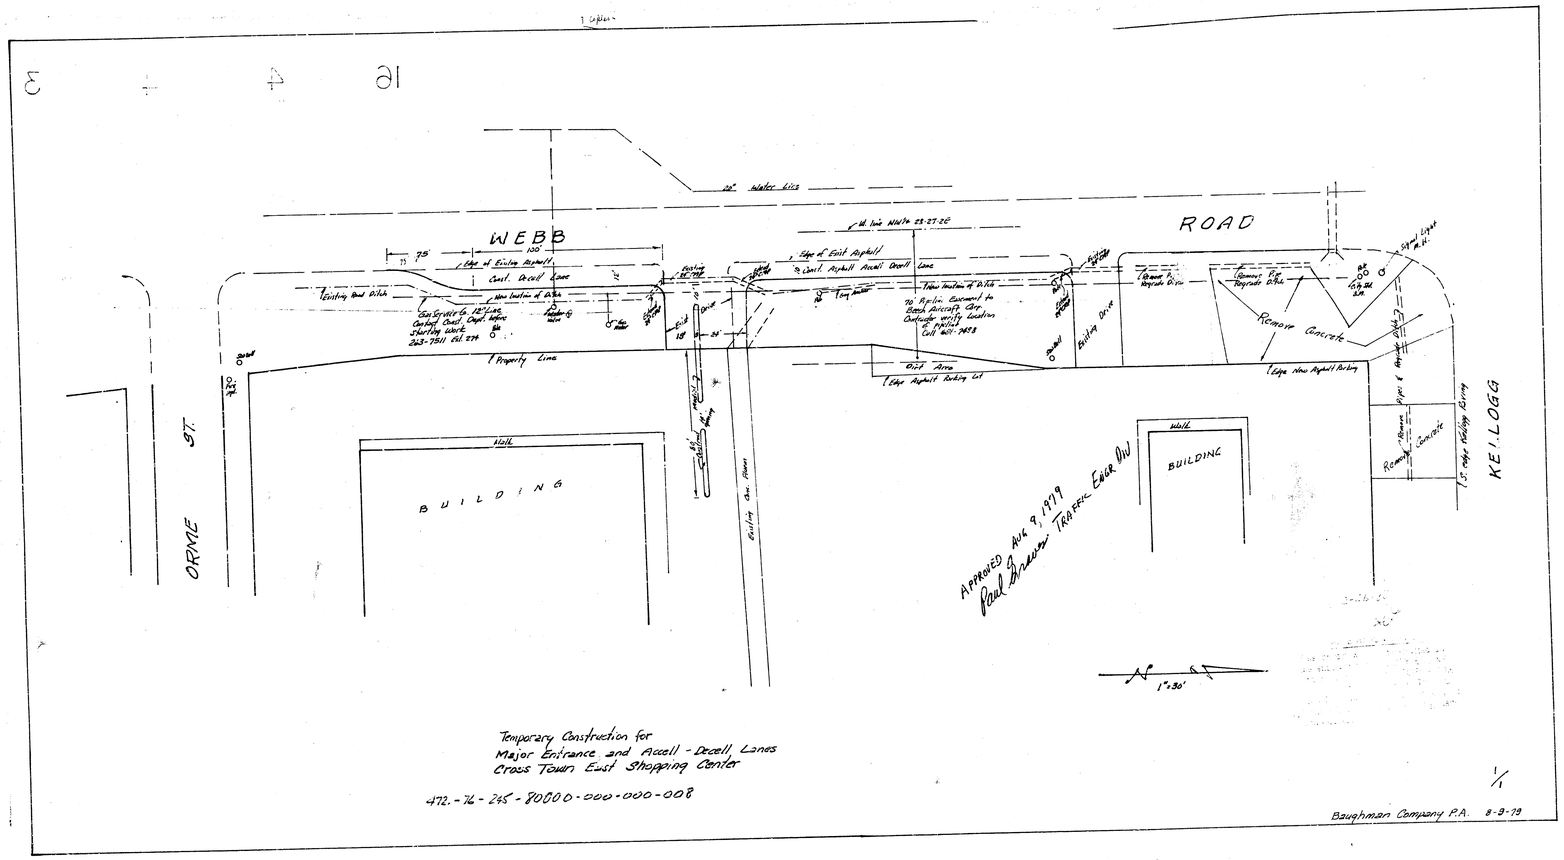
WEBB
ROAD
ORME ST.
KELLOGG
BUILDING
BUILDING
Remove Concrete
Remove Concrete
Remove Concrete
Remove Fire Hydrants Drive
Remove Hydrants Drive
Edge of Existing Asphalt
Const. Decell Lane
Edge of Exist Asphalt
Const. Asphalt Accell Decell Lane
Existing Road Ditch
New Location of Ditch
Property Line
Edge Asphalt Parking Lot
Edge New Asphalt Parking
Dirt Area
Building Drive
Building Conc. Floors
Walk
Walk
Existing Drive
Existing Drive
Existing Hydrant
Signal Light
Signal Light
Car Service Co. 123 Line
Contact Const. Dept. before
Starting Work
263-7511 Ext 274
To Aplin Easement to
Back Aircraft Corp.
Contact verify location
& Marked
Call 269-7488
Temp. Location of Ditch
Long Meter
Existing Ditch
