




B.M. 122.19 S.W. COR. OF CONC. PORCH TO HOUSE AT 1004 N. CUSTER  
 B.L. IS C.L. CUSTER

SCALE 1/2"=20'

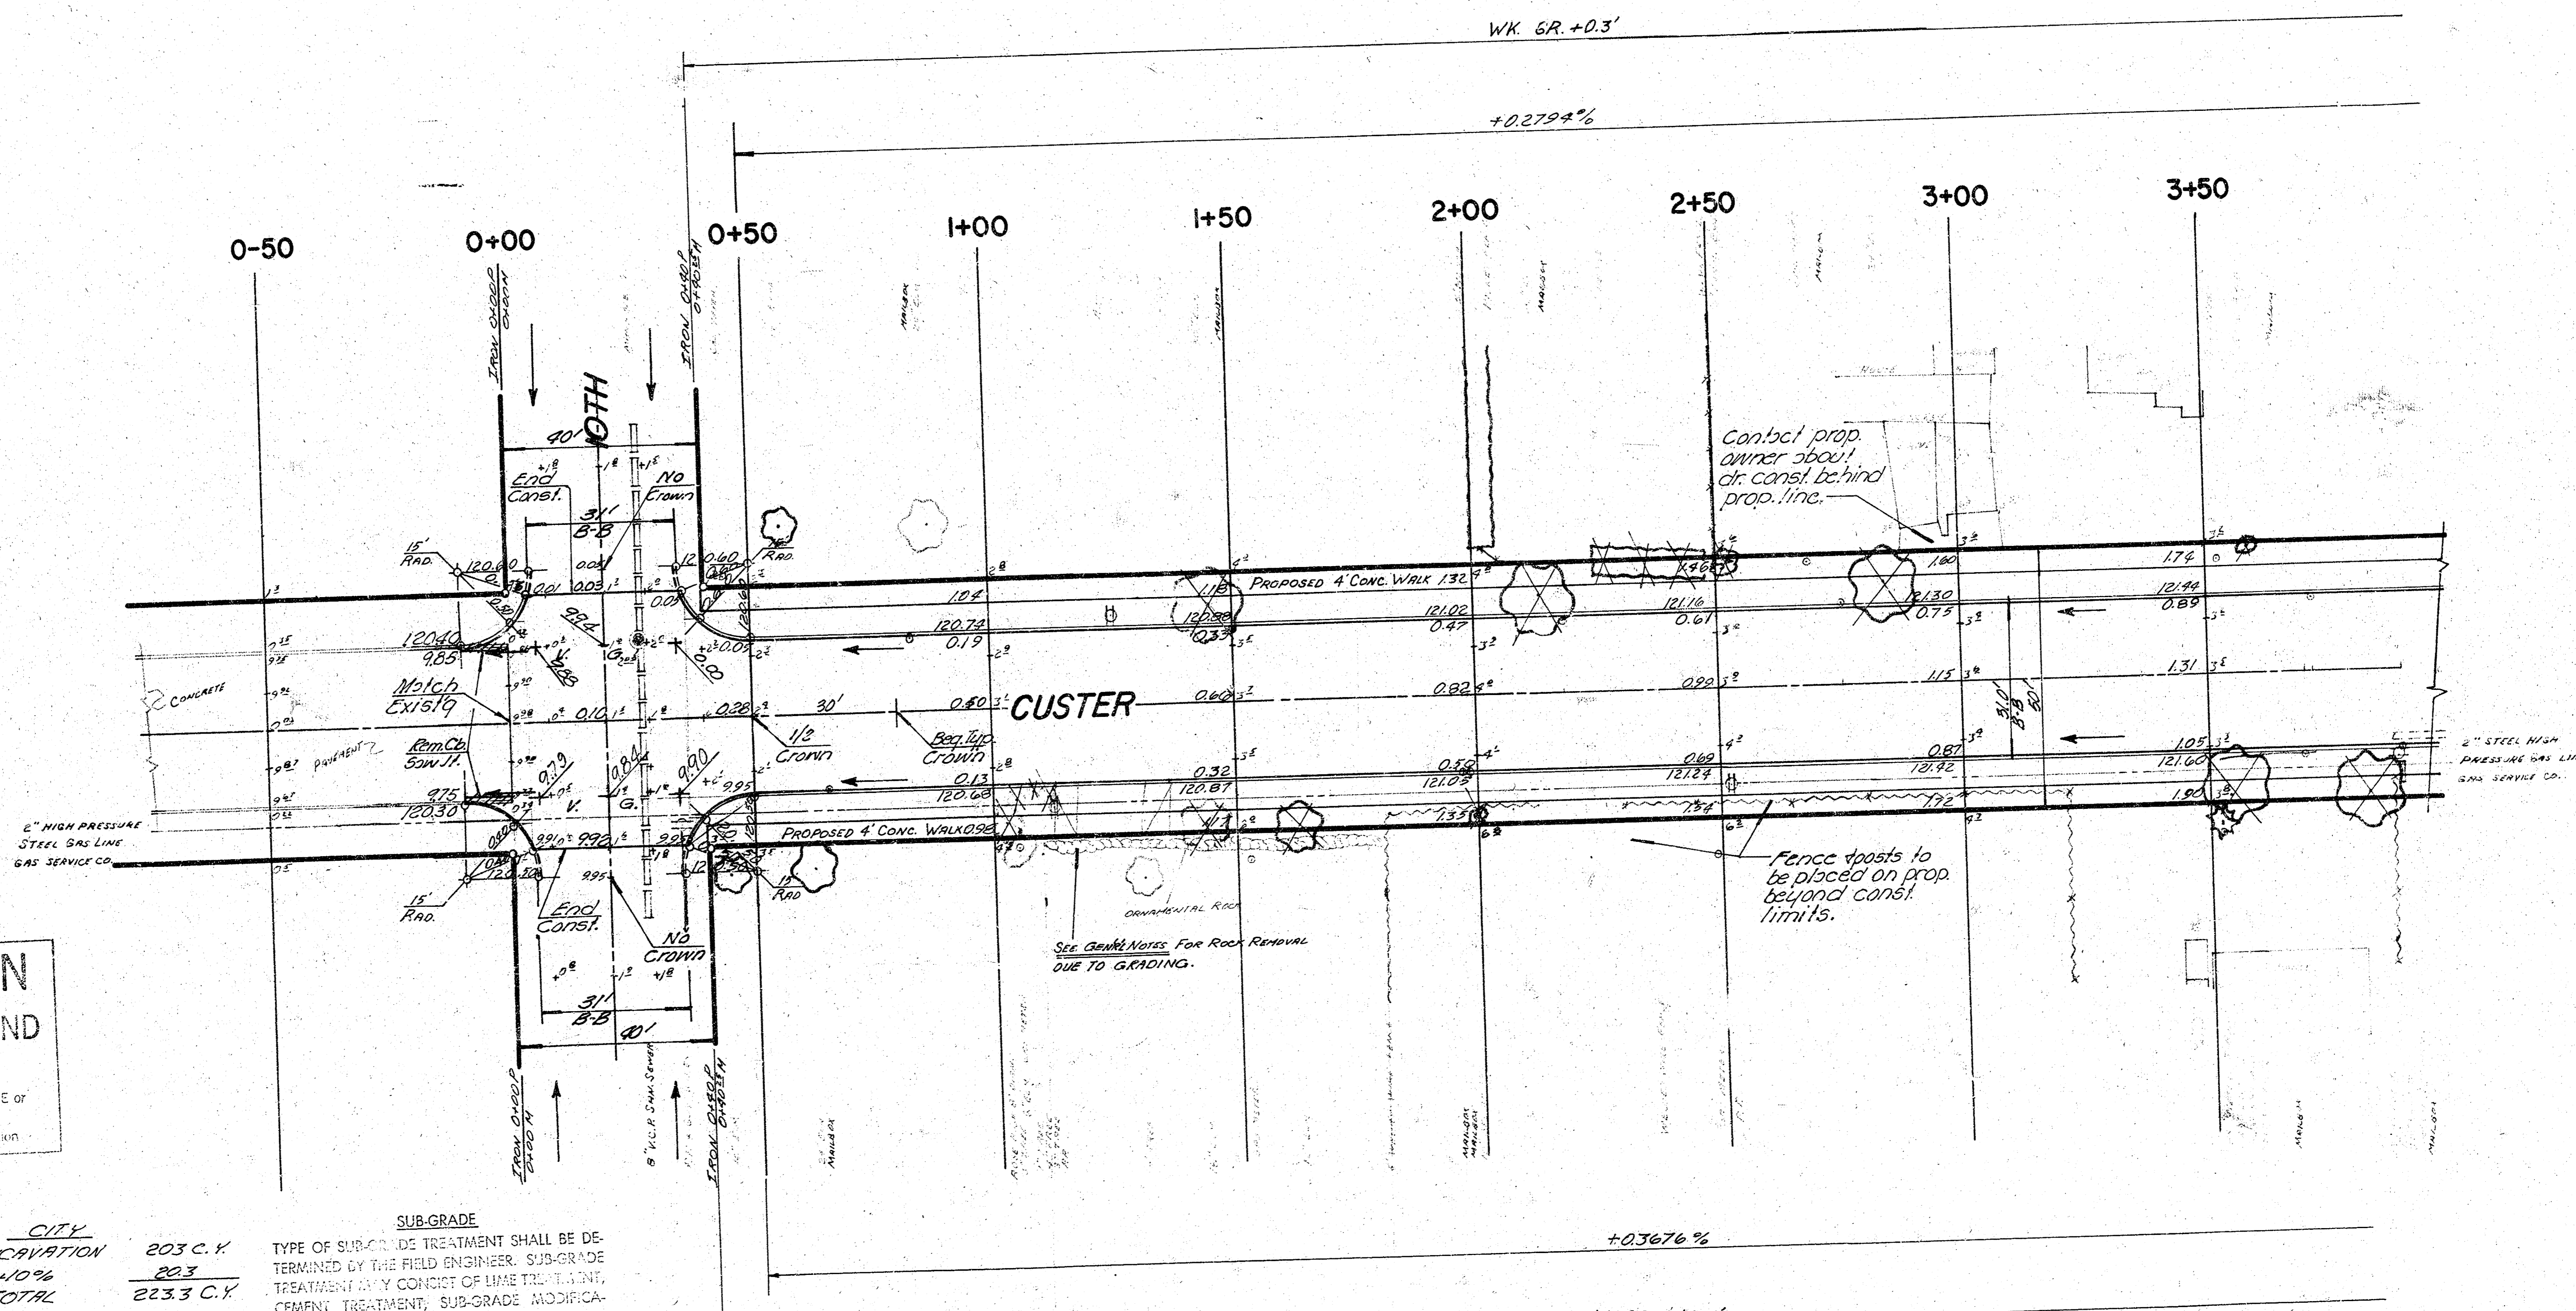

**CAUTION**  
**UNDERGROUND UTILITIES**  
 Please check with R.G. & E. of Southwestern Bell Telephone Co. for location.

PROPERTY		CITY	
EXCAVATION	3285.5 C.Y.	EXCAVATION	203 C.Y.
10%	328.5	10%	20.3
<b>TOTAL</b>	<b>3614.0 C.Y.</b>	<b>TOTAL</b>	<b>223.3 C.Y.</b>

**SUB-GRADE**  
 TYPE OF SUB-GRADE TREATMENT SHALL BE DETERMINED BY THE FIELD ENGINEER. SUB-GRADE TREATMENT MAY CONSIST OF LIME TREATMENT, CEMENT TREATMENT, SUB-GRADE MODIFICATION, OR ANY COMBINATION OF THESE.

**TREE REMOVAL** (See General Notes)

**GENERAL NOTES**

1. PARKINGS TO BE GRADED AS PER CROSS-SECTIONS. GROUND BEHIND PROPERTY LINE TO BE GRADED ON 3:1 SLOPE. IN AREAS SHOWN ON CROSS-SECTIONS, FIELD ENGINEER TO CROSS-SECTION BEFORE AND AFTER.
  2. PROPERTY OWNERS TO BE CONTACTED FOR DISPOSITION OF SMALL ORNAMENTAL SHRUBS & BUSHES.
  3. ALL MAILBOXES ARE TO BE REMOVED AND REPLACED BEHIND NEW CURB.
  4. ORNAMENTAL ROCK BETWEEN STA 1+80 AND STA 1+80 IS TO BE REMOVED AND STORED ON PROPERTY. PROPERTY OWNER TO BE CONTACTED FOR STORAGE LOCATION. COST TO BE INCIDENTAL TO PROJECT.
  5. Trees to remain in parkings unless they interfere w/ dry canal or grading. (See parking grading.)
- (\*) Property Consent must be obtained before grading behind R/W Line.



CUSTER AVE  
 DAKS574034

2/3

SURVEY DIVISION  
 Plan Department  
 Ex. Department  
 CHICAGO

B.M. 122.19 S.W. CORNER OF CONCRETE PORCH TO HOUSE AT 1004 N. CUSTER  
 B.L. IS C.L. CUSTER

Scale  
 1" = 20'

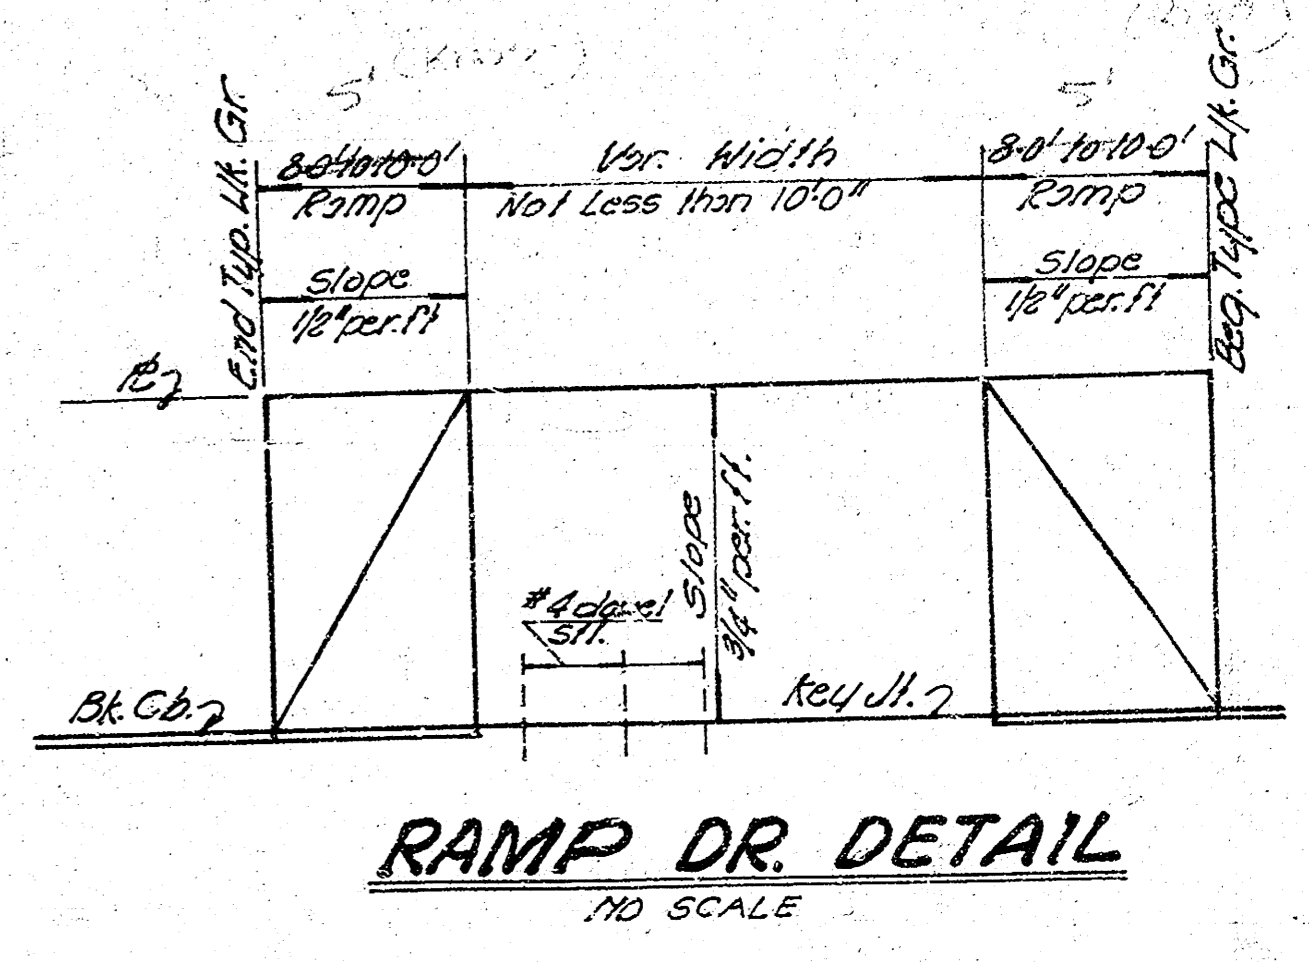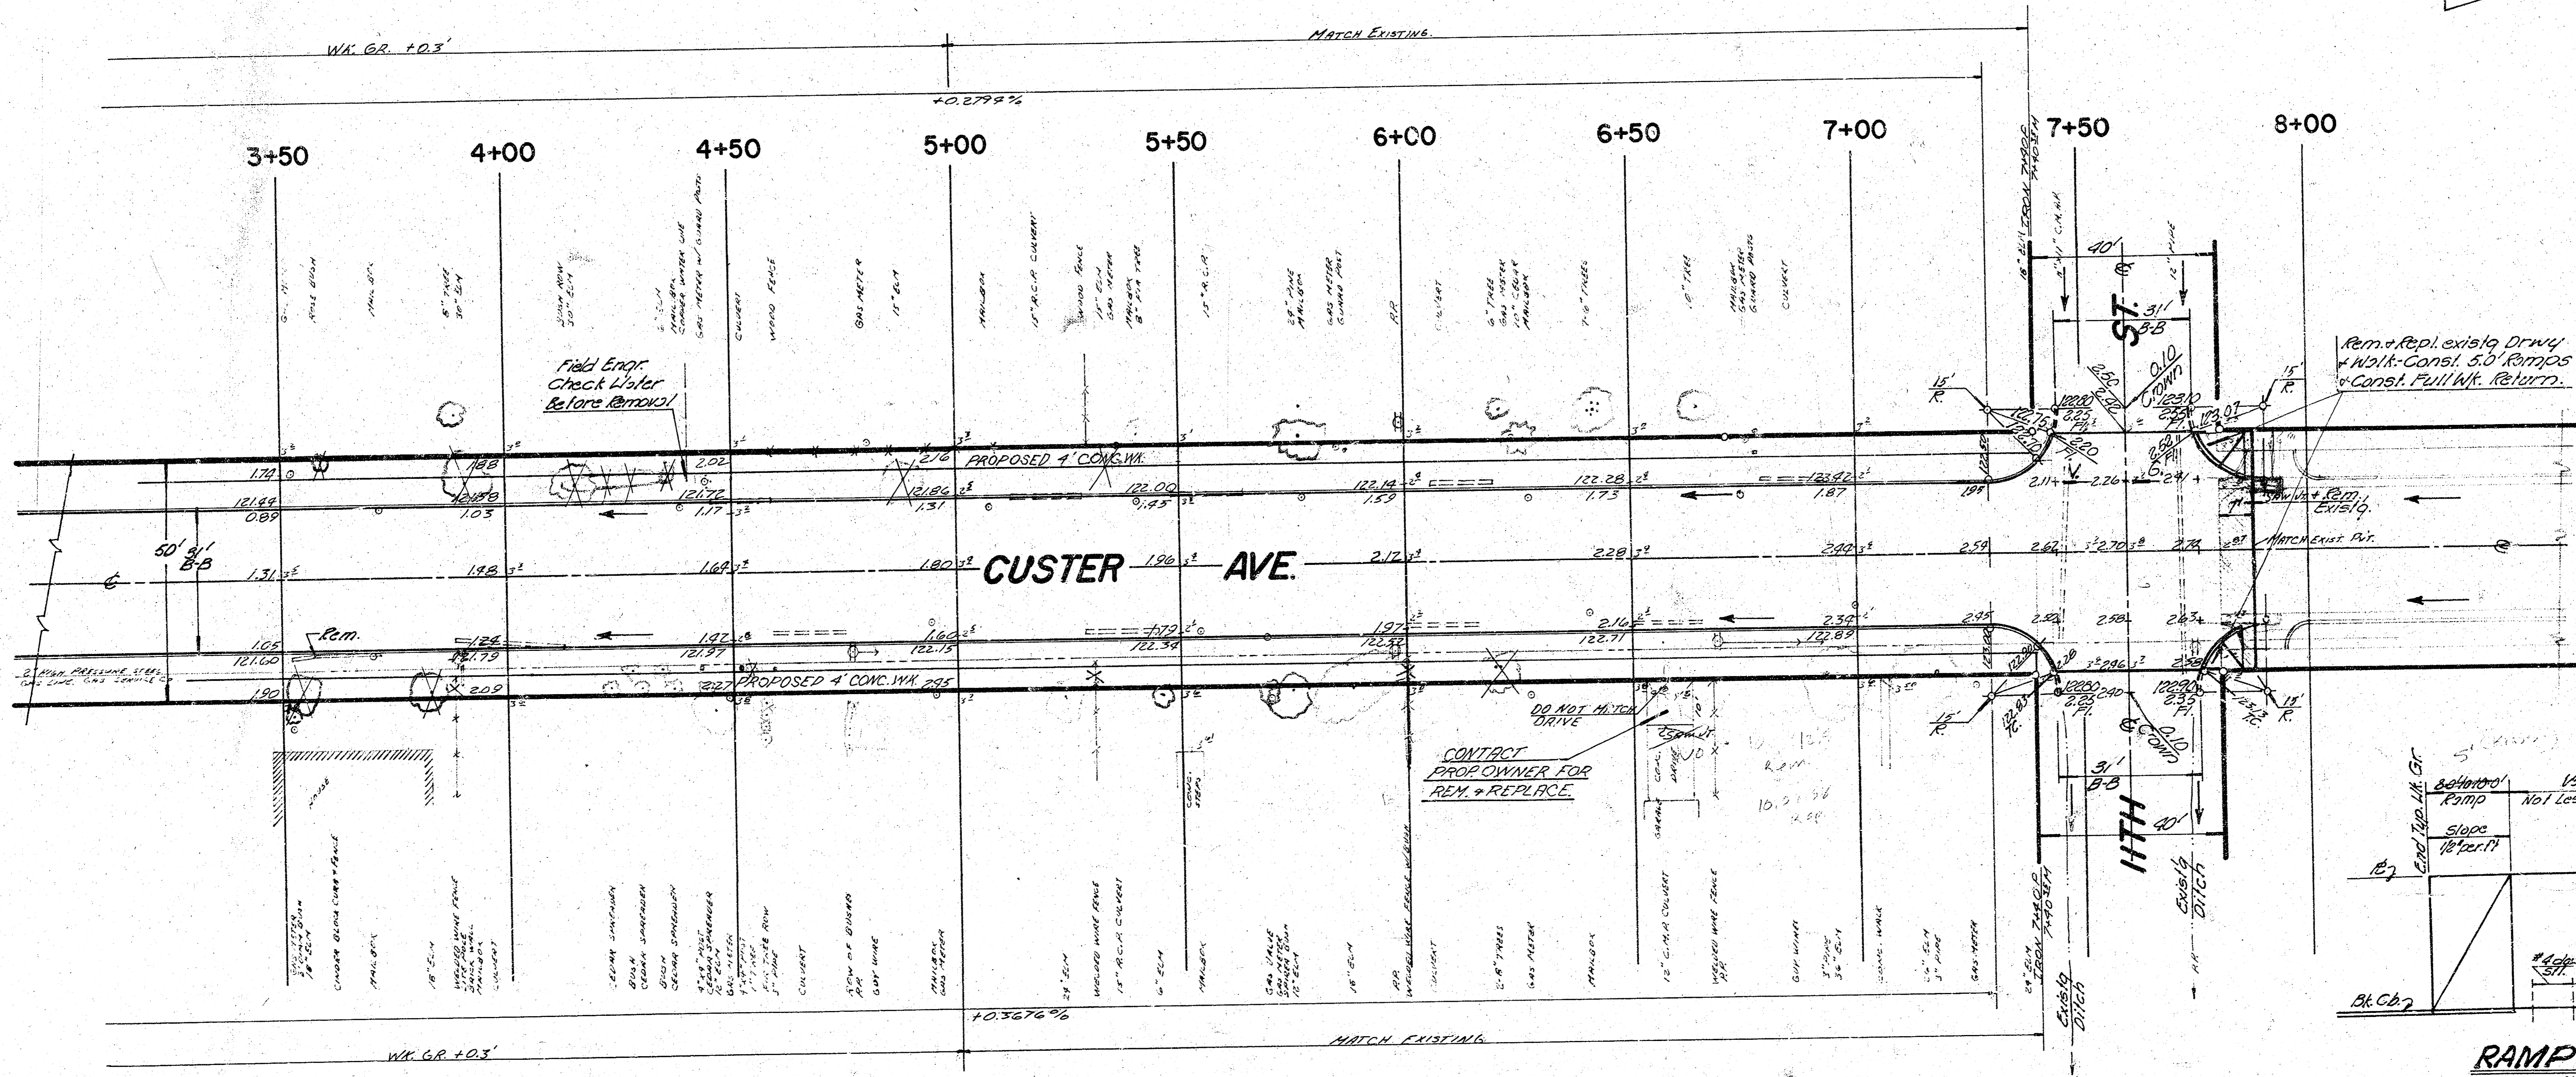

RAMP DR. DETAIL  
 NO. SCALE

CUSTER AVE.  
 DAKS574034 3/12