



B.M. 164.50 'R' in Ritchie E.L. Capri -
N. Curb Zimmerly


B.M. 155.91 'R' in Ritchie Top S. Curb
Bayley - E.L. Capri

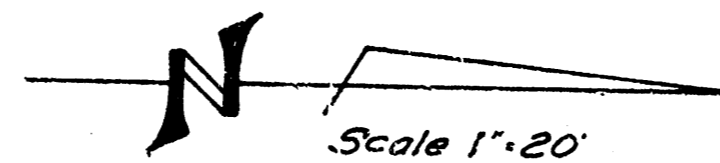

Baseline - W Property Line Dalton Drive

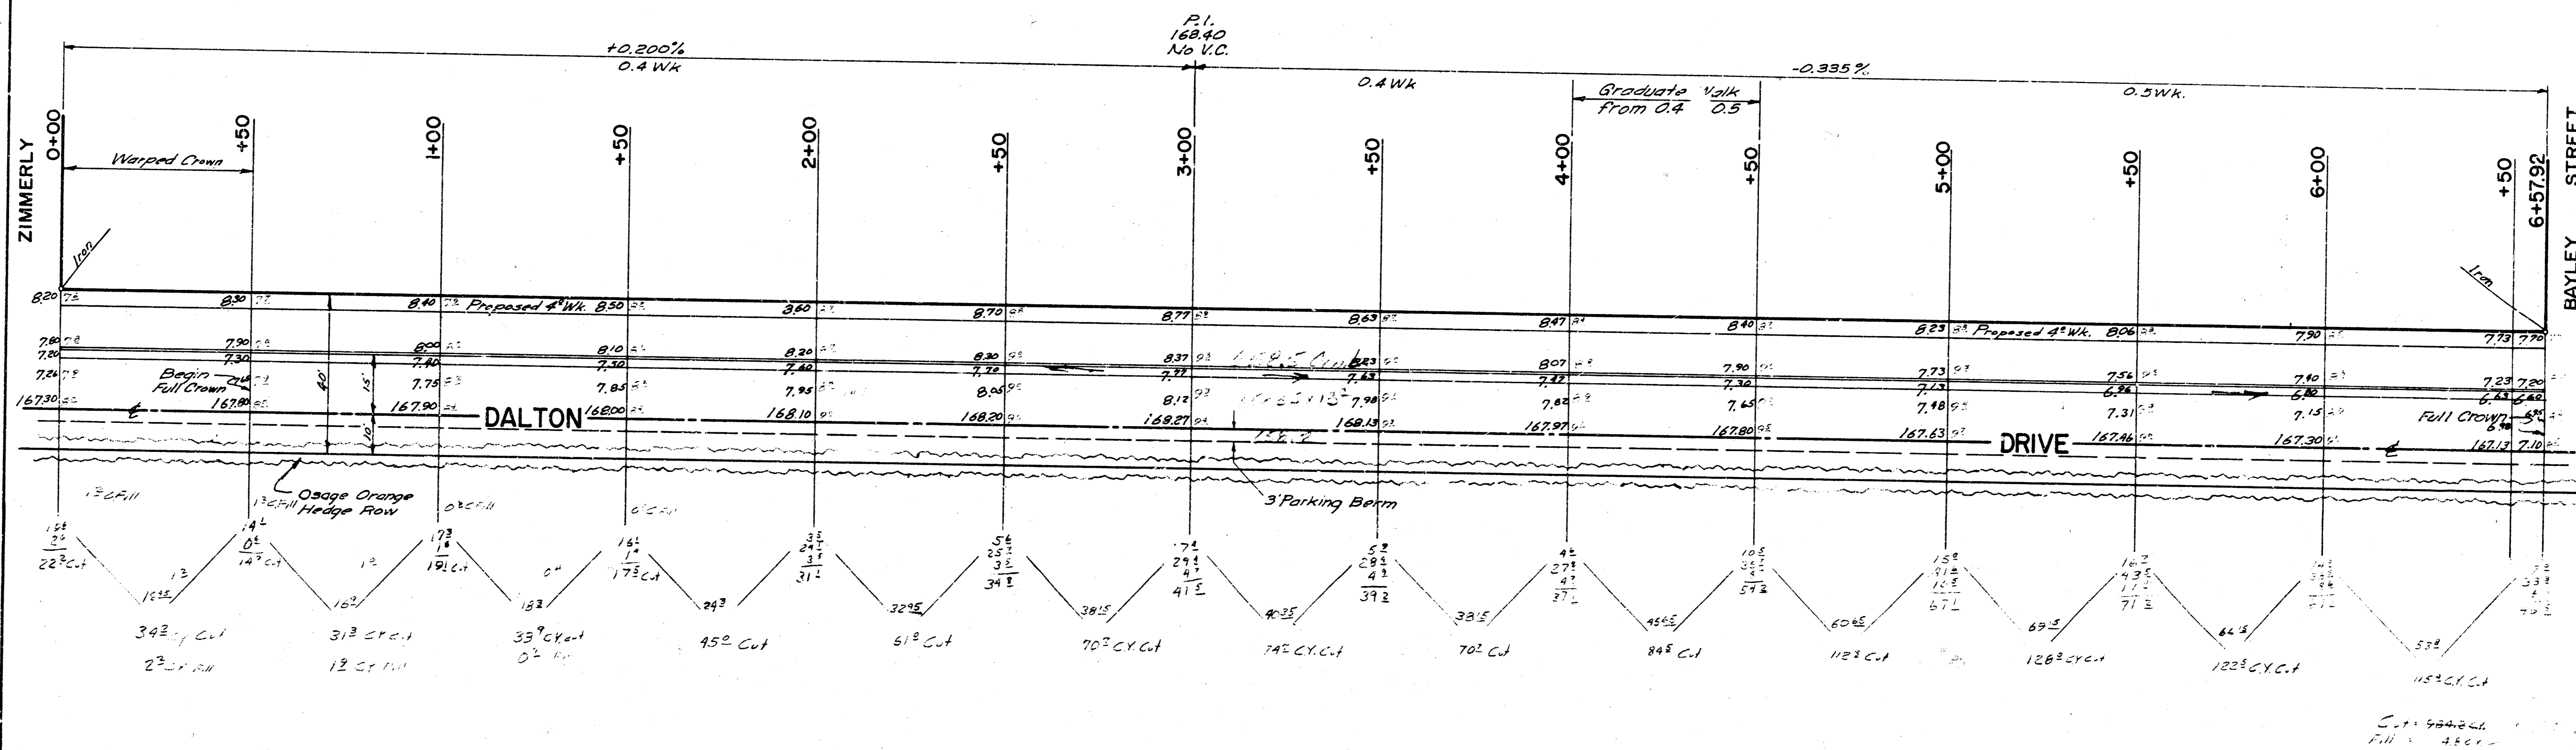

Survey: James M. Murphy
 Eng. License: 436
 City of Wichita, Kansas
 Professional Engineer

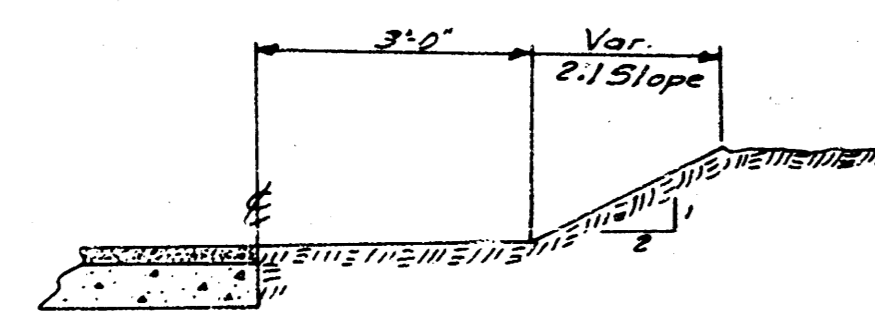

TYPICAL 3' PARKING BERM

Estimated Quantities		
Est.	Item	Final
955	30 Yds. Asphalt Concrete Pavement	320.1
440	Lin. Ft. Comb. Curb and Gutter	128.2
300	Lin. Ft. Separate Curb	100.0
550	Lin. Ft. Separate Gutter	175.0
1650	Sq. Ft. 6" Drive	1650.0
810	Lin. Ft. Marble Joint	810.0
3880	Lbs. Reinf. Steel	3880.0
985	Cu. Yds. Excavation	166.4
5	Cu. Yds. Comp. Fill	5.0



W 1/2 DALTON DRIVE
 From N.L. ZIMMERLY ST.
 To S.L. BAYLEY ST.
 13'-2"-15' A.C.
 B.E. SMITH CITY ENGINEER
 CITY OF WICHITA, KANSAS
 DATE PRIVATE JOB

11 15 5 2