
Sheet: Yoing 14 Sht
Flat: Plan
Ck: Prison
Checked: [illegible]


B.M. 164.50 "R" in Ritchie E.L. Capri - N. Curb Zimmerly

B.M. 155.31 "R" in Ritchie top S. Curb Bayley - E.L. Capri

Scale 1" = 20'

Baseline - W Property Line Dalton Drive

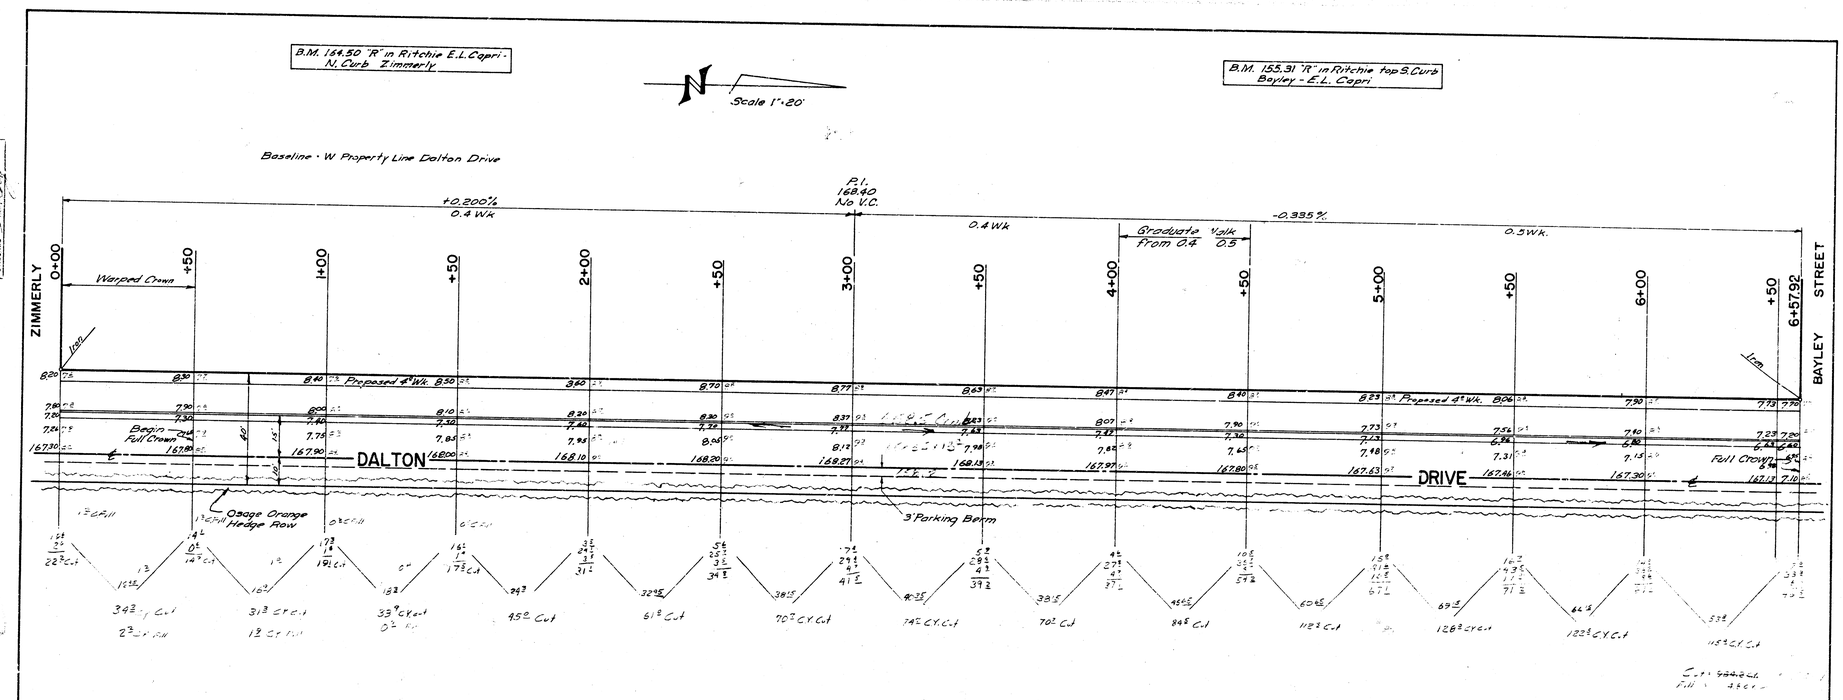

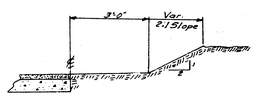

TYPICAL 3' PARKING BERM

Estimated Quantities		
Est.	Item	Final
955 ✓	Sq Yds. Asph. Conc. Pavement	777.1
440 ✓	Lin. Ft. Comb. Curb and Gutter	438.5
200 ✓	Lin. Ft. Separate Curb	———
530 ✓	Lin. Ft. Separate Gutter	———
1630 ✓	Sq. Ft. 6" Drive	———
810 ✓	Lin. Ft. Mastic Joint	438.5
9250 ✓	Lbs. Reinf. Steel	9600
985 ✓	Cu. Yds. Excavation	1654
5 ✓	Cu. Yds. Comp. Fill	4.5

B.E. SMITH LICENSED 436 KANSAS PROFESSIONAL ENGINEER

1/1

W½ DALTON DRIVE

From N.L. ZIMMERLY ST.
To S.L. BAYLEY ST.

13'-2'-15' A.C.

B.E. SMITH CITY ENGINEER
CITY OF WICHITA, KANSAS
DATE PRIVATE JOB