B.M. ~~95.67~~ Standard N.E. Cor. Glenn & 31st St. South

Sta. on S.L.

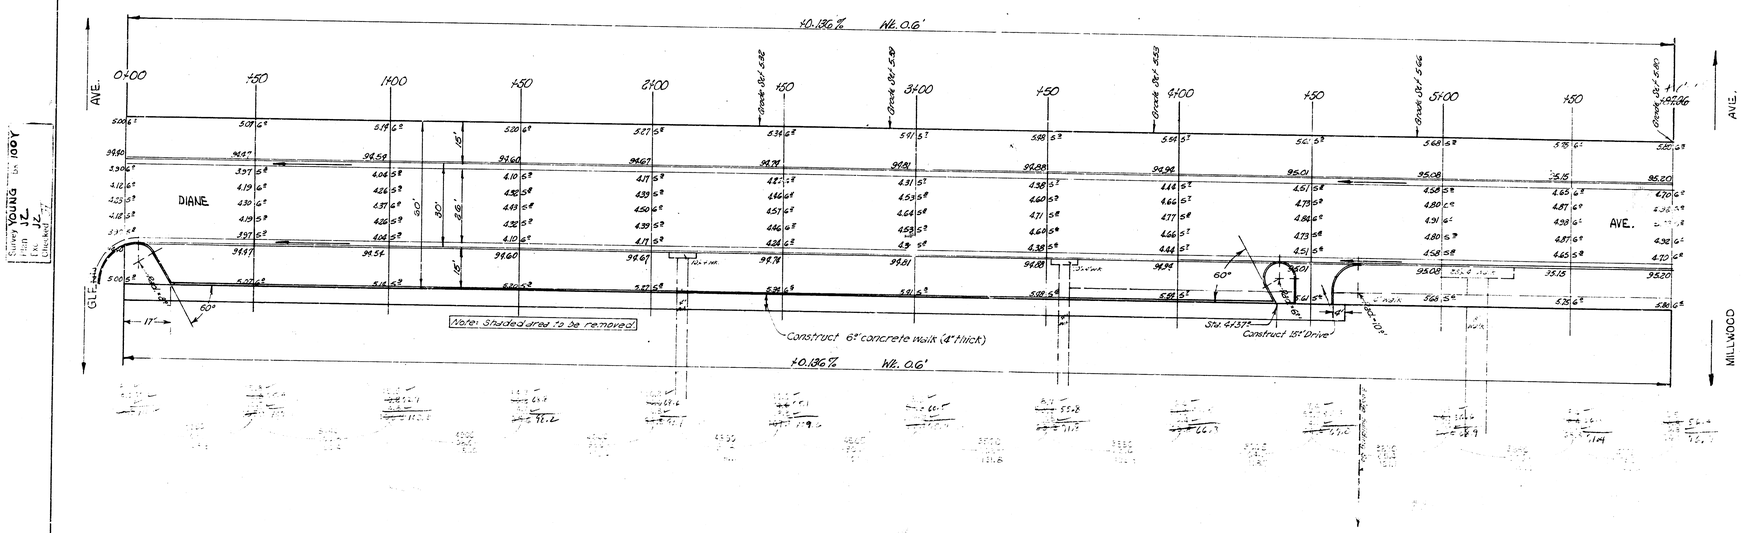

Survey YOUNG Dr. 100Y
Path J.C.
Field J.C.
Checked

PLAN REVISED AUG-10-1962

DIANE

E.L. GLENN - W.L. MILLWOOD

26-2-30 AC

CITY OF WICHITA, KANS.

B.E. SMITH CITY ENGINEER

SEPT., 1954 PROJ. NO. C13-275