


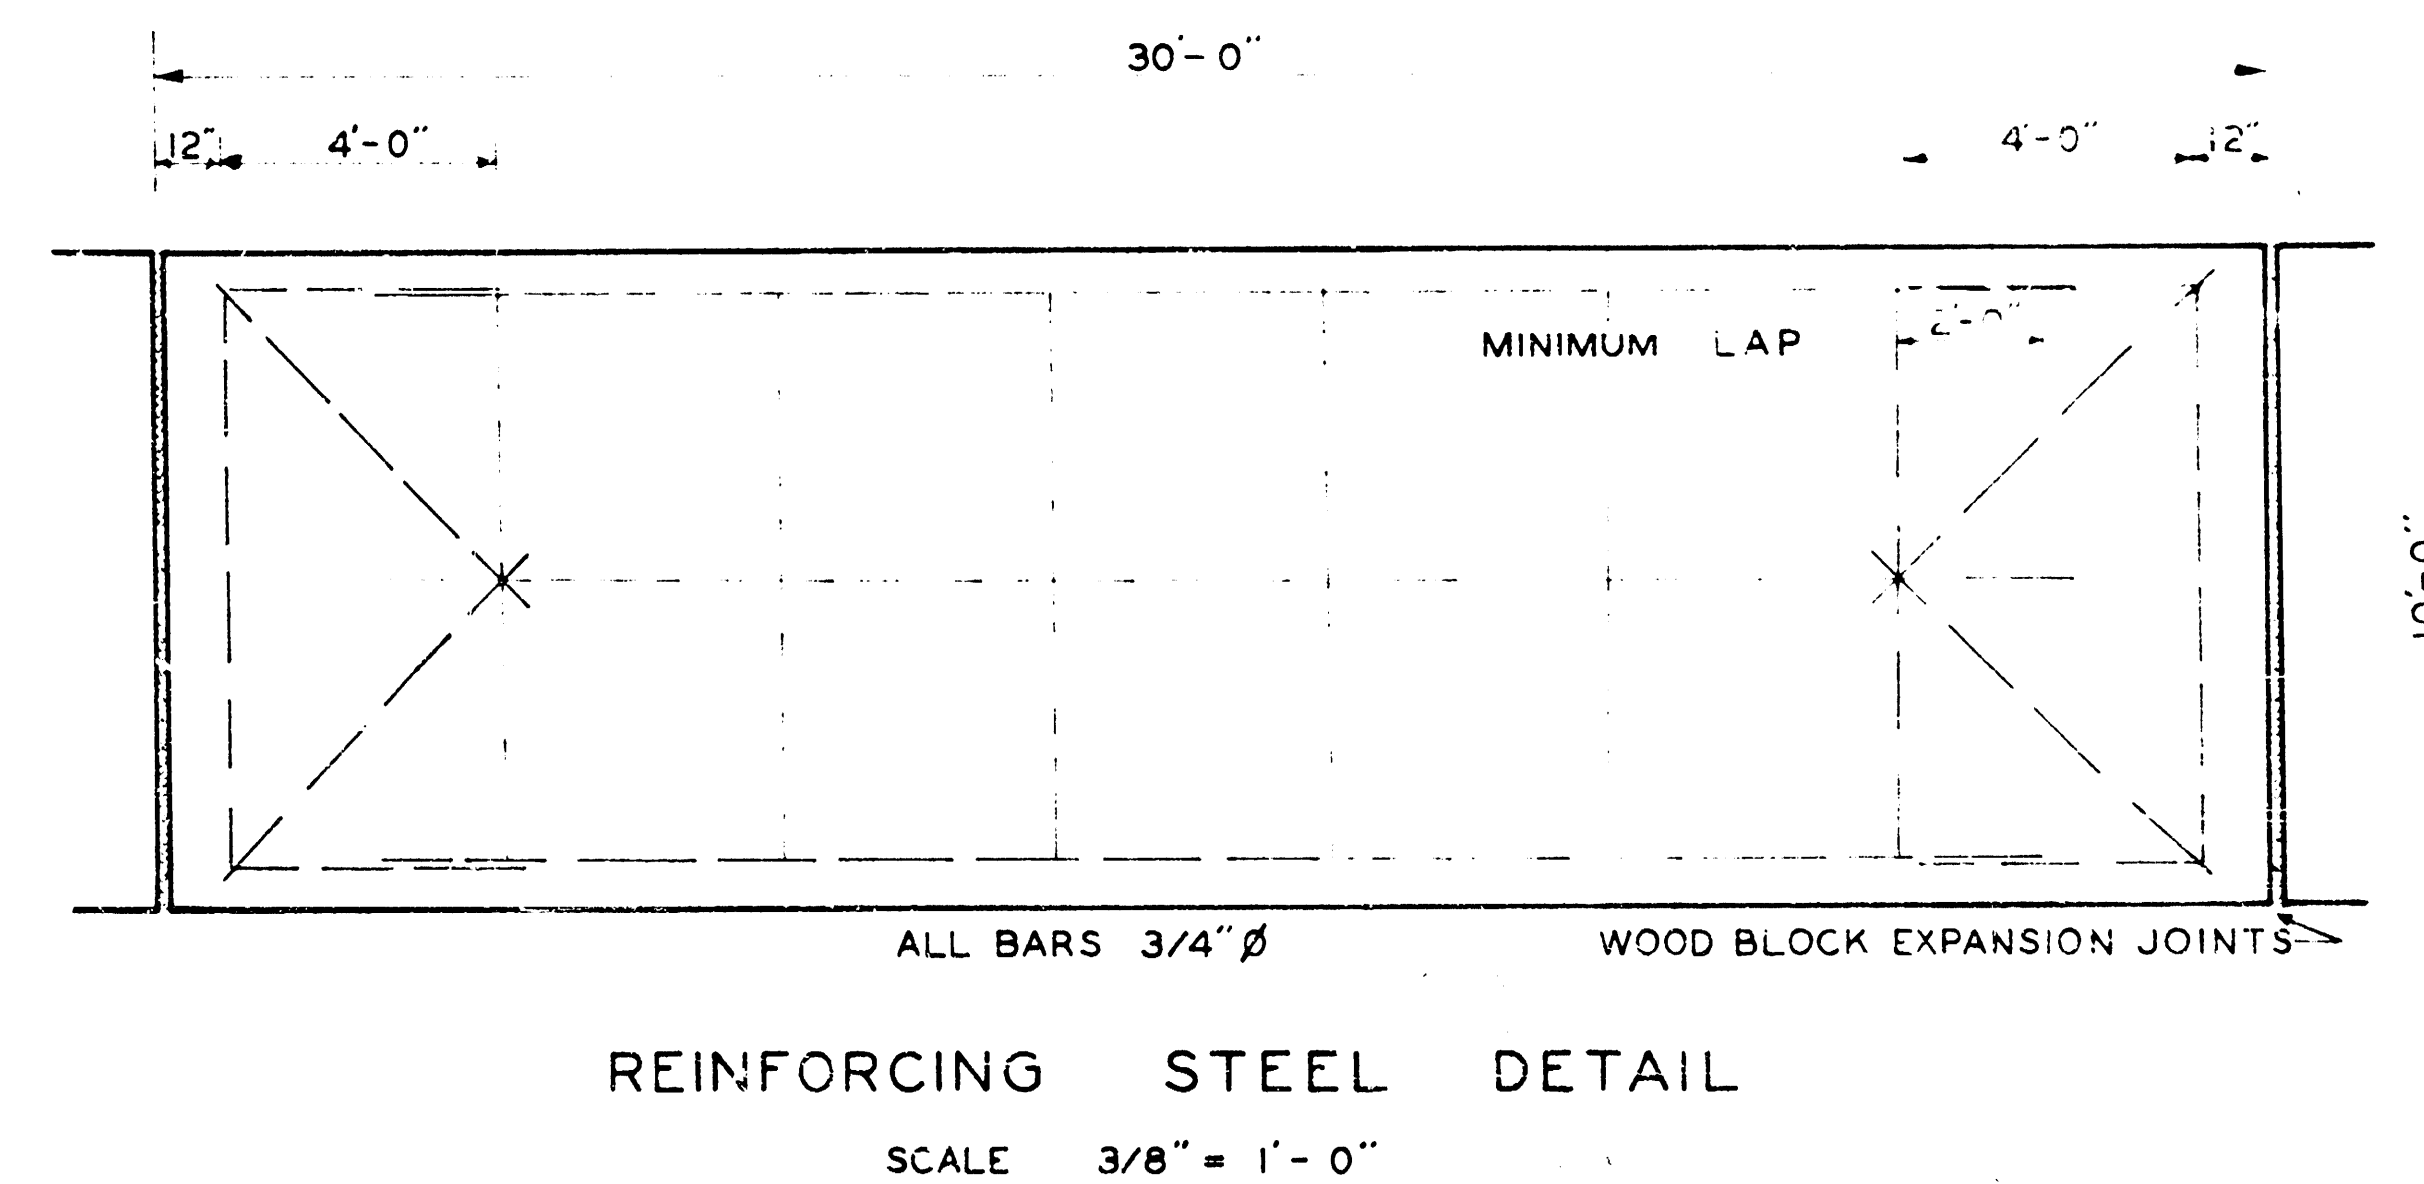
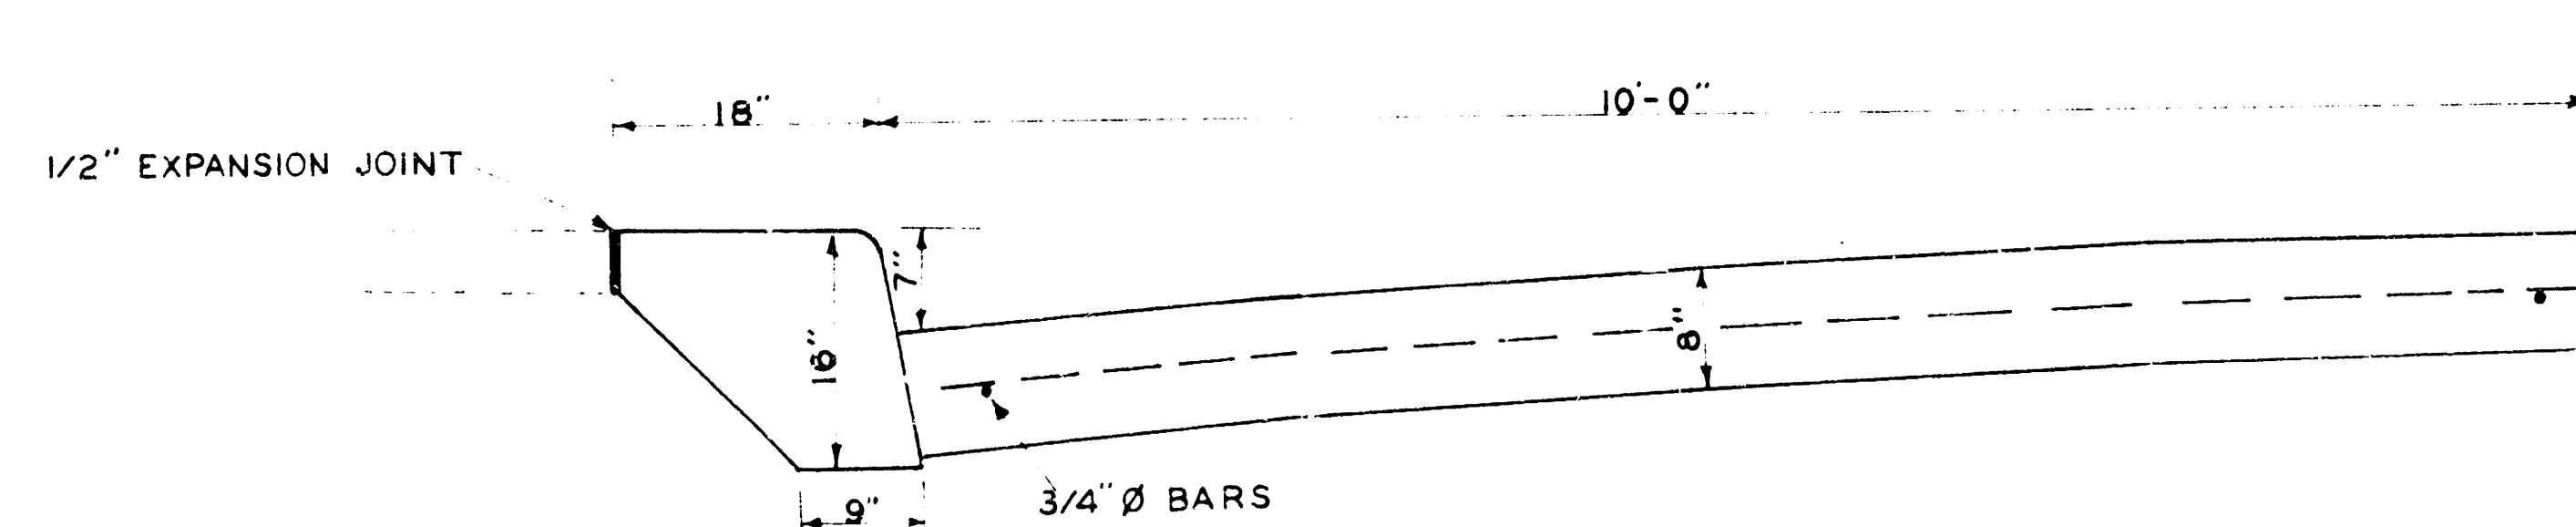
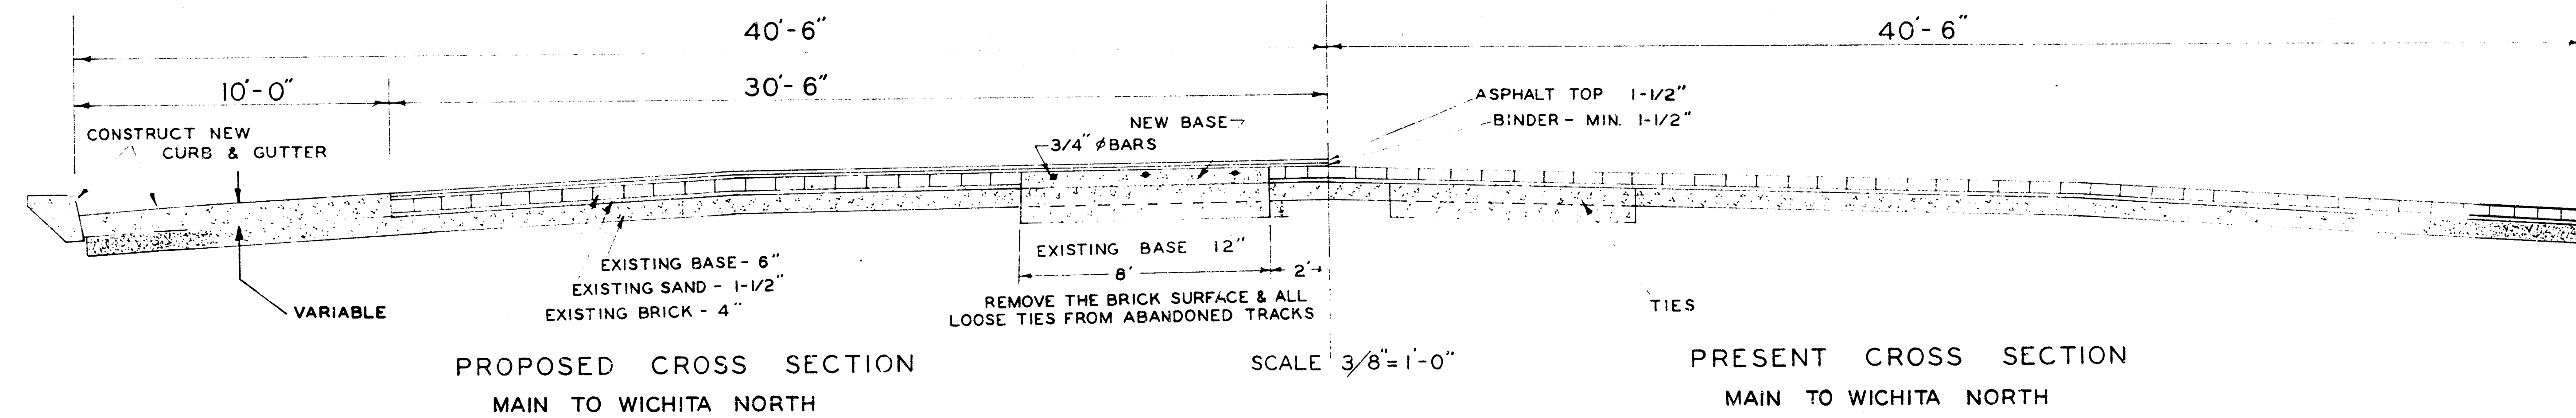


DOUGLAS AVENUE

E.L.WACO ----- W. L. MAIN
1946

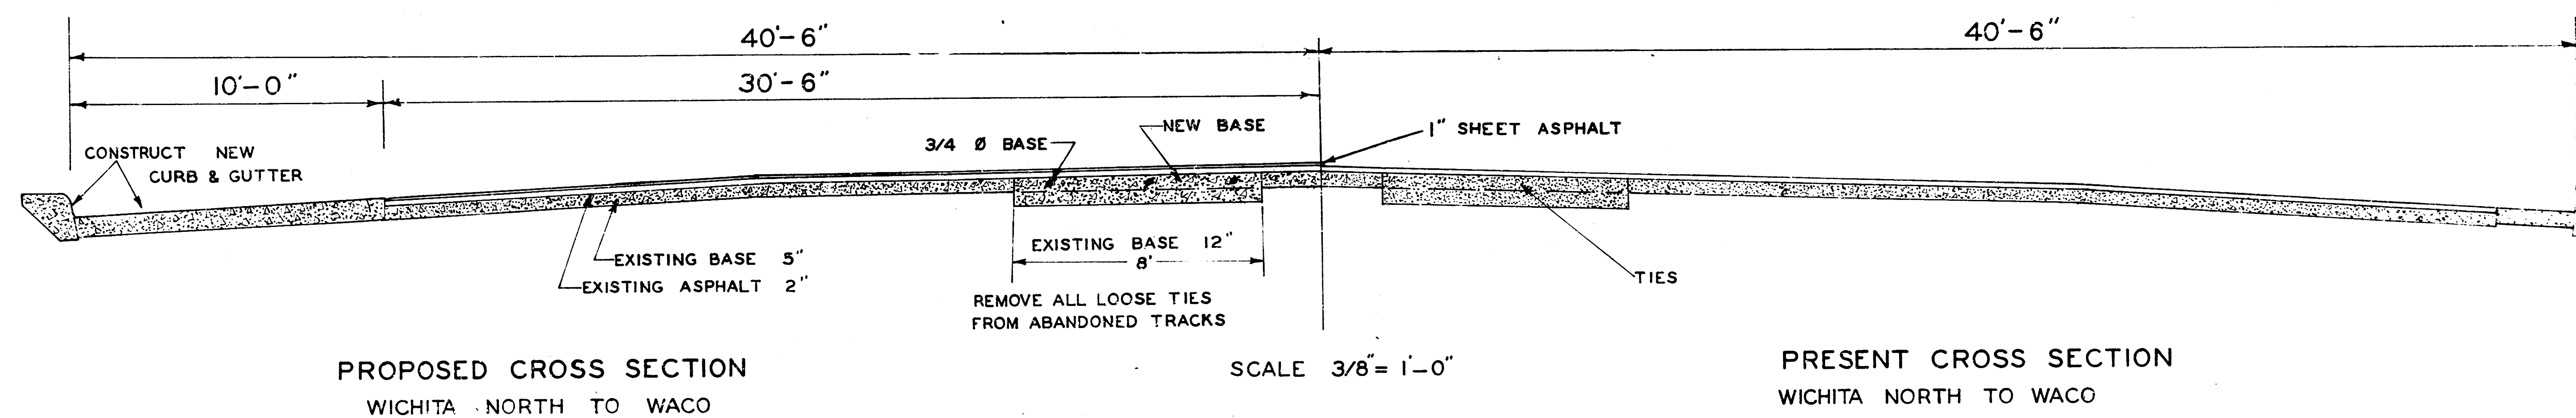

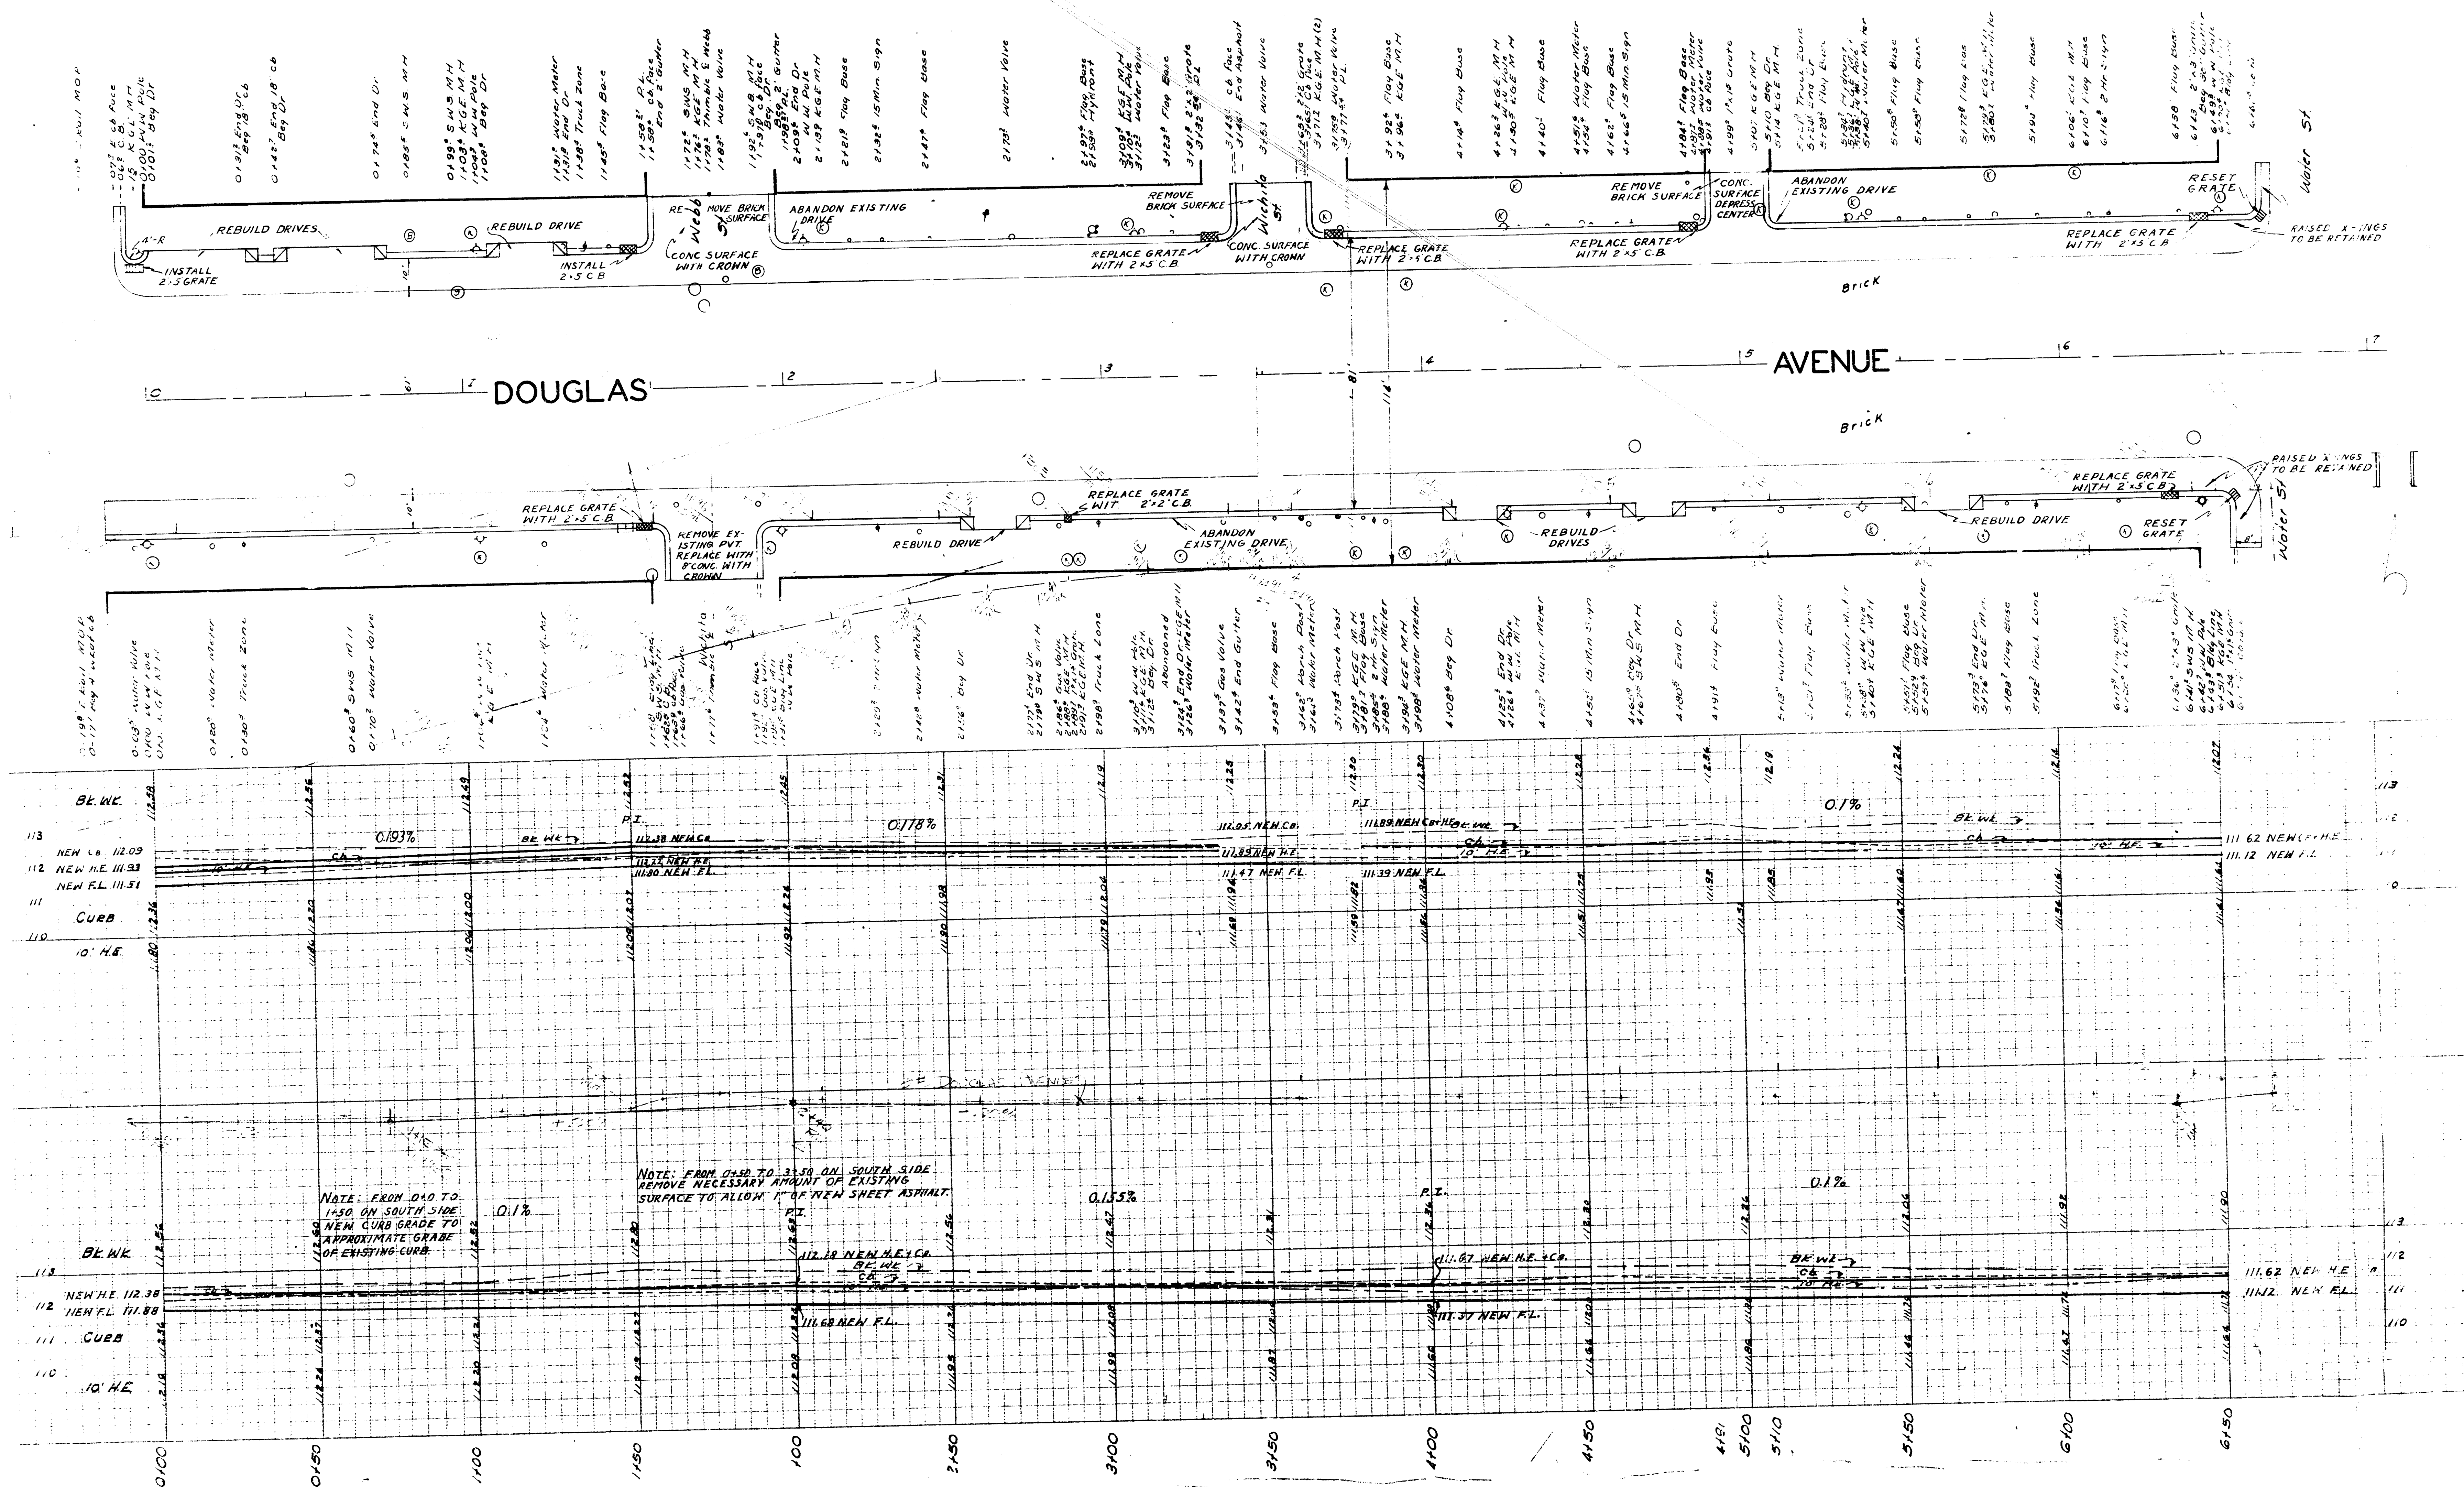

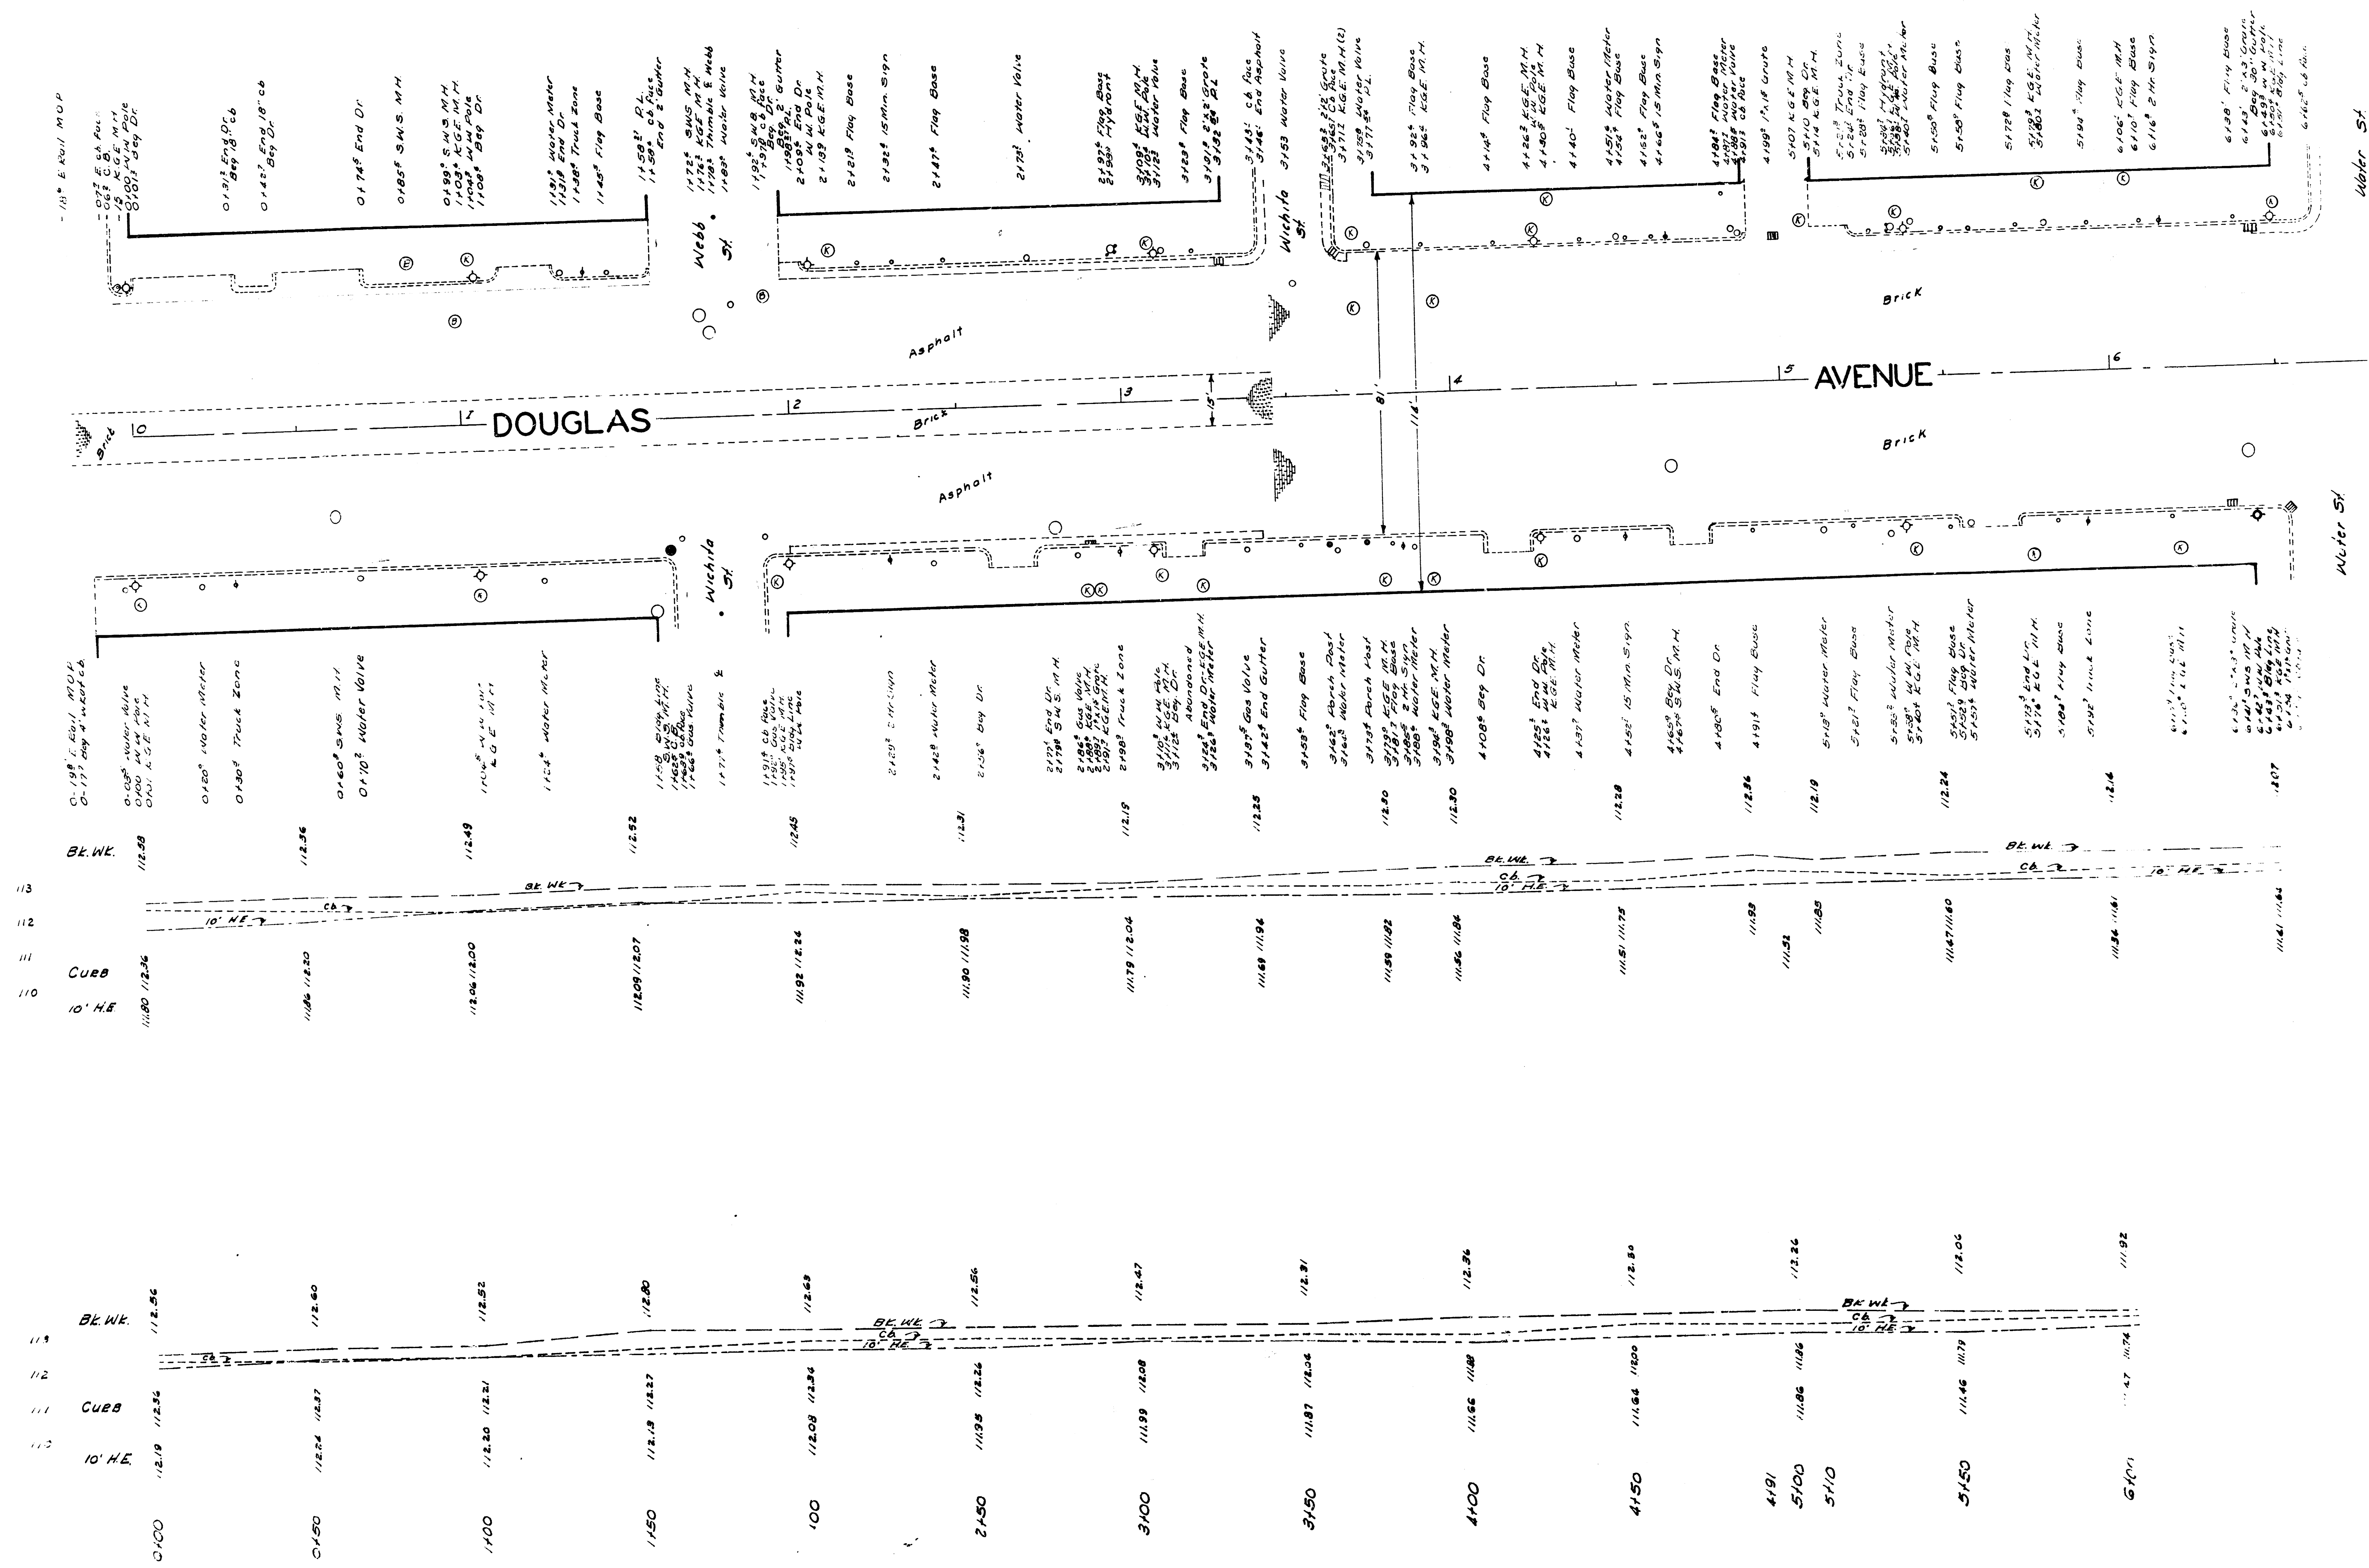


113
112
111
110

BL. WL.
CURB
10' H.E.

111.92
111.74
111.90
111.72

111.36
111.61
111.41
111.64

112.14
112.01

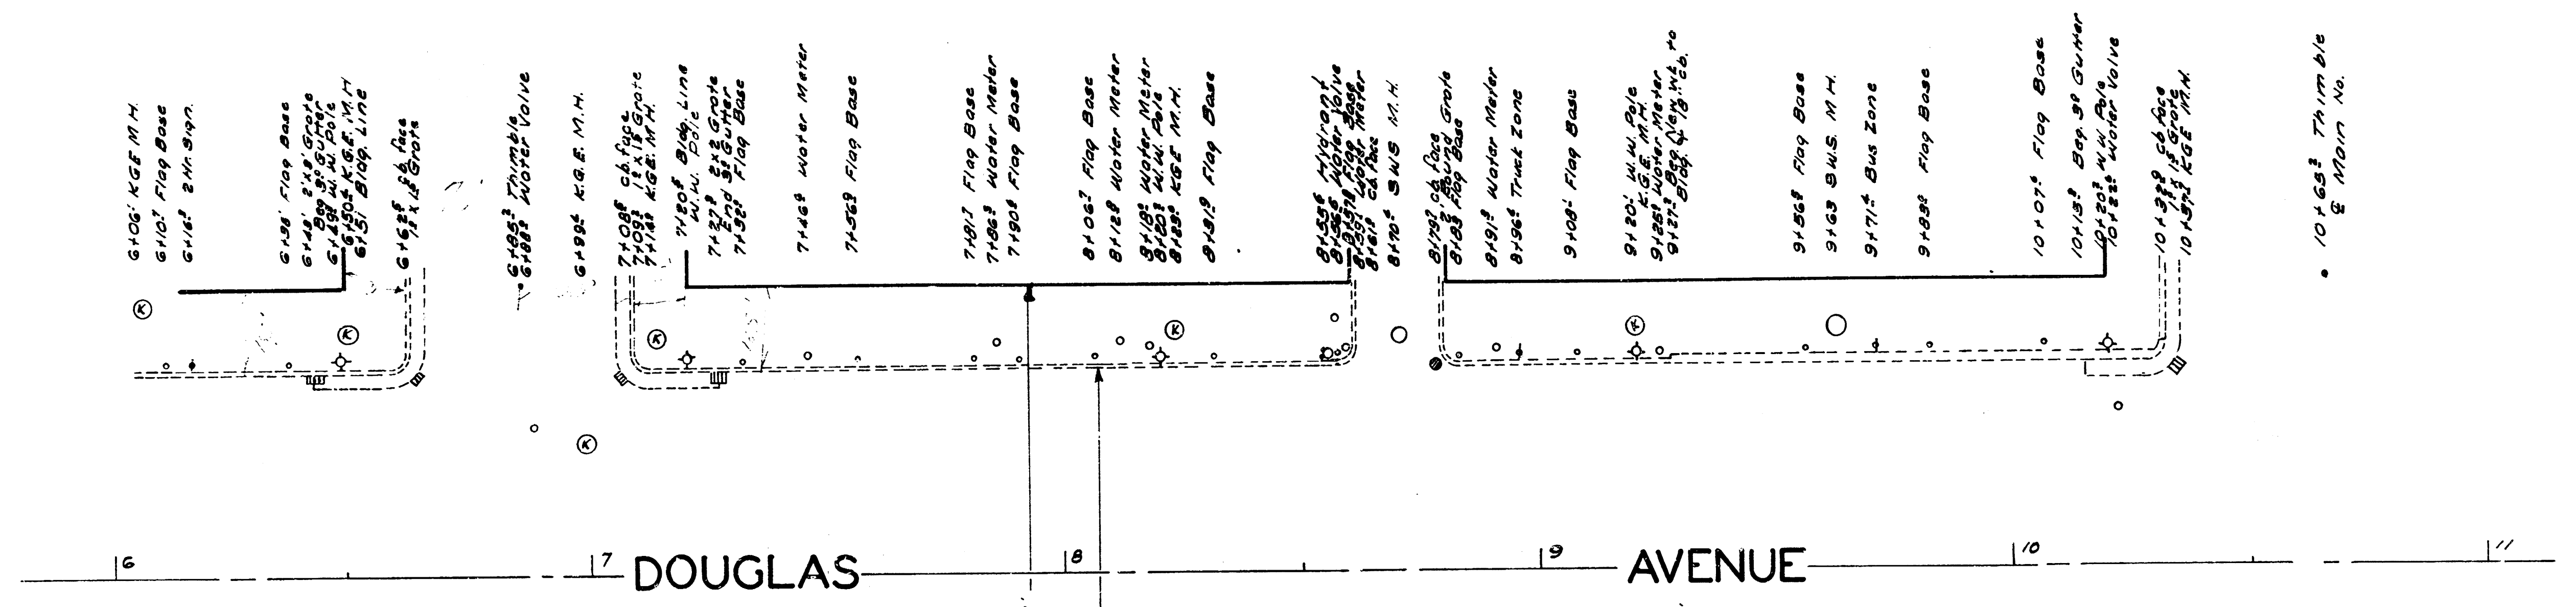

113
112
111
110

BL. WL.
CURB
10' H.E.

111.86
111.97
111.72
111.90

111.65
111.63
111.53
111.80

111.62
111.57
111.42
111.76

111.41
111.63
111.42
111.76

111.95
111.83
111.60
111.86

112.13
112.17
112.27
112.29

112.24
112.32
112.06
112.38

B.M. 112.65 "N" in Martin's cor.
B.M. 113.93 U.S. B.M. M.O.P. Depot
B.M. 120.00 NE SE. Cor. Pier Base Cut Bank
B.M. 111.74 W.R. NE. Cor. Bldg. S.W. Cor.
B.M. 112.25 W.E. NE. Cor. Bldg. S.W. Cor.

N.W. Waco & Douglas
NE. Webb & Douglas
Grocery N.W. Water & Douglas
Market & Douglas
Main & Douglas

