DOUGLAS AVE. E.L. PINECREST TO CITY LIMITS 40' ROADWAY 2' COMB. CURB & GUTTER 5" Conc. Base 2" Asphalt Surface.

B.M. Elev. 173.92 N. End cb. Ref. (N.P.L.) N.E. Pinecrest & Douglas.

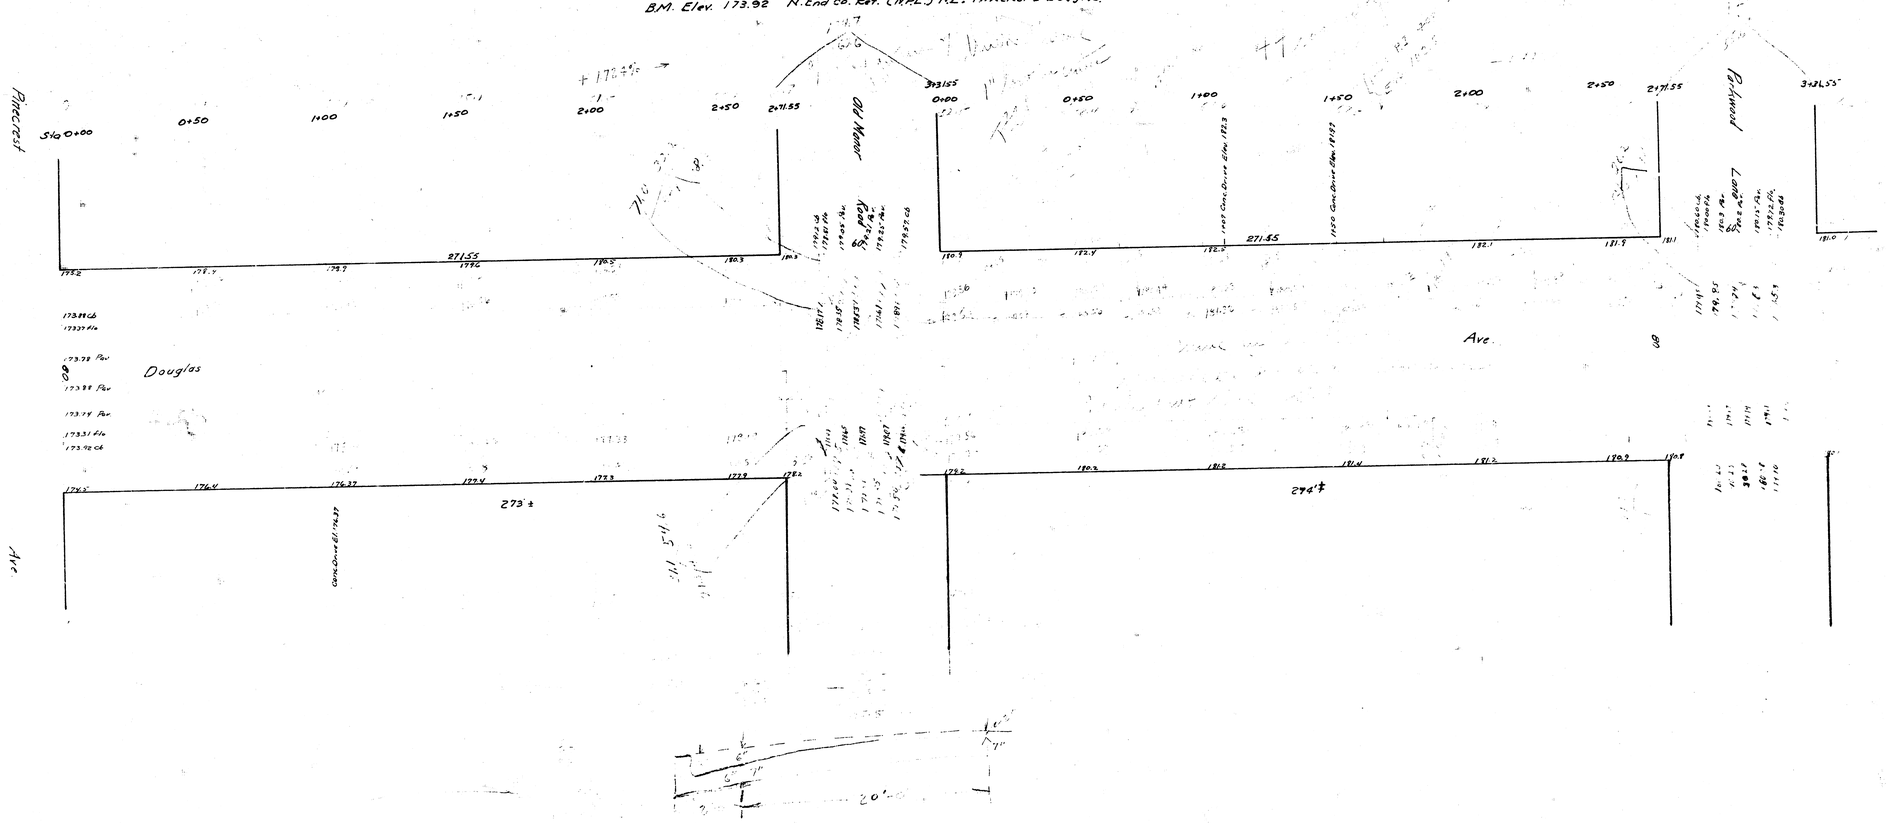

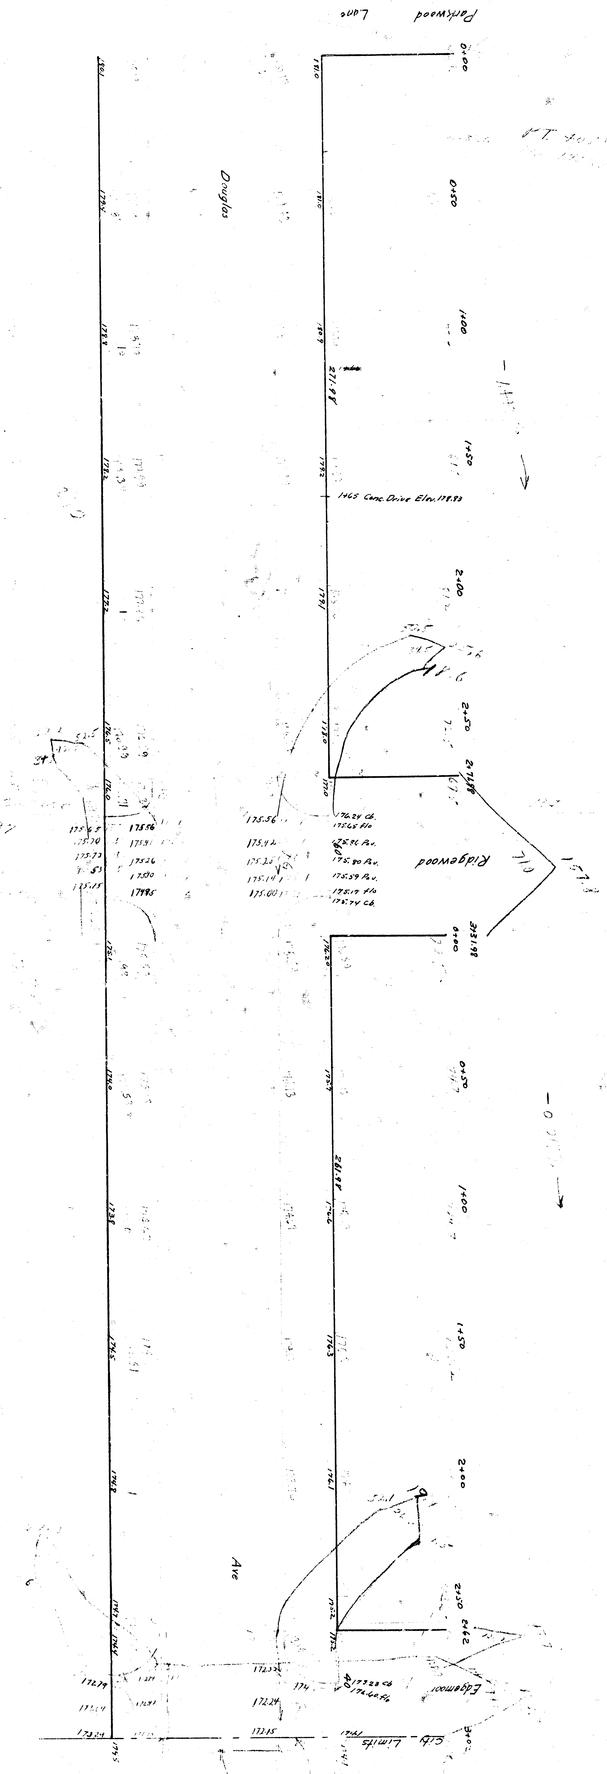
Parkwood Lane
Douglas
Ave
Ridgewood
Edgewood
City Limits
1465 Conc. Drive Elev. 178.93
175.56
175.94
175.32
175.14
175.00
175.70
175.73
175.26
175.00
175.15
175.56
175.91
175.26
175.00
175.15
172.24
172.24
172.24