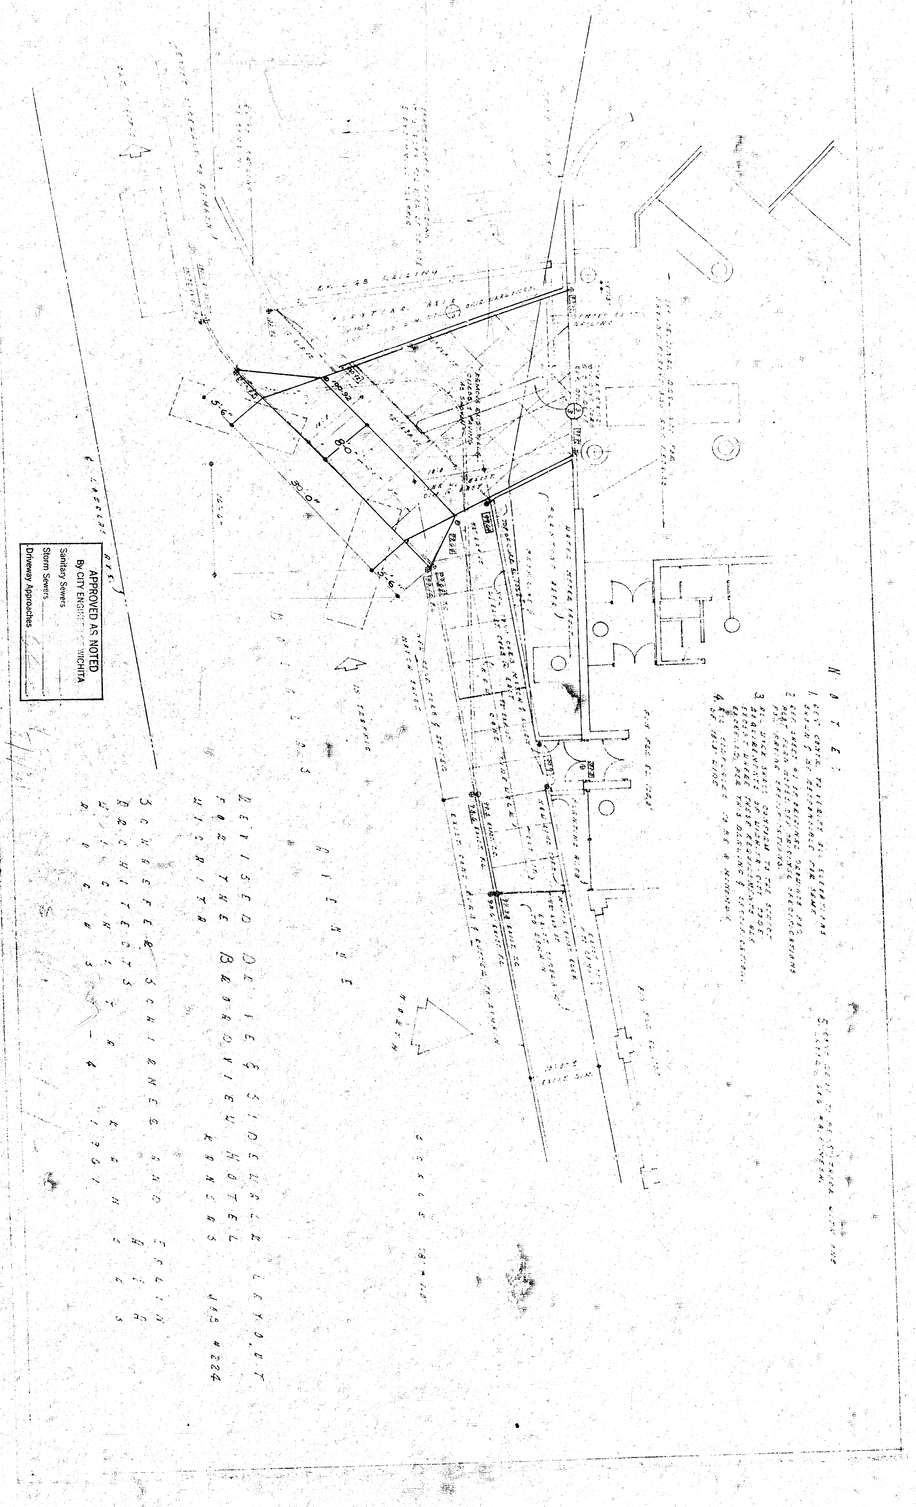
APPROVED AS NOTED
BY CITY ENGINEER WICHITA
Sanitary Sewers
Storm Sewers
Driveway Approaches
WICHITA, KANSAS
ARCHITECTS
WICHITA, KANSAS