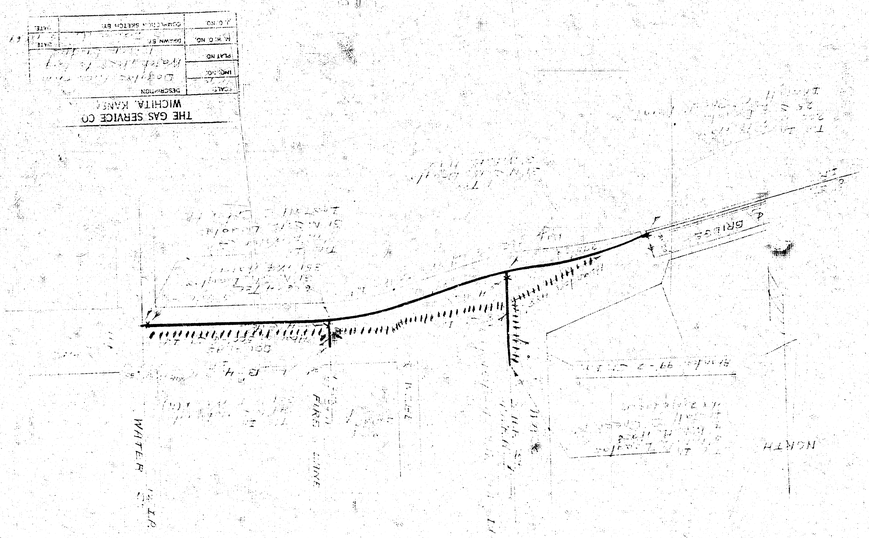

THE GAS SERVICE CO
WICHITA, KANS.
DESCRIPTION
SCALE
DRAWN BY
CHECKED
PLAT NO.
DRAWING NO.
SUBJECT - SECTION NO.
DATE
4" BRIDGE
WATER R.
NORTH