

1 CURB & GUTTER

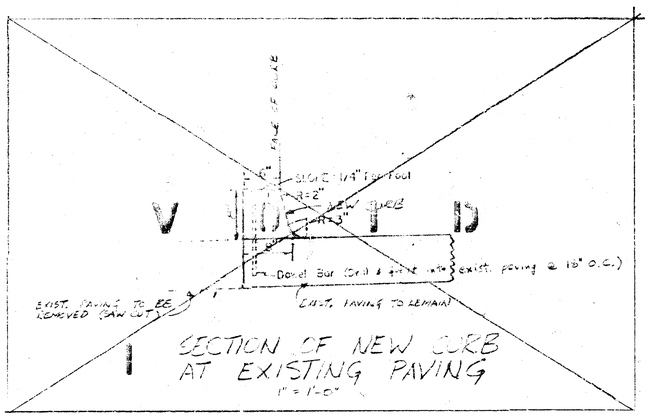

1 SECTION OF NEW CURB AT EXISTING PAVING
1" = 1'-0"

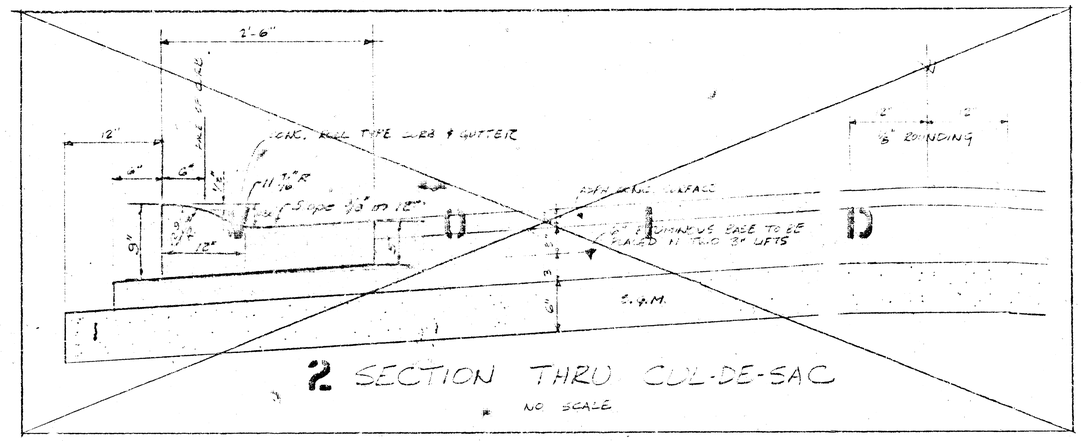

2 SECTION THRU CUL-DE-SAC
NO SCALE

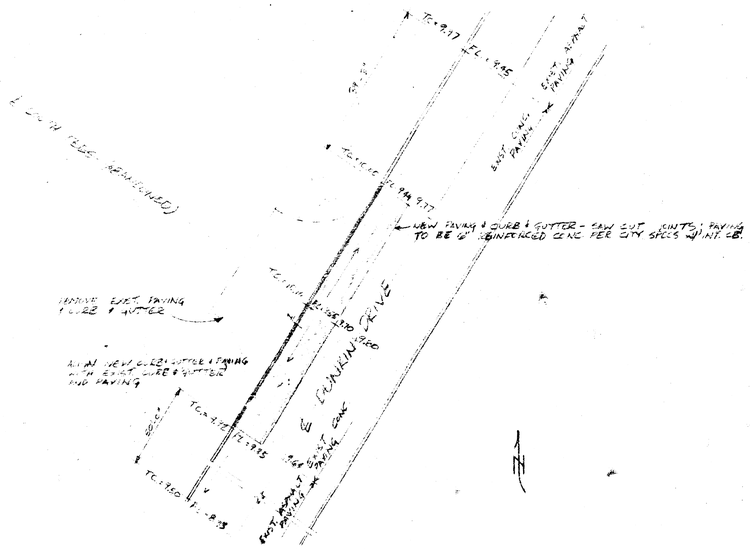
CLOWN TEES (REMOVED)
REMOVE EXIST. PAVING & CURB & GUTTER
ALIGN NEW CURB, GUTTER & PAVING WITH EXIST. CURB & GUTTER AND PAVING
NEW PAVING & CURB & GUTTER - SAW CUT JOINTS; PAVING TO BE 6" REINFORCED CONC. PER CITY SPECS W/ INT. CB.
EXIST. ASPH. PAVING
EXIST. CONC. PAVING
EXIST. ASPH. & CONC. PAVING
FUNKIN DRIVE
TC=9.77
EL.=9.45
TC=9.77
TC=9.77
TC=9.77