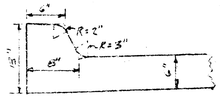

CURB & GUTTER

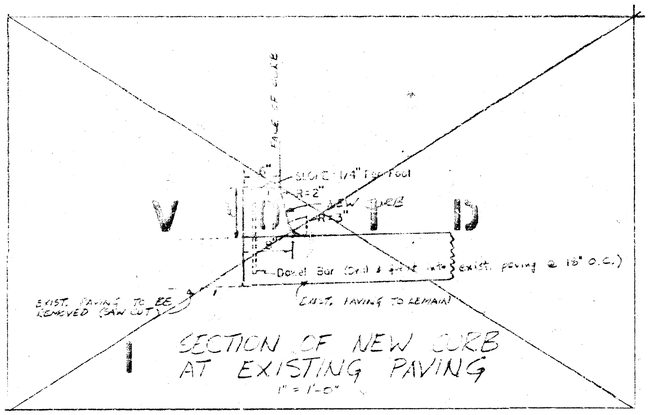

1 SECTION OF NEW CURB AT EXISTING PAVING
1" = 1'-0"

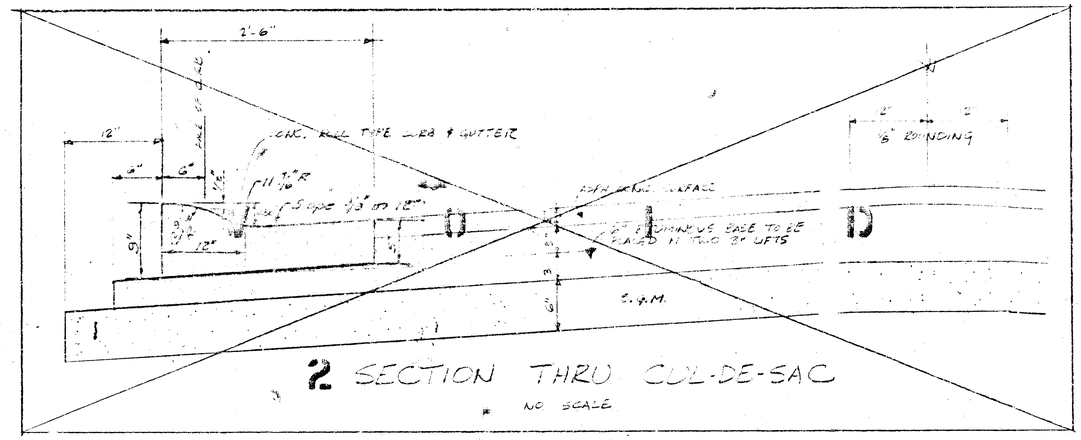

2 SECTION THRU CUL-DE-SAC
NO SCALE

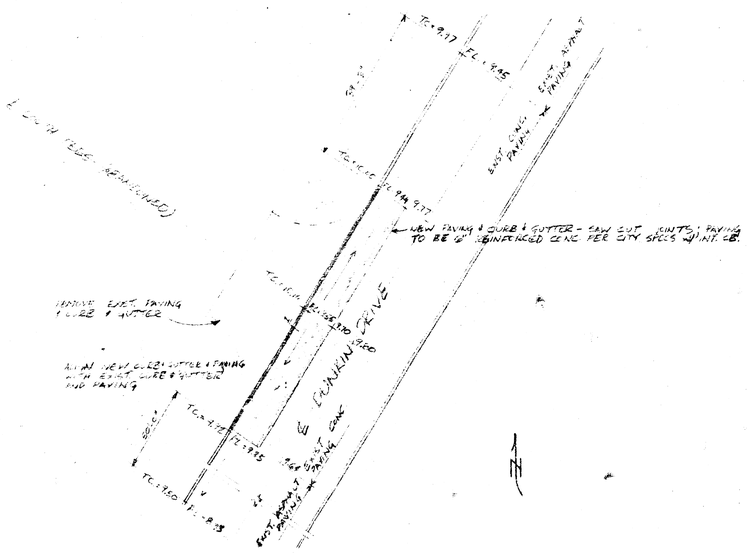

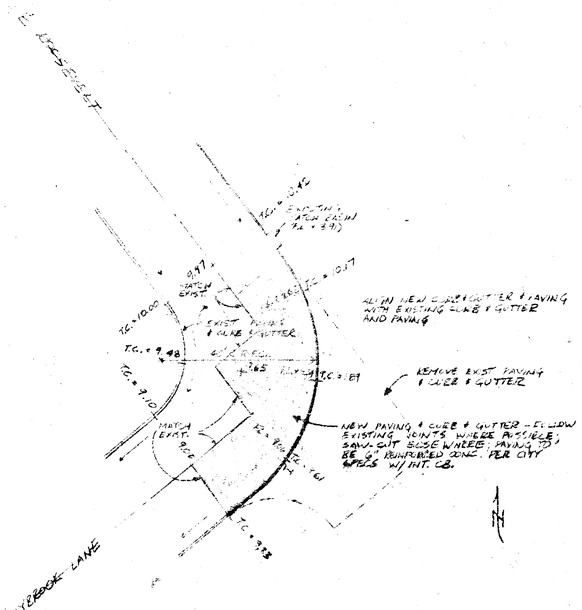

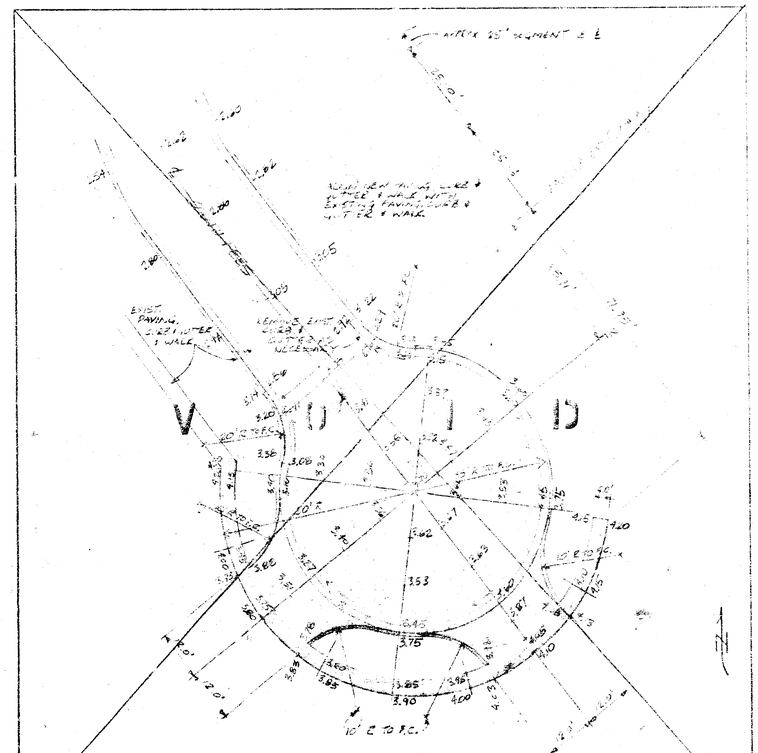

APPROVED: CITY OF WICHITA
Approval does not relieve the contractor from any responsibility for errors or deviations from the contract requirements or for any deficiencies of equipment, work, or materials.
Date 7-27-78
Engineering Div.

NOTE TO CONTRACTOR
This project will be constructed under the supervision of the CITY ENGINEER and conforming to the SPECIFICATIONS of the CITY OF WICHITA. The CONTRACTOR will reimburse the City of Wichita for all cost of ~~engineering, plan review~~ and inspection.

APPROVED AS NOTED
By CITY ENGINEER OF WICHITA
Sanitary Sewers
Storm Sewers
Driveway Approaches

Approved w/ paving & Bonds + Contracts 7-27-78 JPT

472-76-245-80698-000-000-068