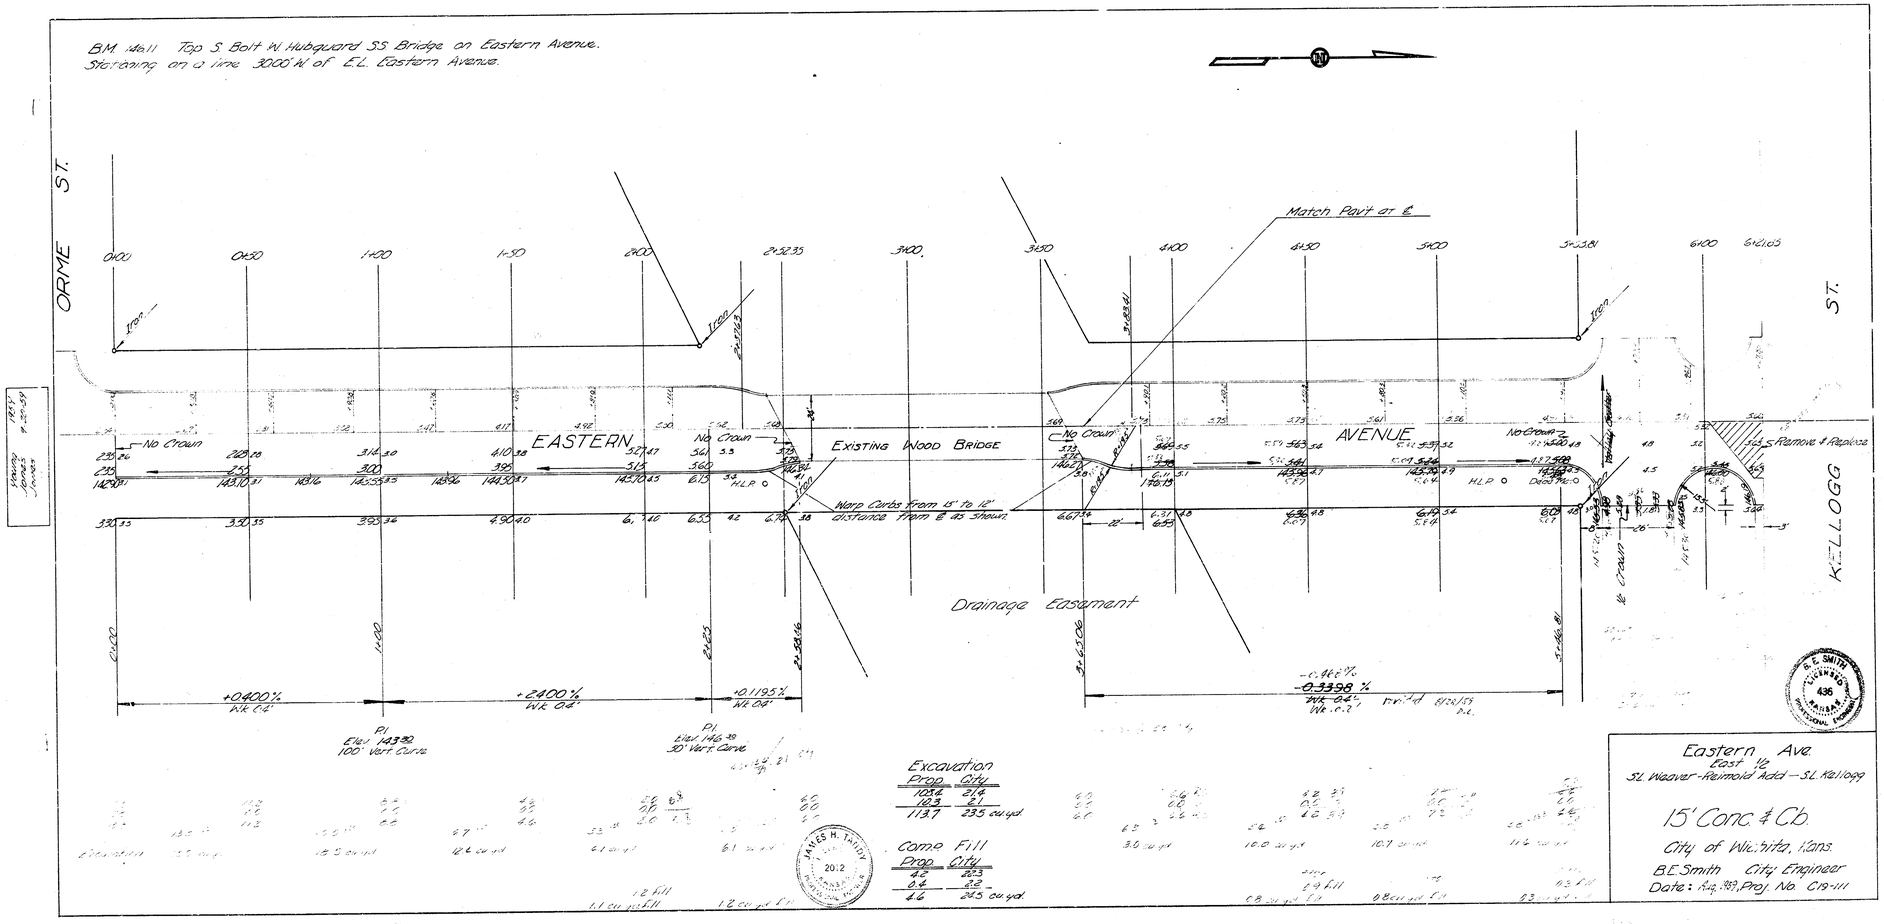

B.M. 146.11 Top S. Bolt W. Hubguard S.S. Bridge on Eastern Avenue.
Stationing on a line 30.00' W. of E.L. Eastern Avenue.
ORME ST.
KELLOGG ST.
EASTERN AVENUE
Match Pav't at ℄
Existing Wood Bridge
Warp Curbs from 15' to 12' distance from ℄ as shown.
Drainage Easement
No Crown
Remove & Replace
+0.400% Wk 0.4'
+2.400% Wk 0.4'
+0.1195% Wk 0.4'
-0.3398% Wk 0.4'
P.I. Elev. 143.32 100' Vert. Curve
P.I. Elev. 146.39 50' Vert. Curve
Excavation
Prop. City
105.4 21.4
10.3 2.1
113.7 23.5 cu. yd.
Comp. Fill
Prop. City
4.2 22.3
0.4 2.2
4.6 24.5 cu. yd.
Eastern Ave.
East ½
S.L. Weaver-Reimold Add.—S.L. Kellogg
15' Conc. & Cb.
City of Wichita, Kans.
B.E. Smith City Engineer
Date: Aug. 1959, Proj. No. C19-111