
B.M. 169.50 "R" in Ritchie E.L. Capri N. Cb. Zimmerly
B.M. 164.39 "R" in Ritchie Top Cb. E. end radii N.E. Cor. Zimmerly & Rosalie
B.M. 155.31 "R" in Ritchie E.L. Capri S. Cb. Bayley

Final Quantities

Units	Quantities	Totals
S.Y.	Pavement	4,901.0
L.F.	Comb. Cb. & Gtr.	1,083.3
L.F.	Sep. Cb.	188.0
S.F.	Sep. Bk.	1,322.2
S.F.	6" Drive	1,153.8
Lbs.	Reinf. Steel	7860
C.Y.	Excav.	1,088.3

Scale 1" = 20'

Units	Quantities	Totals
S.Y.	Pavement	1704
L.F.	Comb. Cb. & Gtr.	1316
Lbs.	Reinf. Steel	9765
C.Y.	Excavation	1370

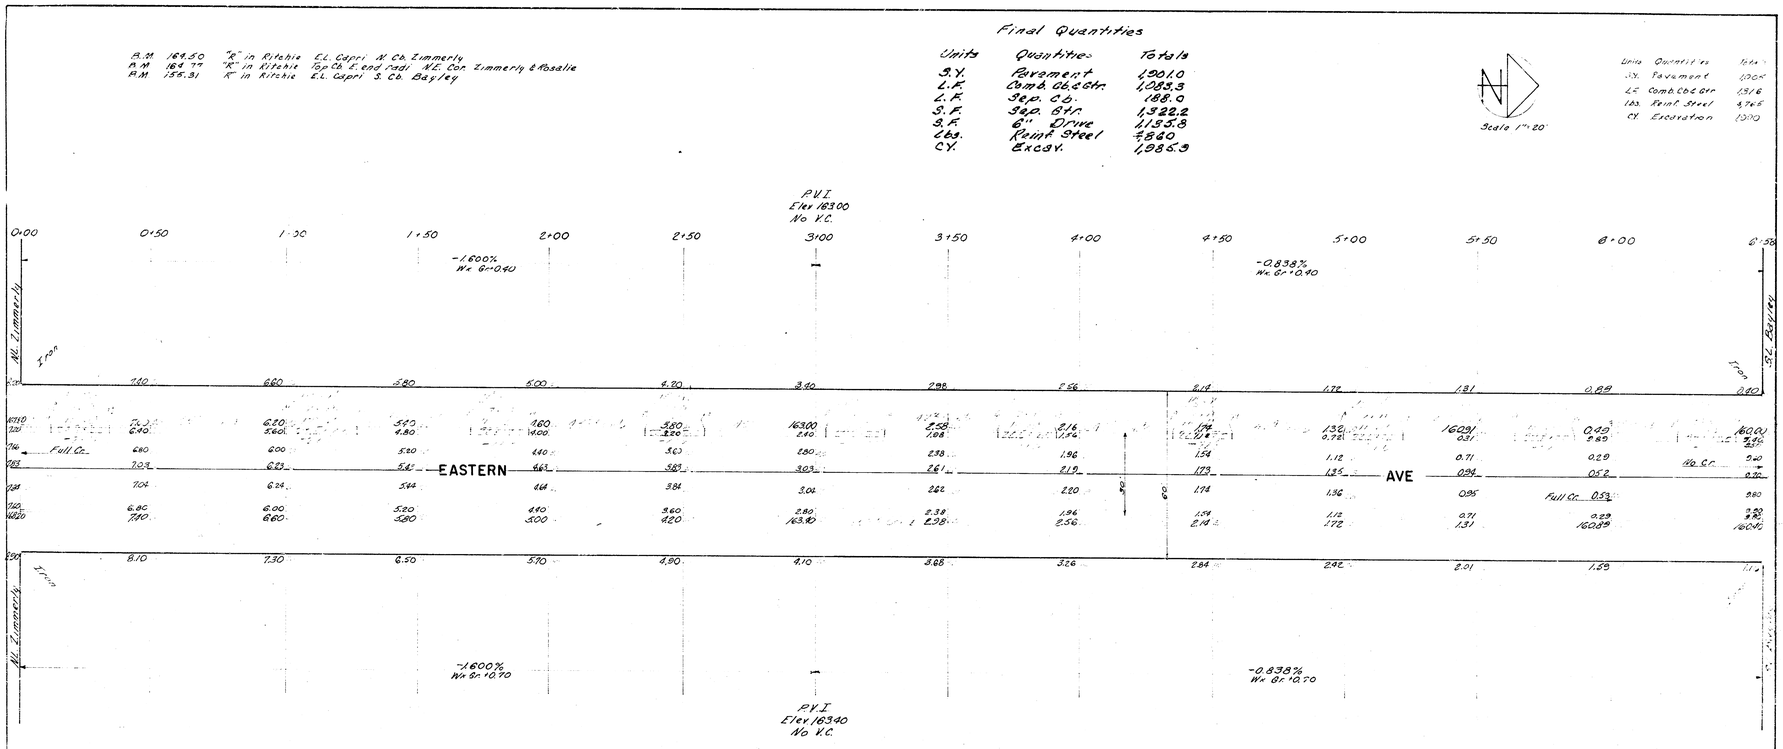

EASTERN	AVE.
N.L. ZIMMERLY	S.L. BAYLEY

26' - 2' - 30' A. C.

CITY OF WICHITA, KANSAS
B.E. SMITH CITY ENGINEER
DATE PRIVATE JOB